

Hostetler-Barrett Survey
Lakeview, Ohio

The following described real estate situated in the Village of Lakeview, Township of Stokes, County of Logan, State of Ohio and being located in Section 27 T. 6 S. R. 8 E. and being a part of Outlot No. 3 to said village and being more particularly described as follows:

Beginning at an iron bar at the southeast corner to Outlot No. 3 and in the west line of Main Street;

Thence with the east line of Outlot No. 3 and the west line of Main Street, N. 29° 52' W. 139.75 feet to an iron bar, southeast corner to Arthur W. Hammonds's present 0.25 Acre tract in Outlot No. 3;

Thence with Hammonds's south line, S. 60° 02' W. 193.30 feet to an iron pipe at Hammonds's southwest corner and the northeast corner to the Board of Education's present 0.91 Acre tract;

Thence with the Board of Education's east line, S. 29° 15' E. 139.76 feet to an Apple Tree (formerly being an iron post, now gone), said Apple Tree being on the south line of Outlot No. 3;


Thence with the south line of Outlot No. 3, N. 60° 02' E. 195.05 feet to the place of beginning, containing 0.623 Acres, more or less.

The above described tract being all the land in the name of Blanche Hostetler et al. Reference being made to Deed Vol. 244 Page 12 for previous description to said parcel.

I hereby certify that this is a true and accurate description of a survey made by me on October 23, 1974.

Daniel E. Gilbert
Daniel E. Gilbert, P.S.
Reg. Sur. No. 5402
1041 N. Main St.
Bellefontaine, Ohio 43311

INDEXED ON MAP
5682 1D

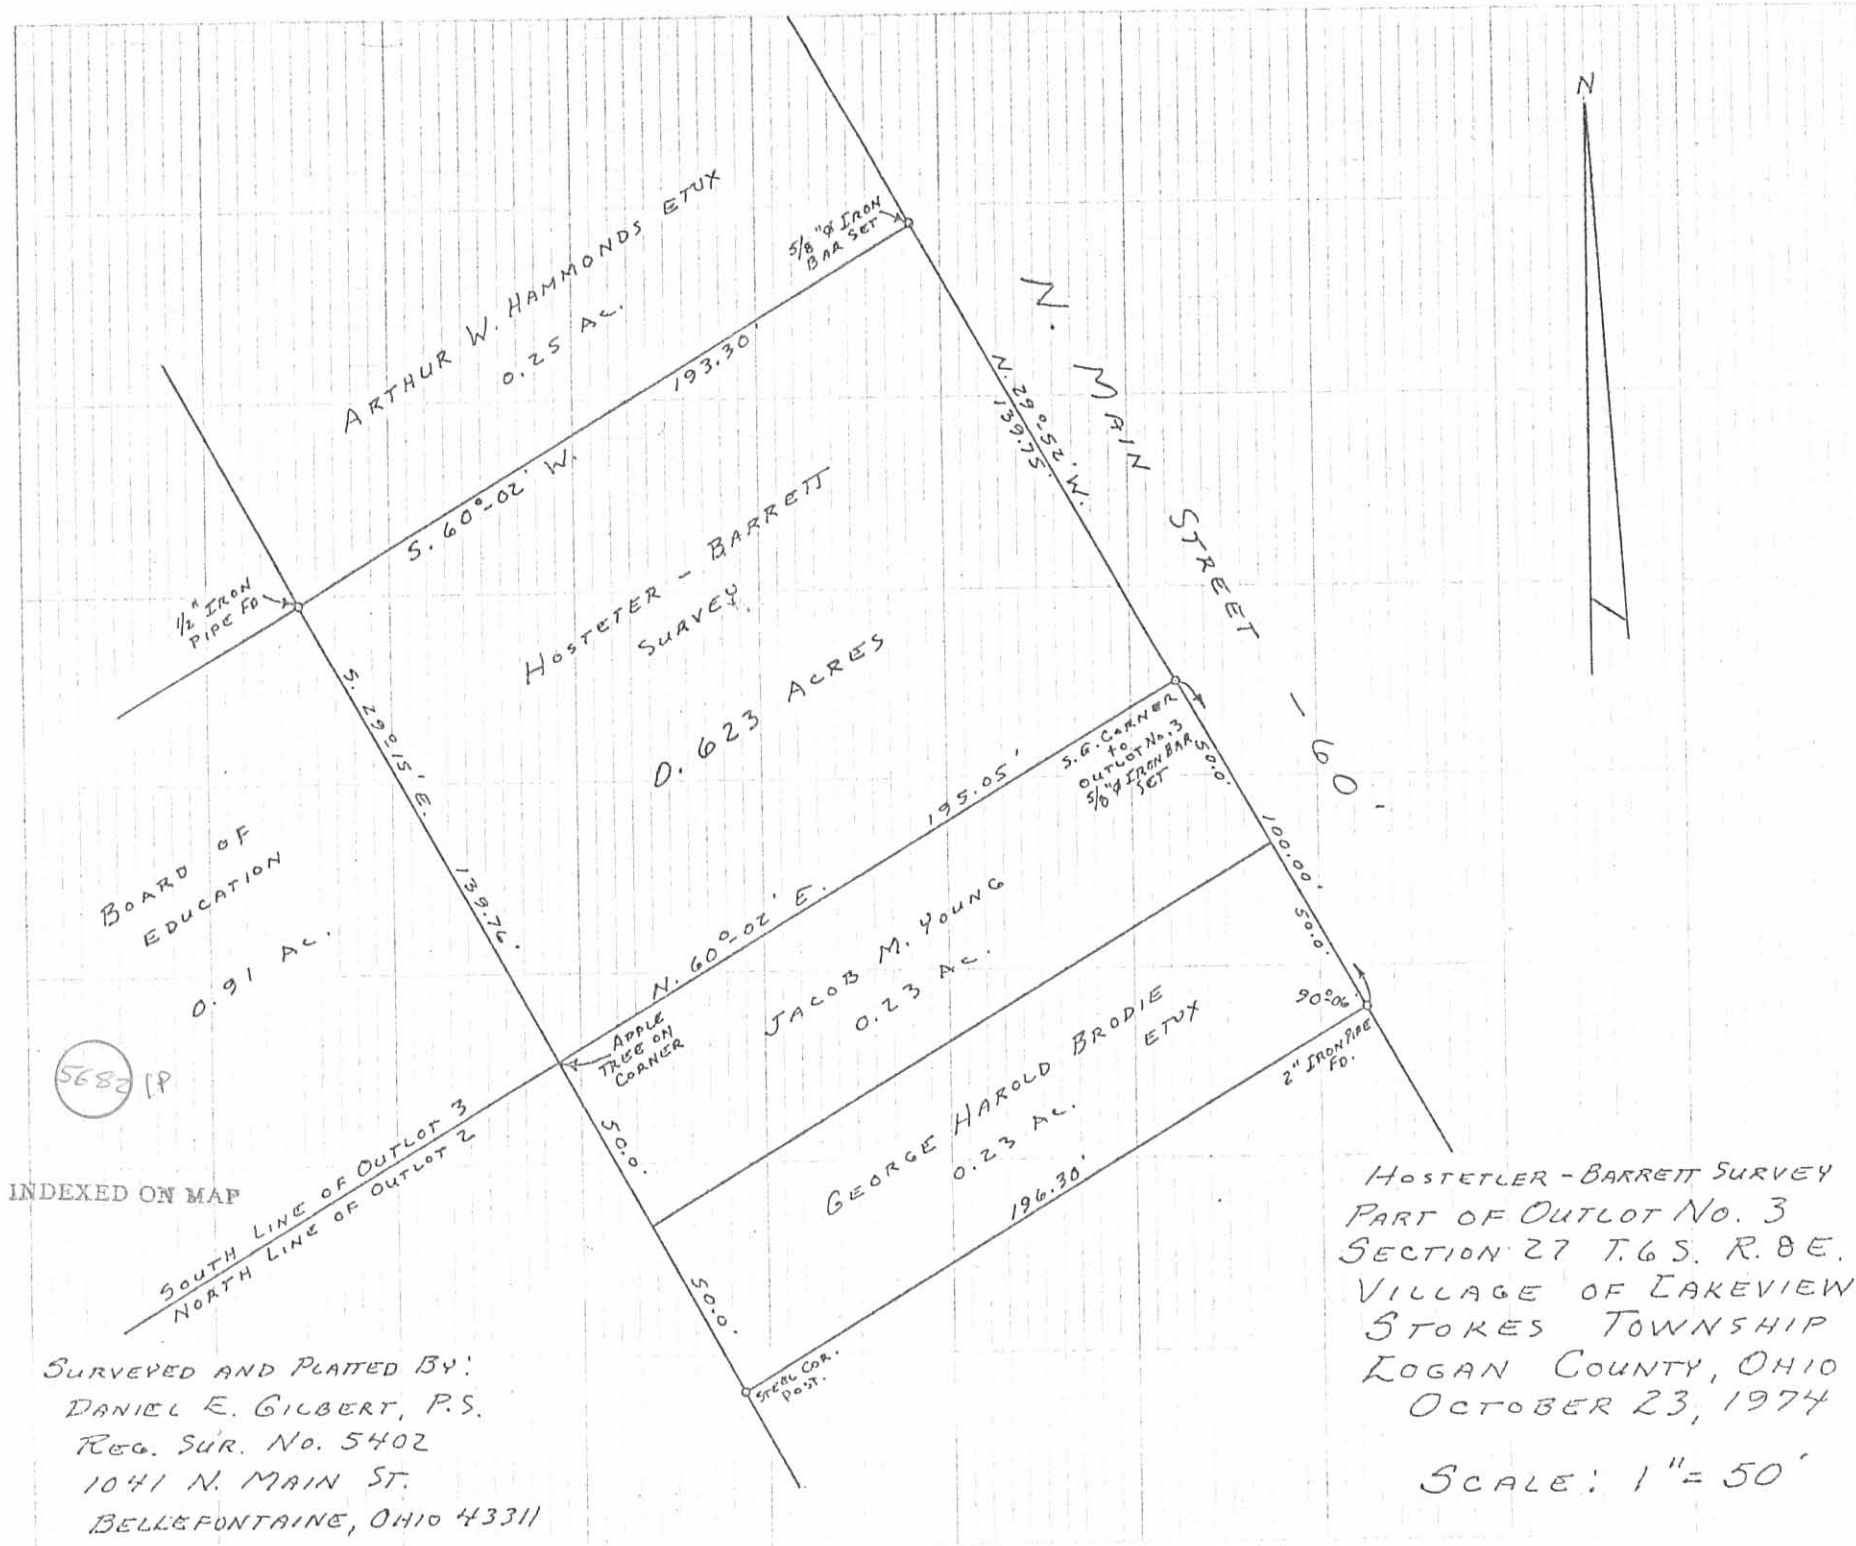

INDEXED ON MAP

5683 (P)

SURVEYED AND PLATTED BY:
 DANIEL E. GILBERT, P.S.
 REG. SUR. NO. 5402
 1041 N. MAIN ST.
 BELLEFONTAINE, OHIO 43311

HOSTETLER - BARRETT SURVEY
 PART OF OUTLOT NO. 3
 SECTION 27 T. 6 S. R. 8 E.
 VILLAGE OF LAKEVIEW
 STOKES TOWNSHIP
 LOGAN COUNTY, OHIO
 OCTOBER 23, 1974

SCALE: 1" = 50'