

LESLIE H. GEESLIN
REGISTERED SURVEYOR NO. 5248
P. O. BOX 274
RUSHSYLVANIA, OHIO 43347

PHONE: (513) 468-2793

June 5, 1975

HAMMONDS SURVEY

The following described real estate situated in Section 27, Town 6 South, Range 8 East, Lakeview, Ohio and being part of Outlot No. 3 and being more particularly described as follows:

Beginning at an iron bar at the northeast corner of Barbara Barrett's 0.63 acre tract in the west line of Main Street that is N. $29^{\circ} 52'$ W. 140.0 feet from an iron bar at the southeast corner of O.L. 3; thence with said Barretts north line S. $59^{\circ} 57'$ W. 193.1 feet to an iron pipe in the southeast corner of the Board of Education's 0.71 acre tract; Thence with the east line of said 0.71 acre tract N. $29^{\circ} 15'$ W. 50.0 feet to an iron bar; thence N. $59^{\circ} 57'$ E. 192.5 feet to an iron bar in the west line of Main Street; thence with said west line S. $29^{\circ} 52'$ E. 50.0 feet to the place of beginning.

Containing 0.22 acre more or less.


I hereby certify that the above is a true and accurate description of a survey made by me .

Leslie H. Geeslin
Reg. Surveyor 5248
Rushsylvania, Ohio



EUGENE DIETZGEN CO.
MADE IN U. S. A.

NO. 375 N.S.
DIETZGEN "NO. 3" PRINT
GRAPH PAPER
5 x 5 PER INCH

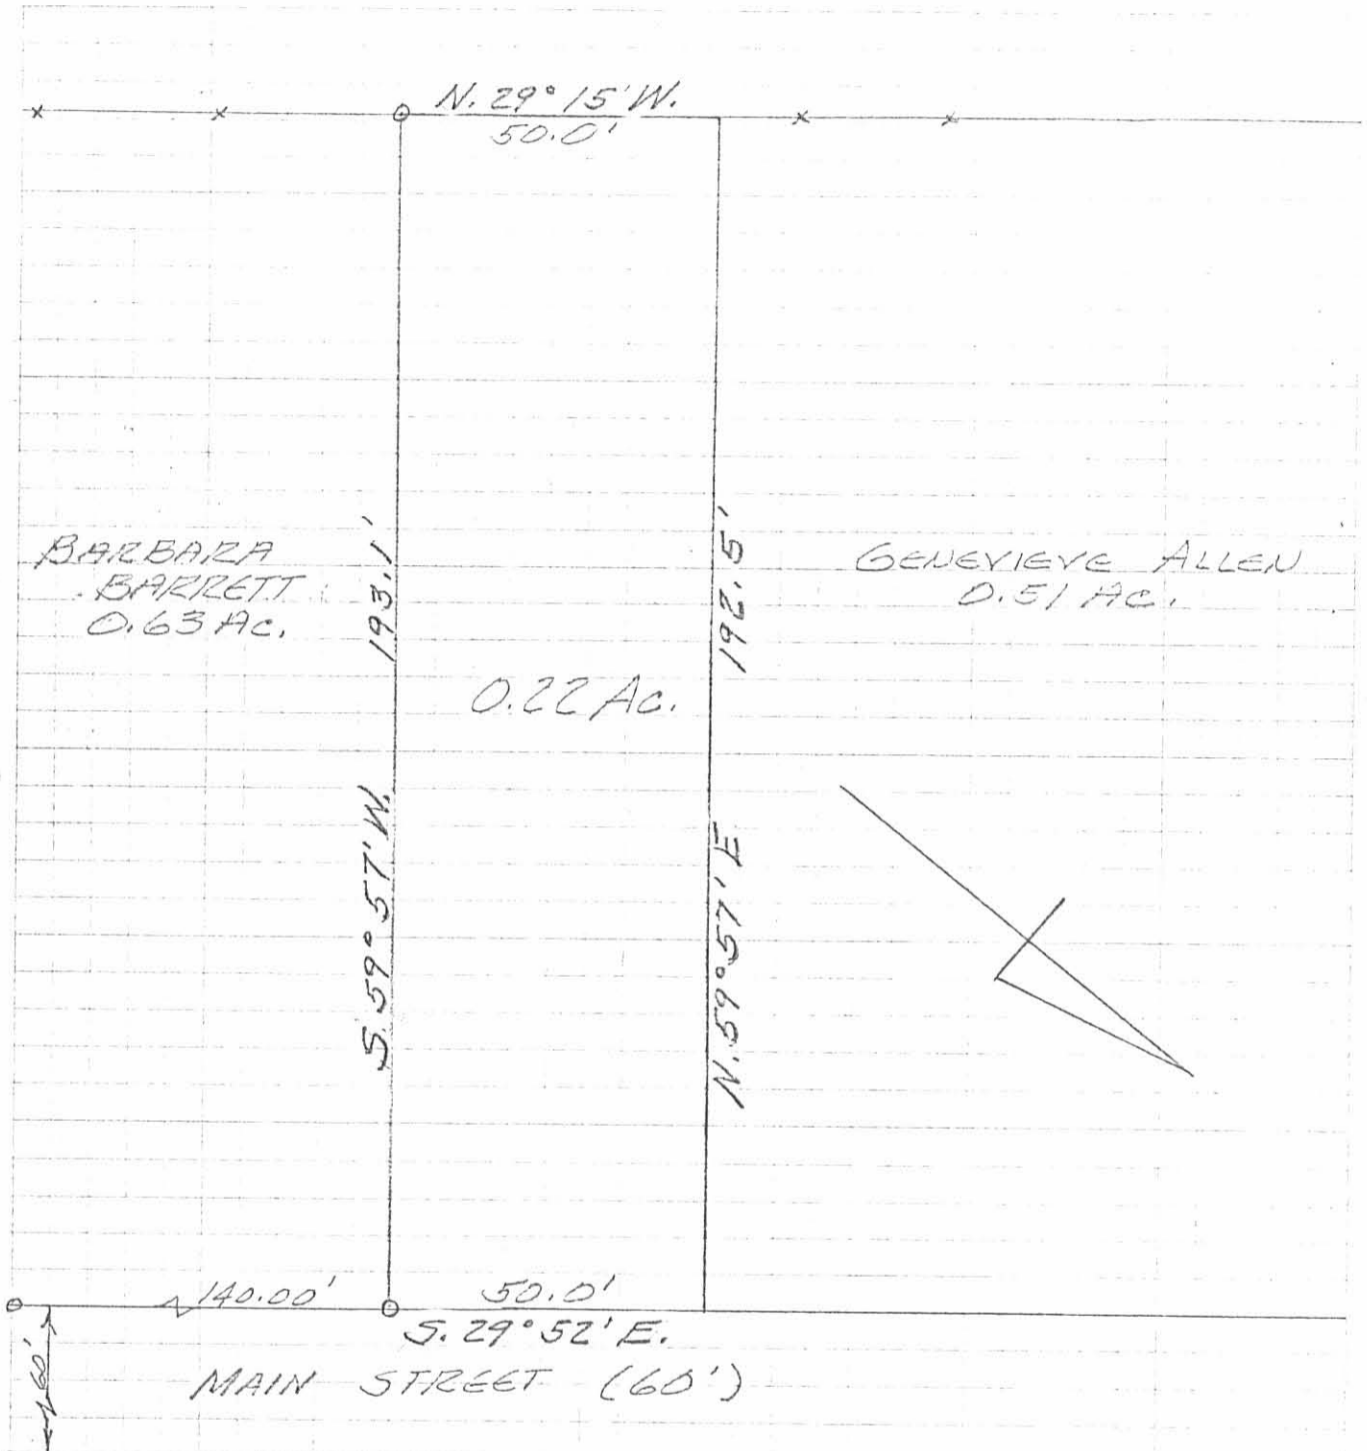

HAMMONDS SURVEY
JUNE, 1975
PART OF OUTLOT 3
S. 27 T. 6 S. R. 8 E.
LAKEVIEW, OHIO
SCALE 1" = 30'

LESLIE H. GRESLIN
REG. SURVEYOR 5248
RUSHSVLVANIA, OHIO

5786 IP

INDEXED ON MAP