


OAK ST. - 50'

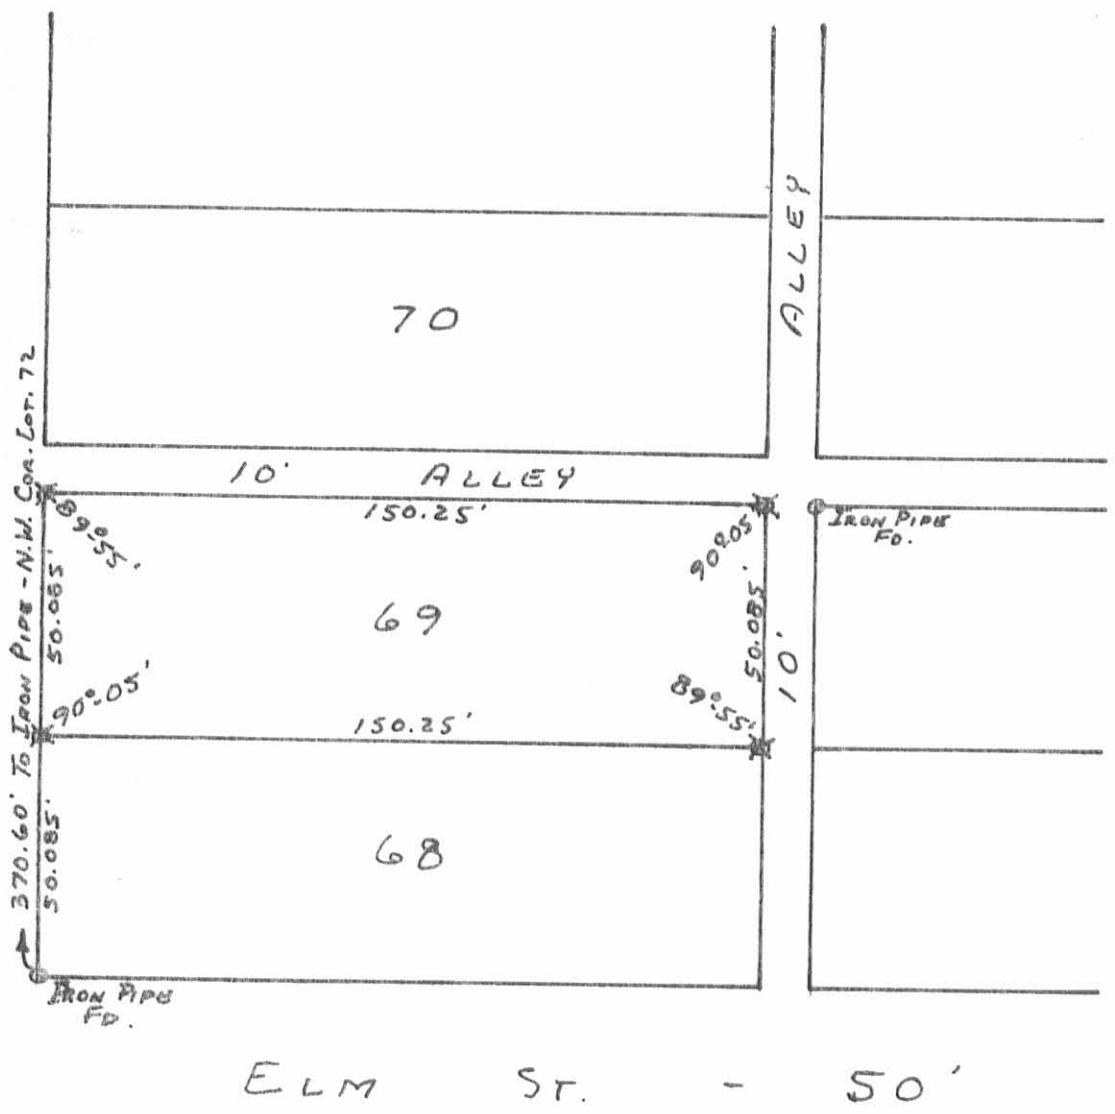

ELM ST. - 50'

⊗ - 5/8" ⌀ IRON BAR SET

64841P

INDEXED ON MAP

HOWER SURVEY
 LOT NO. 69
 VILLAGE OF LAKEVIEW
 STOKES TOWNSHIP
 LOGAN COUNTY, OHIO
 SEPTEMBER 13, 1980

SCALE: 1" = 40'

SURVEYED AND PLATTED BY:
 DANIEL E. GILBERT, P.S.
 REG. SUR. NO. 5402
 1041 N. MAIN ST.
 BELLEFONTAINE, OHIO 43311