

Survey of
Lots 502-503-504
Lackview, Ohio

A = 1 1/2" Pipe Found

B = " " "

C = " " "

D = 5/8" Bar Set

E = " " "

Note A-B-C ok for line

Found 1 1/2" pipe N.W. Cor 498
Frontage from C checks ok


From A to R/W Point on lot 508
(see F.B. 700 pg. 26) Checks as
shown in F.B. 700 pg. 26

INDEXED ON MAP
96 29

Doddson
Nichols

6/12/79

60

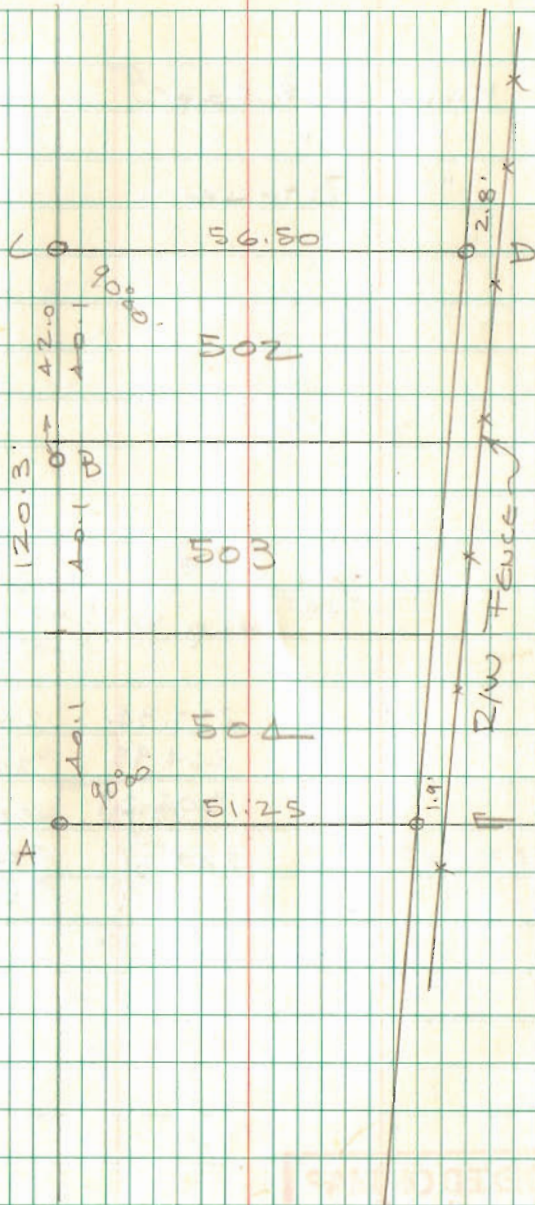

INDEXED ON MAP
96 29