


210
INDEXED ON MAP

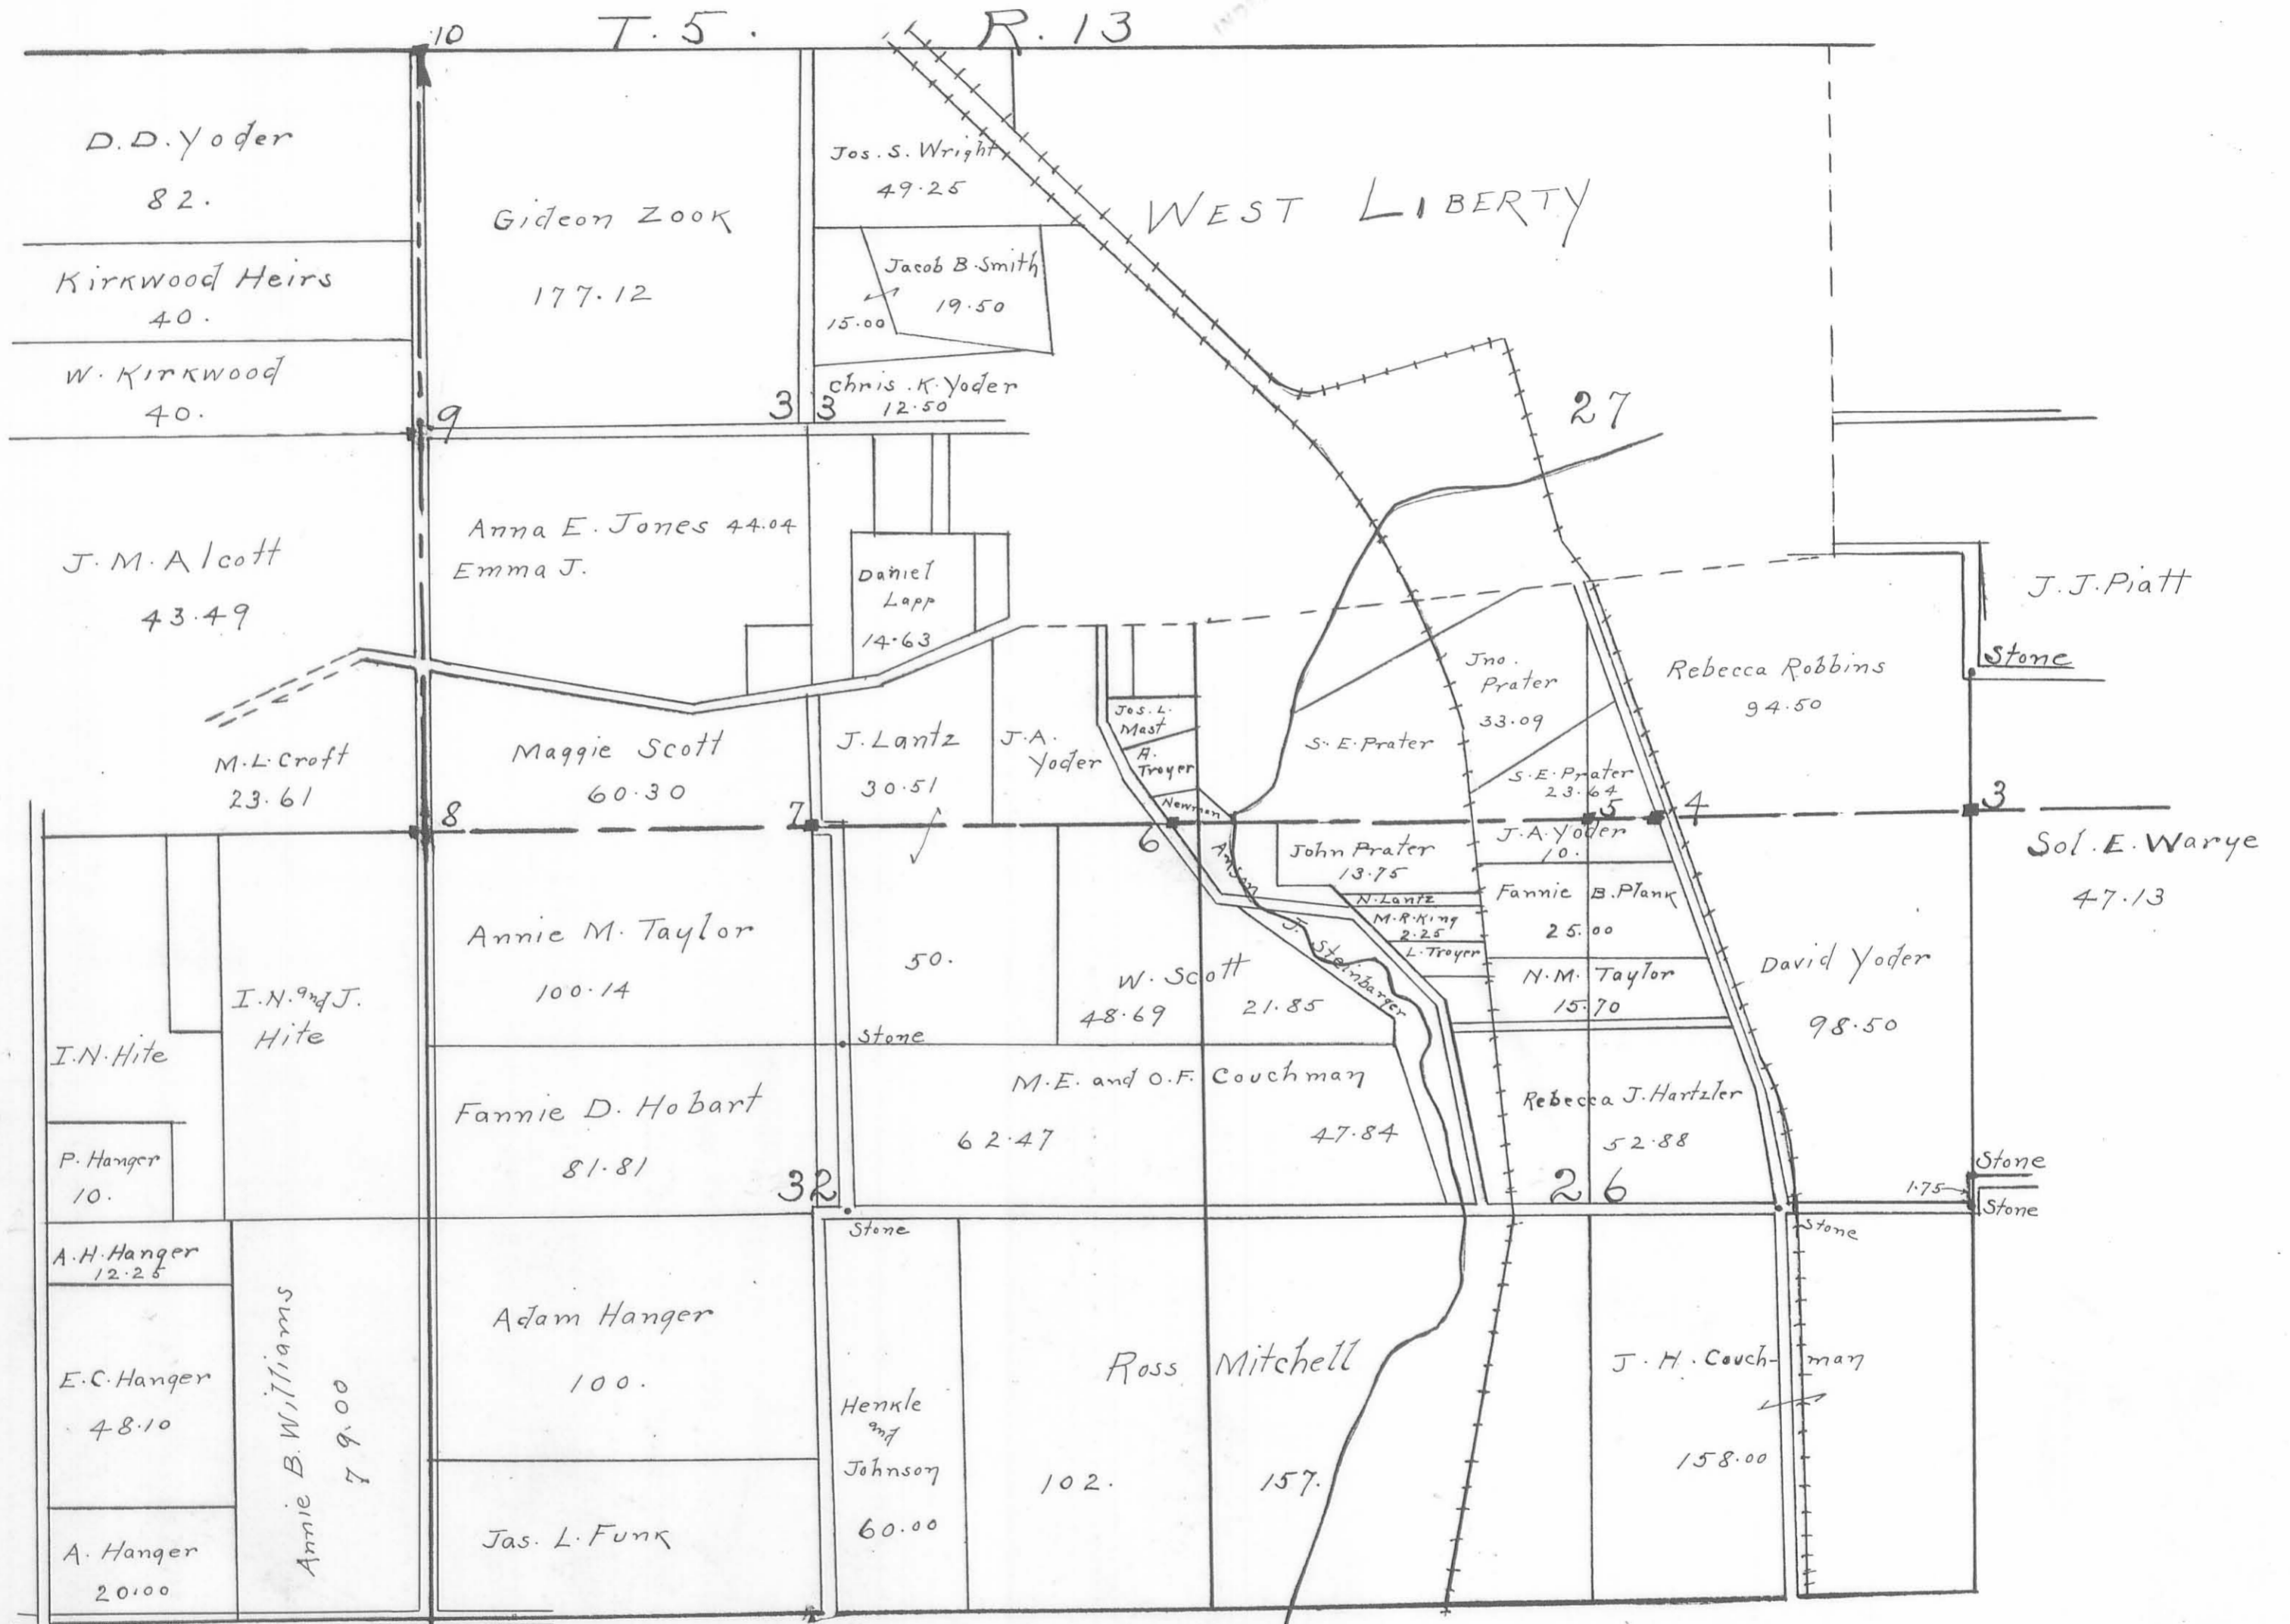

MONUMENTS:

- No. 3 — Stone — On line and Section Corner.
- No. 4 — Stone — On line at West side of pike.
- No. 5 — Stone — On line and Qr. Sec. Corner.
- No. 6 — Stone — On line 210 feet West of Section Corner.
- No. 7 — Stone — On line and Qr. Sec. Corner.