


147 1P

INDEXED ON MAP

LIBERTY AND MONTROE TWP

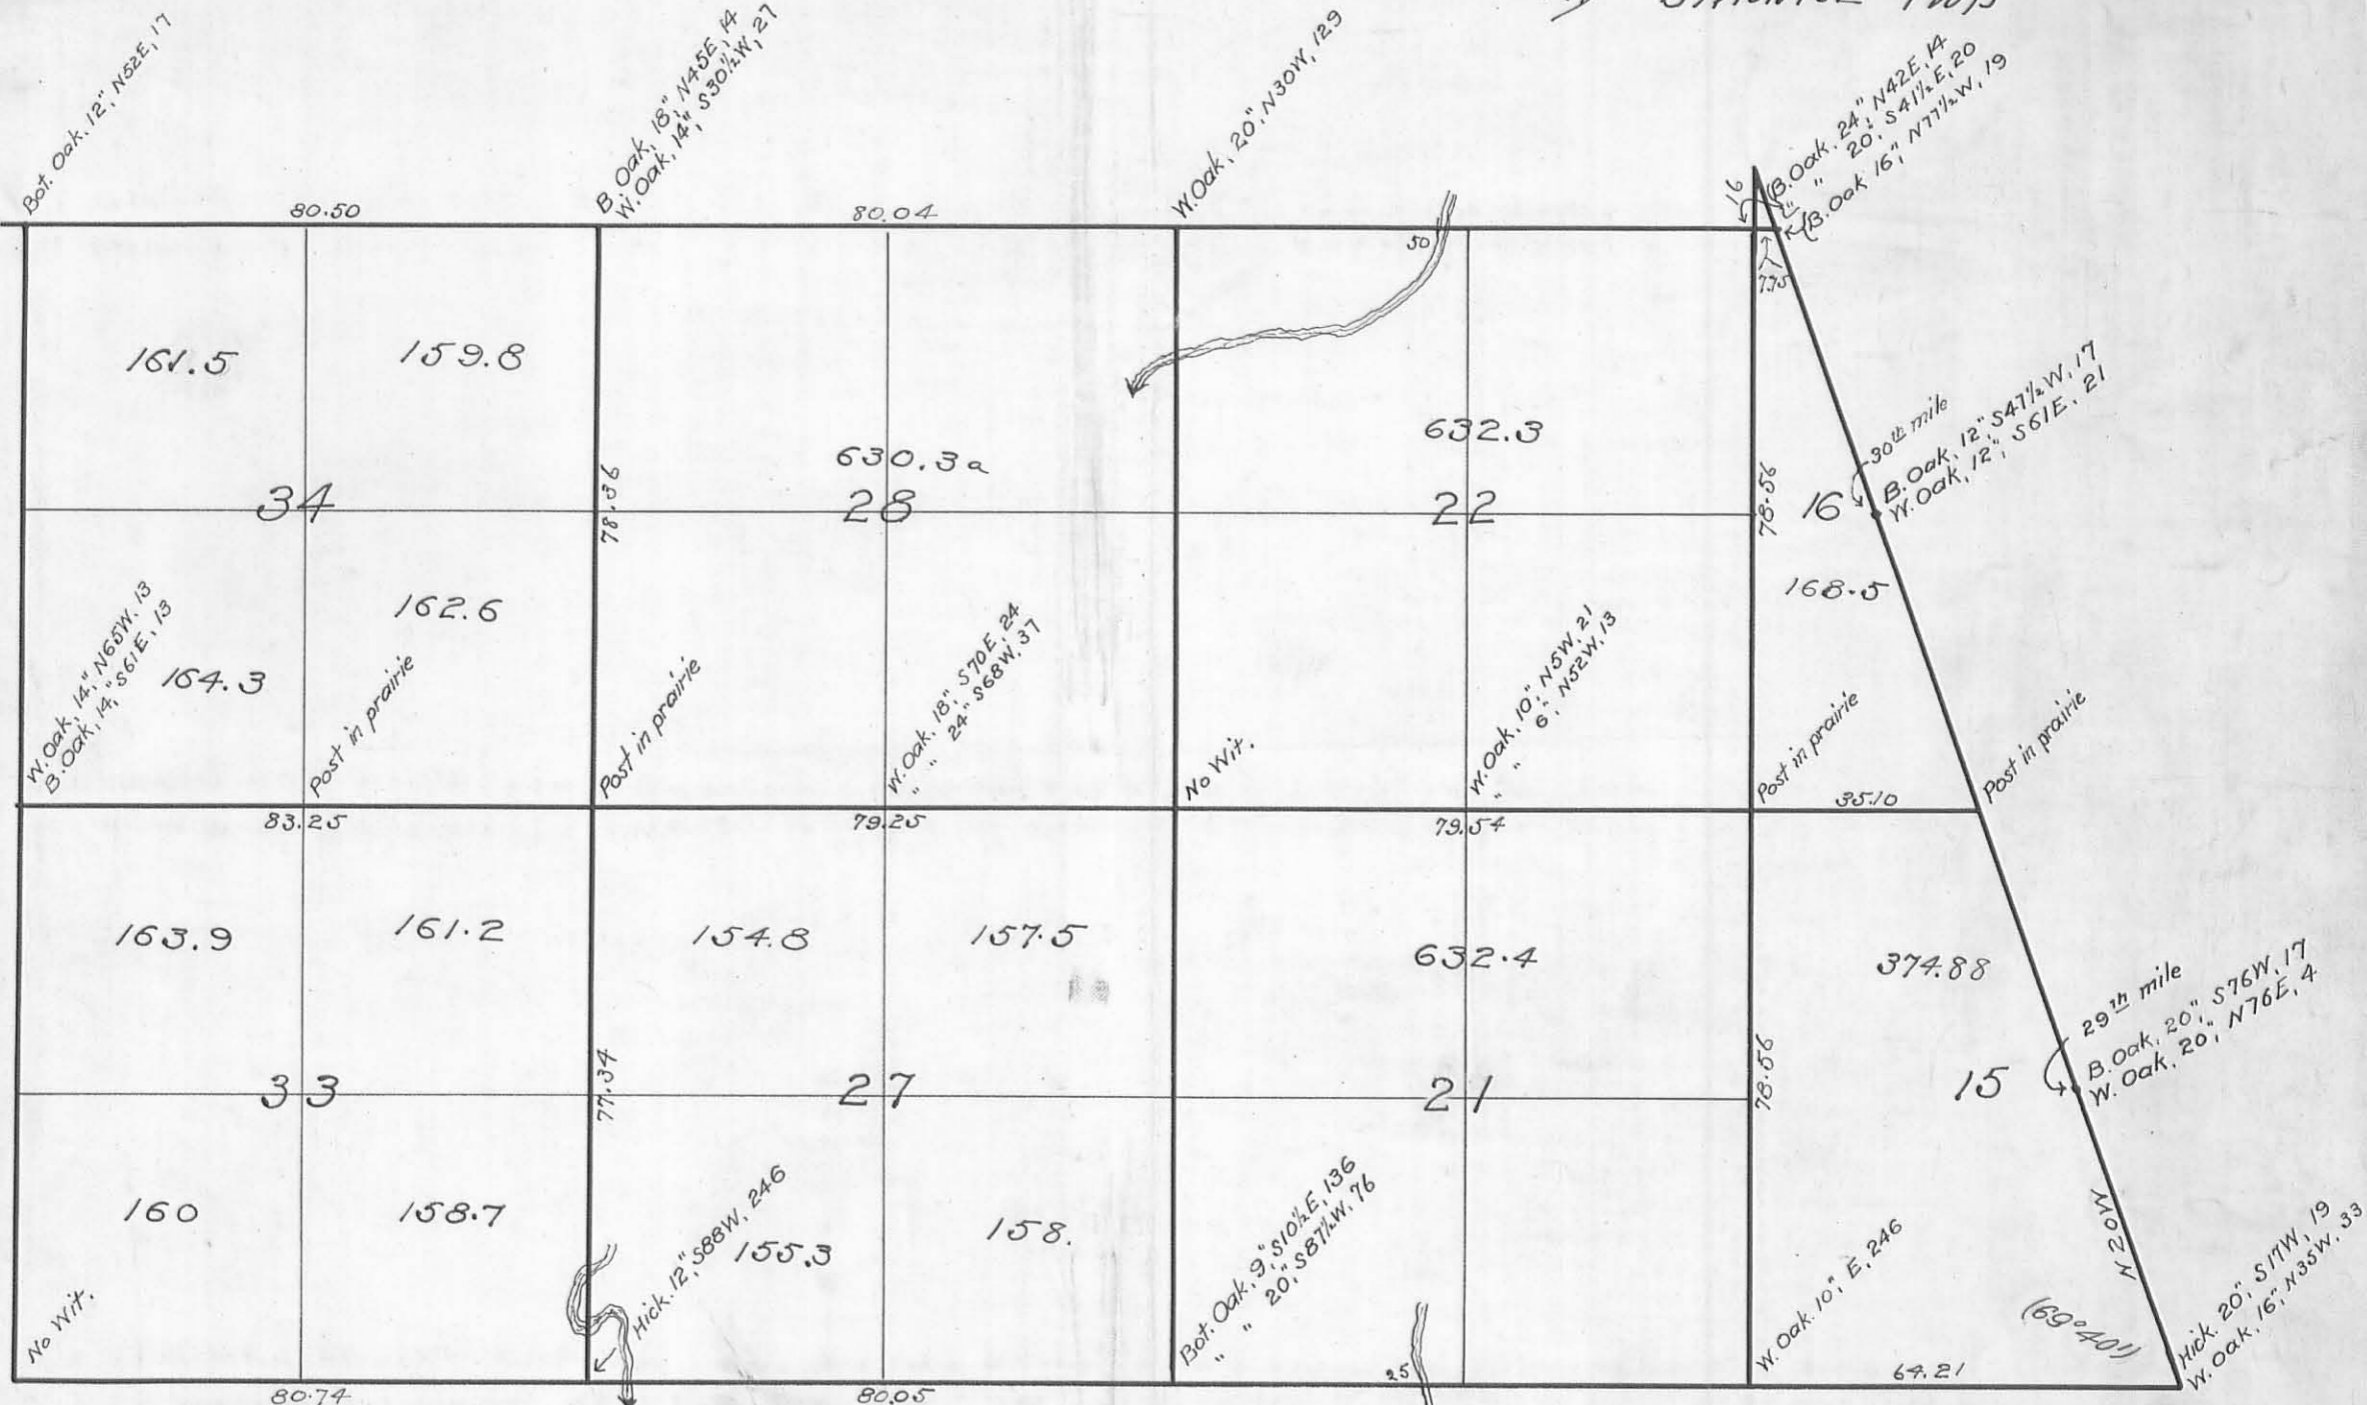

T. 5. R. 13.