

Road #190 ✓ 36
Liberty Twp.


Monroe
Township Line
Liberty. 62+79 TA.

? X A.D. Young 60+24
W^m Cooper

53+97 Hedy

37+50 45+53

1037
INDEXED ON MAP

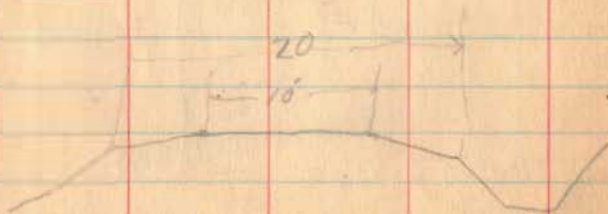

W^m Cooper 25+37
Jacob Shultz


Jacob Shultz 3+28

W^m Cooper
Carter + Dille

Carter + Dille
To
W. Liberty

To
Bethlehem
S.H. 189
Route 53

Road # 190 see Plat Draw R.

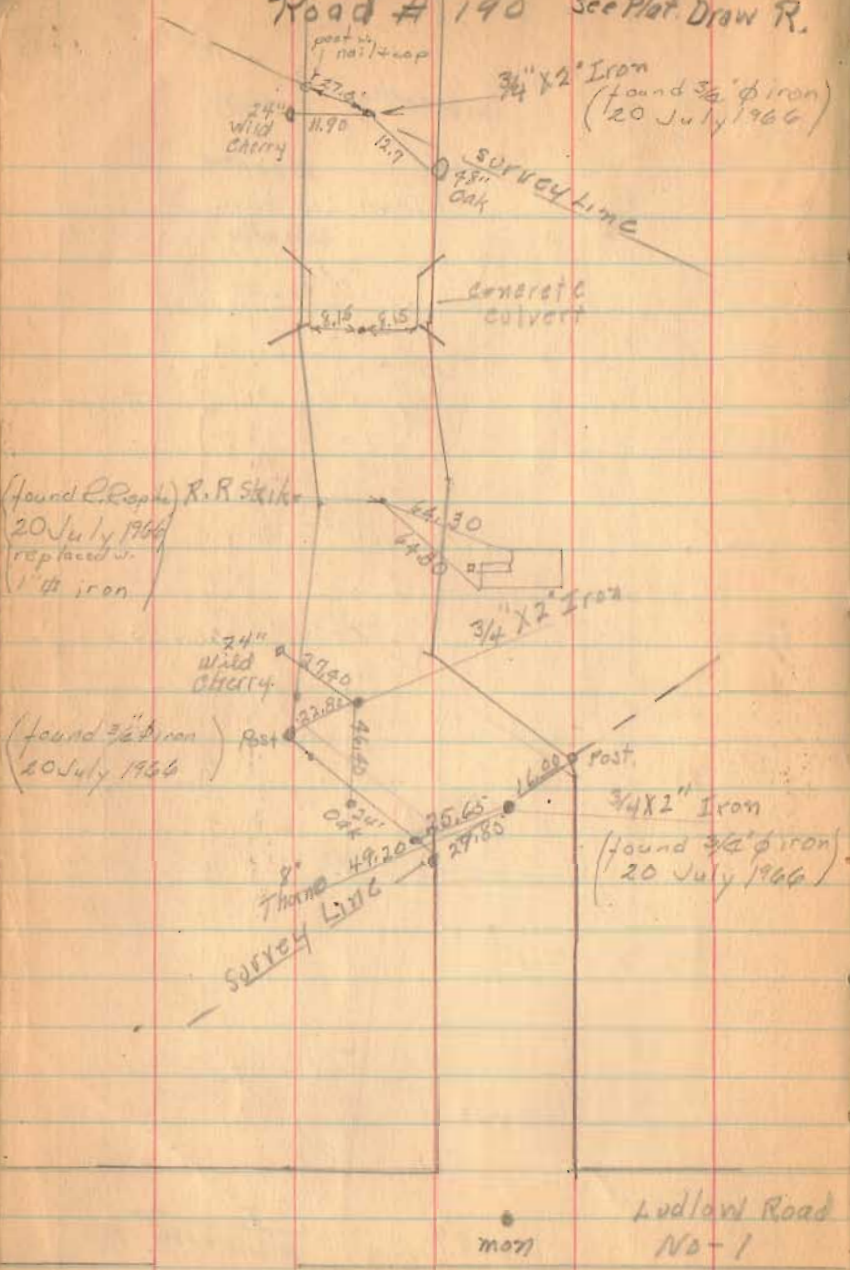

Road 190 4-12-46

Wilgus
Wright

37

Irons set for Leib Farm survey

4-7-39

Witkus
James
Phillips
Lee,
Dobie,
James
Tennant

6+00

Road 190
Stakes Set Every
200 ft. 20' R. 20' L

Mont.
set,

5+00

(1337)
Index on Map.

4+00

3+00

2+00


1+00

Mont.
Set.

0,0


sec. cor. stone

Mont set 0-5-10 and checked.
O.K.

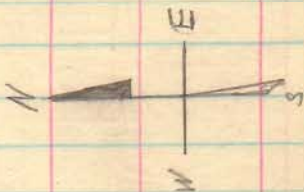

Sec 25-4-14

Sec 30-5-13

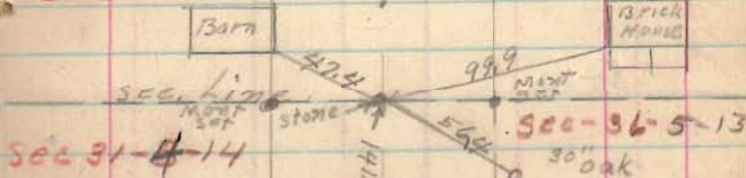

Sec 31-4-14

N
To Bellefontaine
I.C.H. 189
Route 68

Road 190

12+00

11+00

10+00

9+00 +25

8+00

7+00

← 12 → 19.5 →

Moxl
setMoxl
set

J. Shultz

~~X X X X~~
J. Shultz

← 12 → 20.5 →

← 11.5 → 21.5 →

Road 190

18+00

17+00

+96

16+00

+06

15+00

14+00

13+00

← 13 * 18 →

* * *

Mozit
setMozit
set

* * * *

← 11.6 * 19 →

← 11.7 * 18.5 →

Road 190
+24.8

24+00

23+00

22+00

21+00

20+00

19+00

Iron 0.7 N. of
Sec. Line

W²⁰ Cooper

J. Shultz

steel

COR Post

11.20

Next
set

←12.5 → 16.8 →

Next
set

←12 → 17.4 →

←13 → 17.3 →

Road - 190

30+00

29+00

28+00

27+00


+69

26+00

25+00

Mant. Set, ← 11. * 17 → M.D. Set

1/4 Cor.

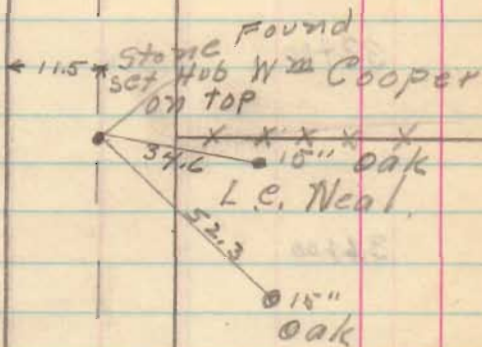

← 11.5 * 17.7

+55

36+00

35+00

34+00

33+00

32+00

31+00

Found OK.
7/26/69
D.E.G.R/W Const.
Mont
Set91225'
1822-49Mont
Sta.
Set
37+00Mont
Set Left
only

65.8

94.00

12" Sugar tree

12" Sugar
tree

Sec Line

← 11. * 15 →

← 11. * 16.5 →

49+00

48+00

+56.2 Iron

47+00

46+00

45+00

NO FENCE

20.2

20.2

APPLE
TREEAPPLE
TREE

46.5

36

0.6 South of

MONT
SET

Dio Not. File

MONT
SETMONT
SETFound O.K.
7/20/69
D.E.G.982.15
1762.36Conec. R/W
set
44+66MONT
SET

20.1

MONT
SET

Found MOD.

Cement
PAST

55400

54400

53400

+55.4

Iron

52400

51400

50400

← 13. →

MONT
SETMONT
SETAPPLE
TREE

STONE SET
ON BRICK
STONE GONE
BUT BRICK
WAS THERE
SET IRON IN
PLACE

216

MONT
SETMONT
SET

Surv 15-4-14 19-4-14

12" Oak
 Walnut Tree
 Set steel
 2x2 R/W
 Post
 992.58'
 1792.57'

61+00

Surv. 30-5-13

40+00

24-5-13


Stone
 Found on
 Young W. T.

59+00

58+00

57+00


56+00

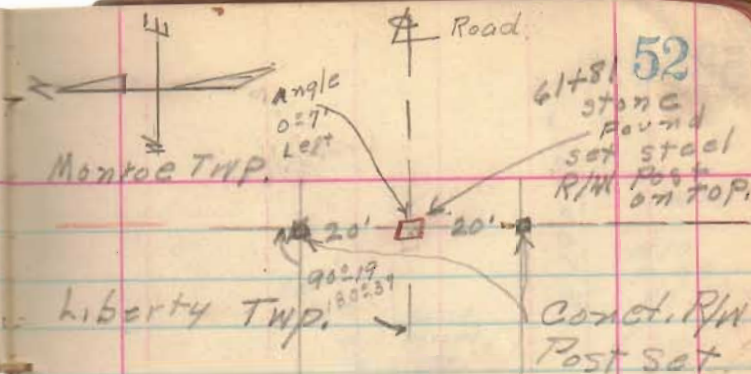

61+81
 Stone
 Found
 set steel
 R/W
 Post
 on top.

Concl. R/W
 Post Set.

Max?
SetMin?
Set

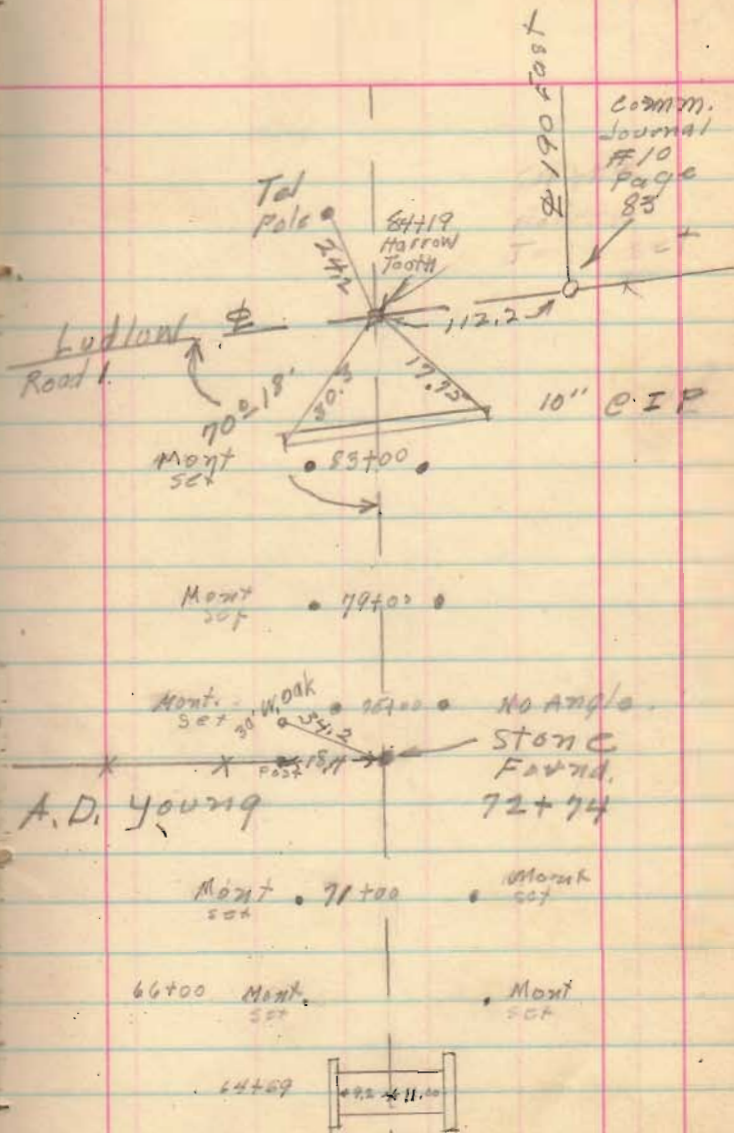

Wilgus
Jones

