

Road 188
 Liberty Twp.

Section $\left. \begin{matrix} 34 \\ 35 \\ 36 \end{matrix} \right\}$ Town 5 Range 13 Btwg Miami Rivers Survey

No record found.
 started for 30' Road.


1-3-5-7 etc.

1572

INDEXED ON MAP

April - 24 - 1939
 coal - Yes
 W. 40 ft
 R.W. 0.02
 George Henry
 Tolson


60

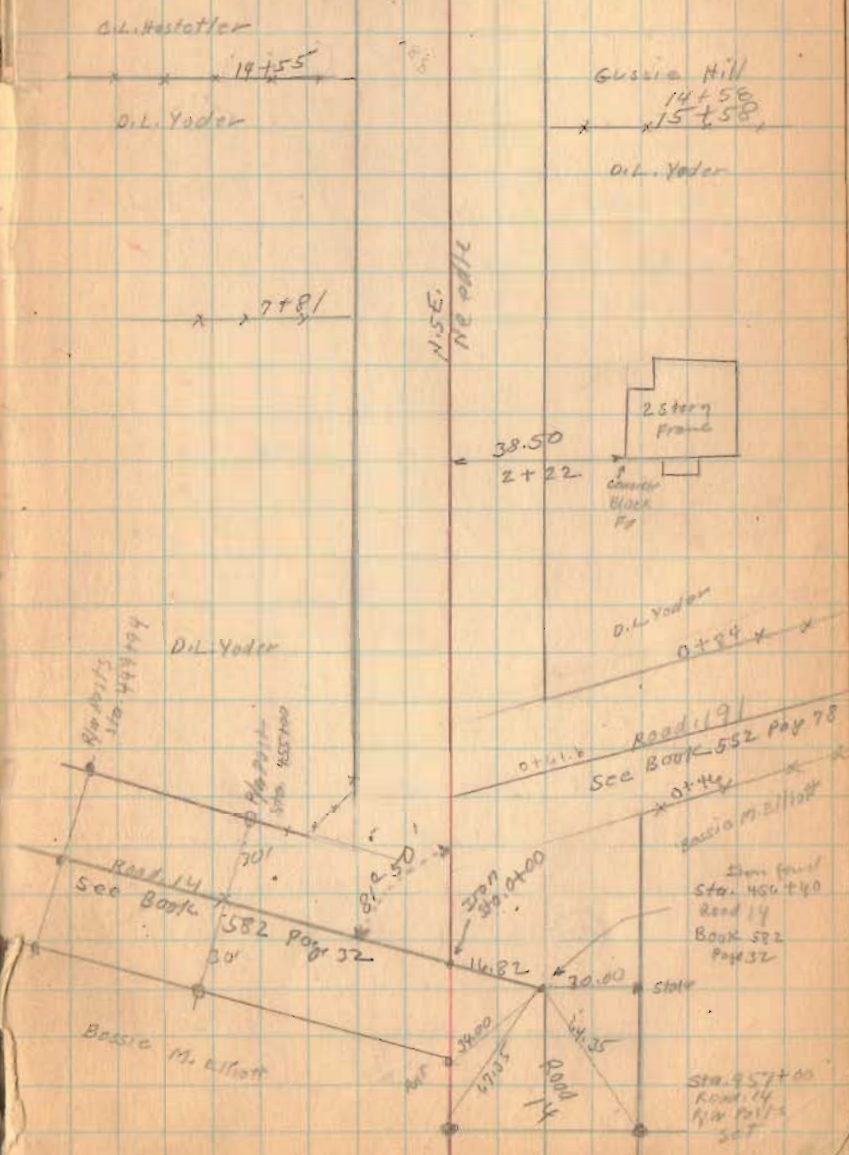

Road 188

1572

INDEXED ON MAP

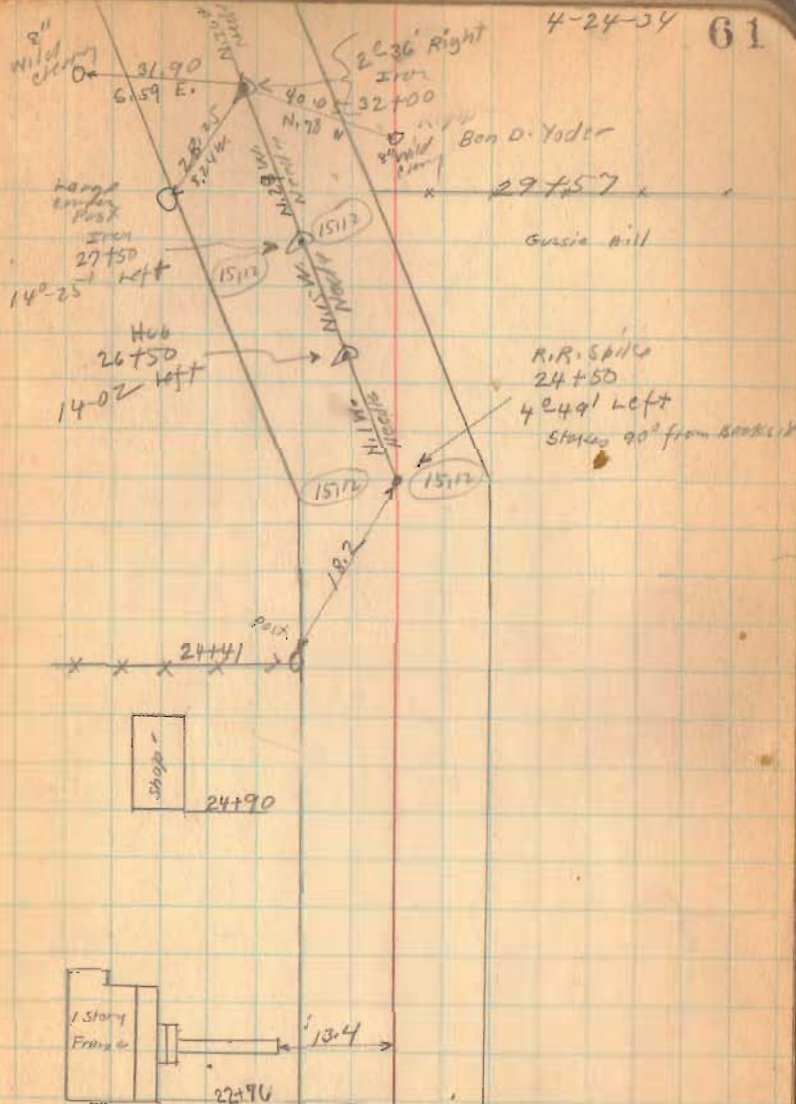

Road 188


1572

INDEXED ON MAP

April-27-1934


Cool - Yes.
F. Wright
E. Core
G. Henry

62

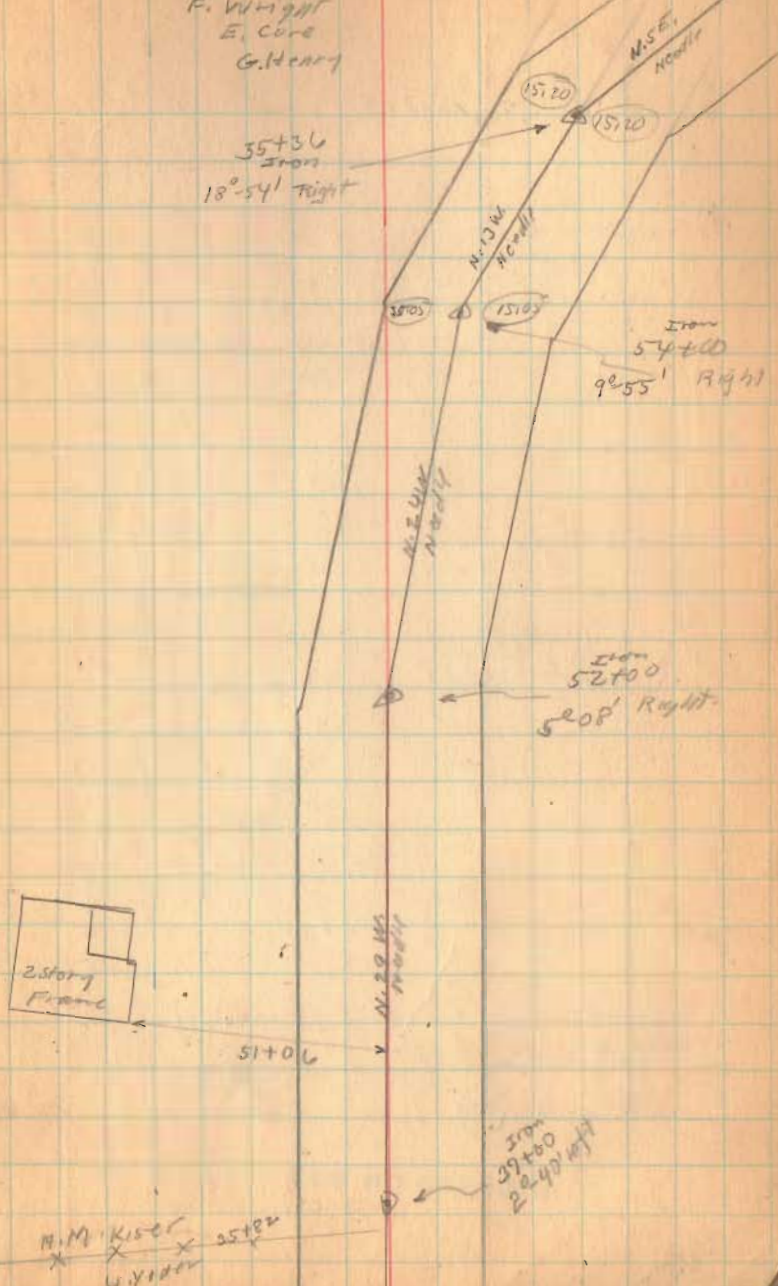

Road 188

Road No. 30

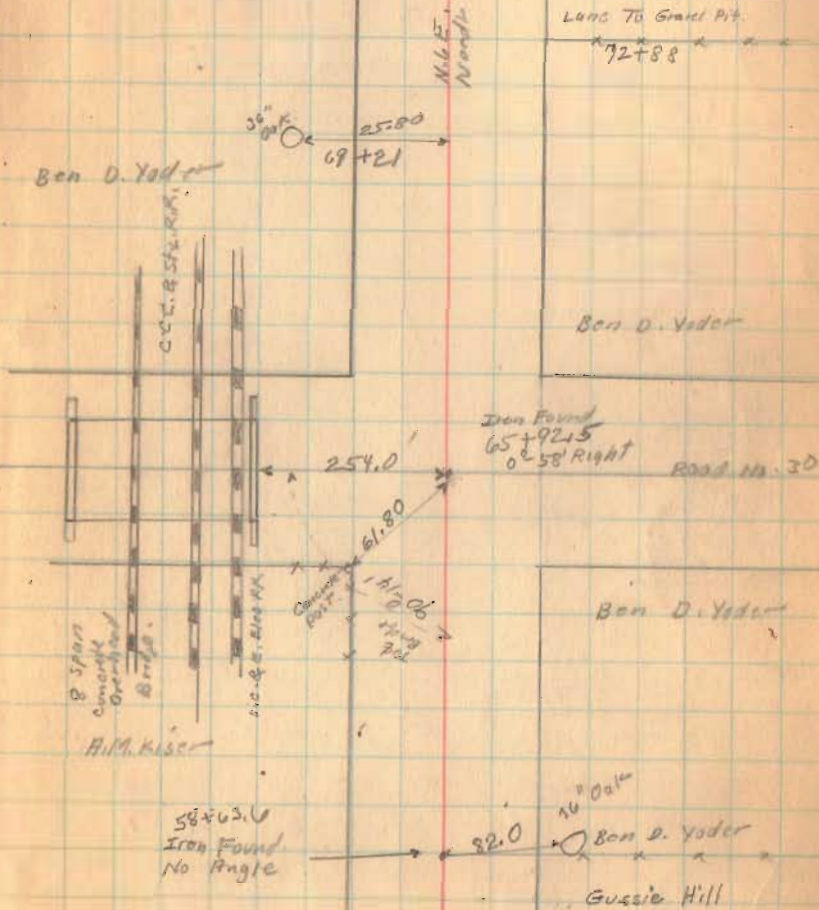

(1572)

INDEXED ON MAP

Road 188

53.13
2.35
50.78

907.14

34.70
2.35
32.35

1570

INDEXED ON MAP

4-27-74 64

Iron found
106+63.3
3°-22' left.

37.5
38.7
15
17
18.5

103+88
Iron found
0°-15' left

Iron
98+00
6°-35'


37.05
To E. Train
18.45

C.A. Sharp

Anna H. Hooley

PHC 3-10-51
96+51.5
12°-50' Right

96+14

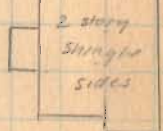

Bellefontaine Country Club

Road No.

To E. CIRC.
53.60

Anna H. Hooley

R.L. Smith
Kenneth Harr

S.T. Hartzler

Stone found
92+72
No. Angle


92+72

2927

INDEXED ON MAP:

82+49.5
Stone found
3/10/51
0°-27' left

Iron placed
3/10/51

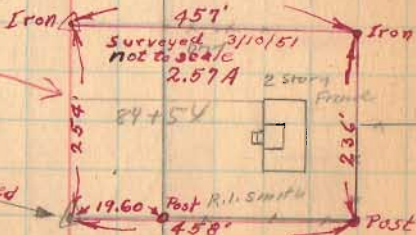

Ben D. Yoder

No. Found
2


Stone found
80+56
0°-35' left

Road 188

43.70
2.13
45.83

(1572)
INDEXED ON MAP

N

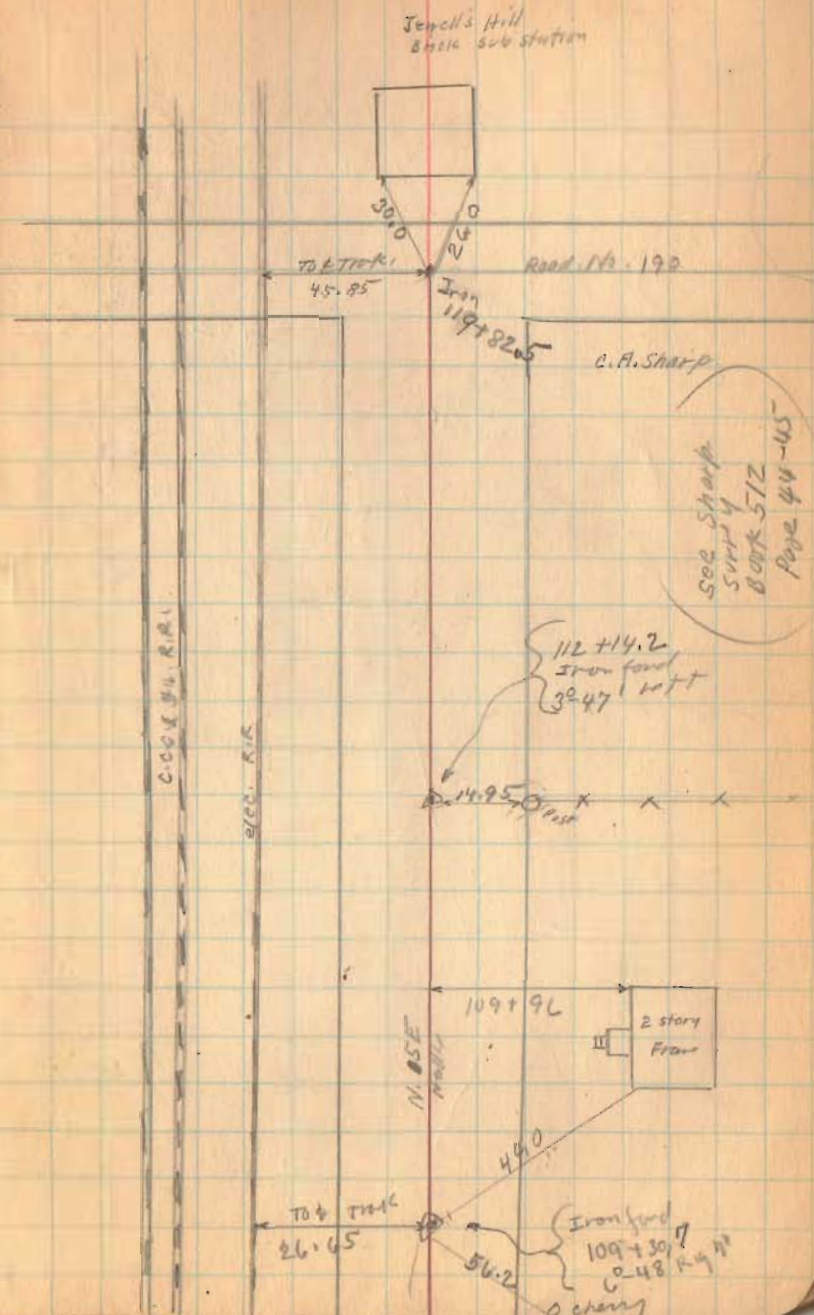

Jewell's Hill shale sub station

To 4 track 45.85

Road 188

Iron 119+82.5

C.A. Sharp

see Sharp Survey Book 512 Page 44-45

112+14.2 Iron found 32.47

149.50 post

C.O.C. & N. R.R.

C.O.C. R.R.

N. OSE Hall

109+96

2 story Frame

44.0

To 4 track 26.65

Iron found 109+30.7 0-48 R. G. W. 0 cherry

56.2