

Road 192  
 Liberty Township  
 sec. 33 and 34 T15 R.13

40' Road. sta. 0+30 to 9+74


Commissioner Journal No. 10 Page 185  
 1854

Stakes placed 20' from E.  
 for a 40' Road

For Monuments set Dec. 1925

7+00  
 3+00  
 1+00


1698  
 INDEXED ON MAP

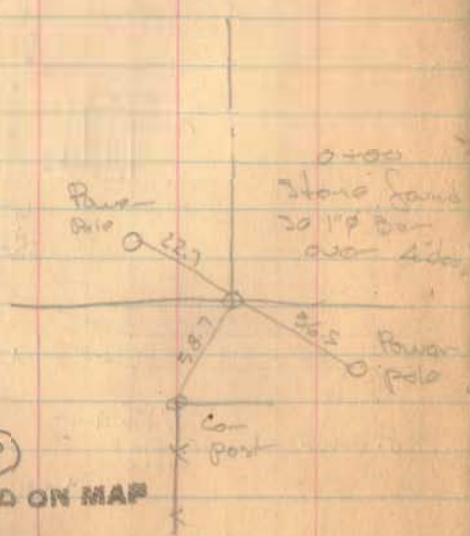

Dec. 7, 1925  
 F. Wright  
 E. Coth.  
 G. Wilper  
 not very cold.



N 40° 51' E

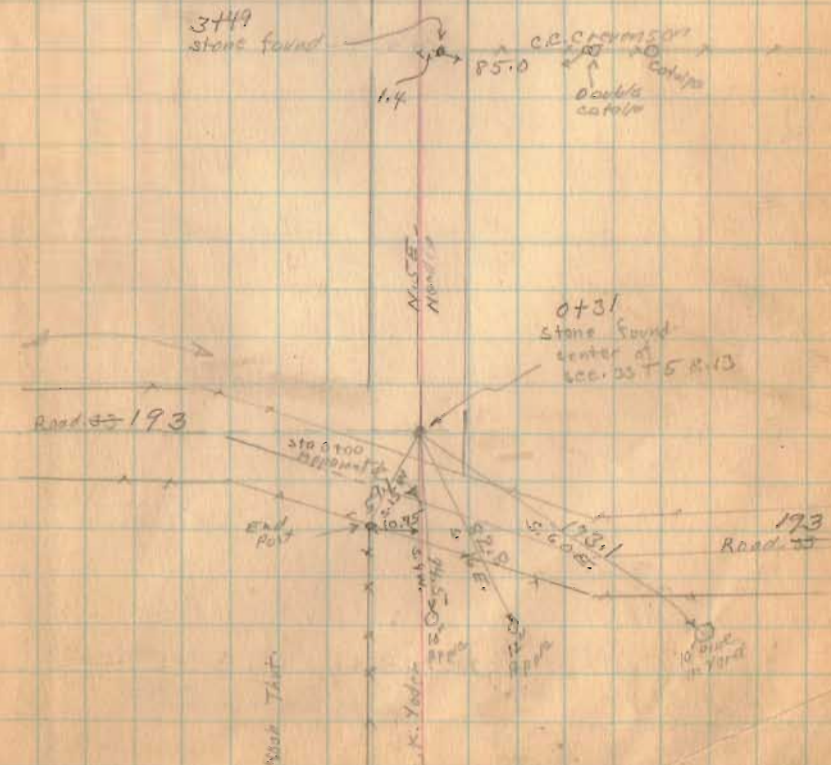


Road 192

13+00

12-9-35

30

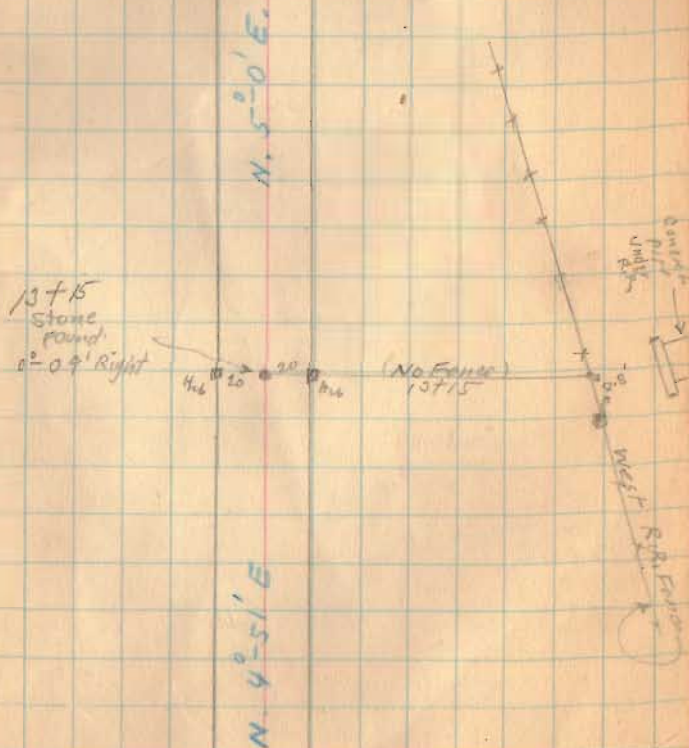

1698

INDEXED ON MAP



Road 192

21+00

East only


17+00

1698

INDEXED ON MAP

12-9-33

31

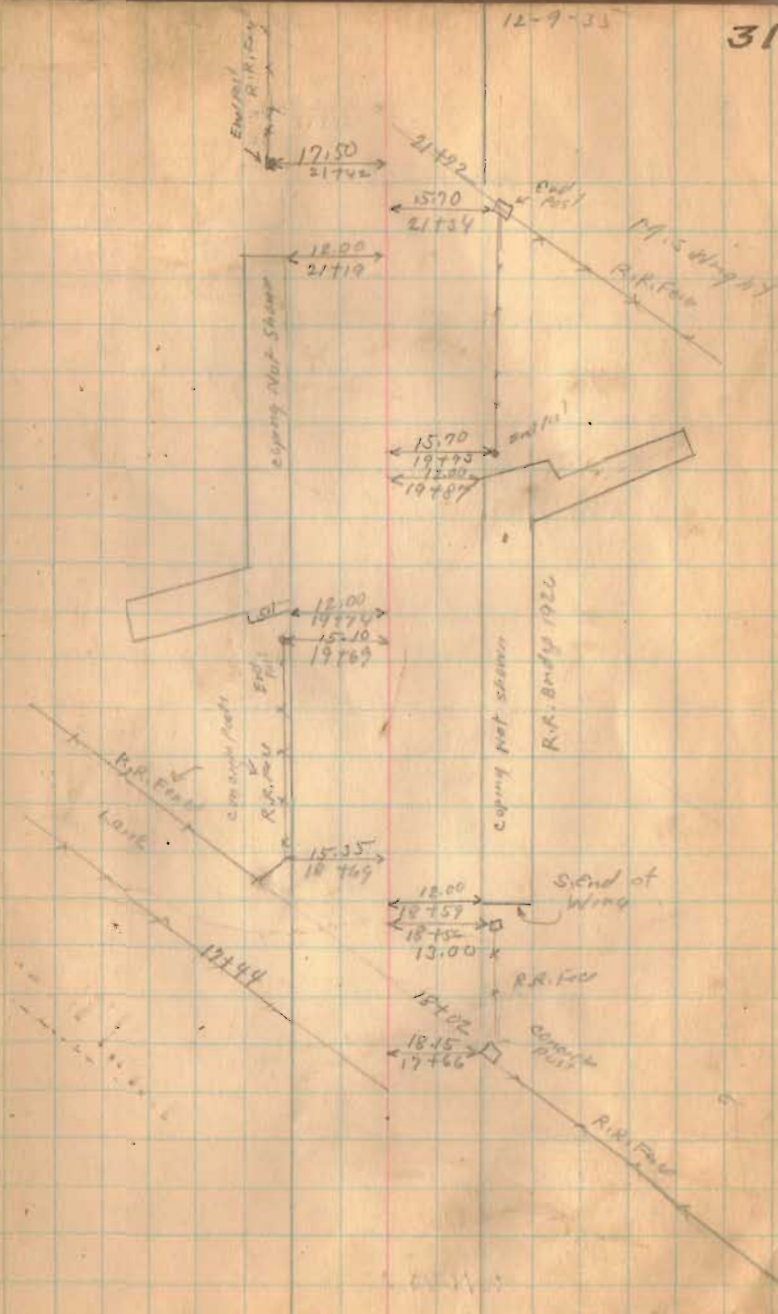

Road 192

27+00

1698


INDEXED ON MAP

12-9-31

32


Section 34

T. 5 R. 13

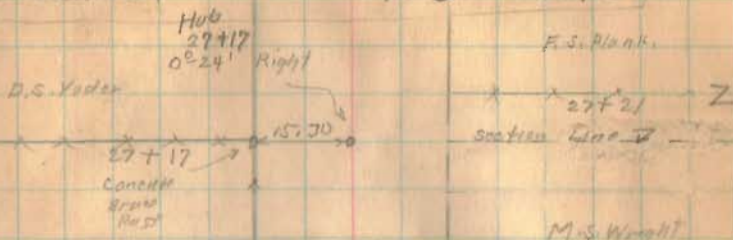

Section 32

T. 5 R. 13

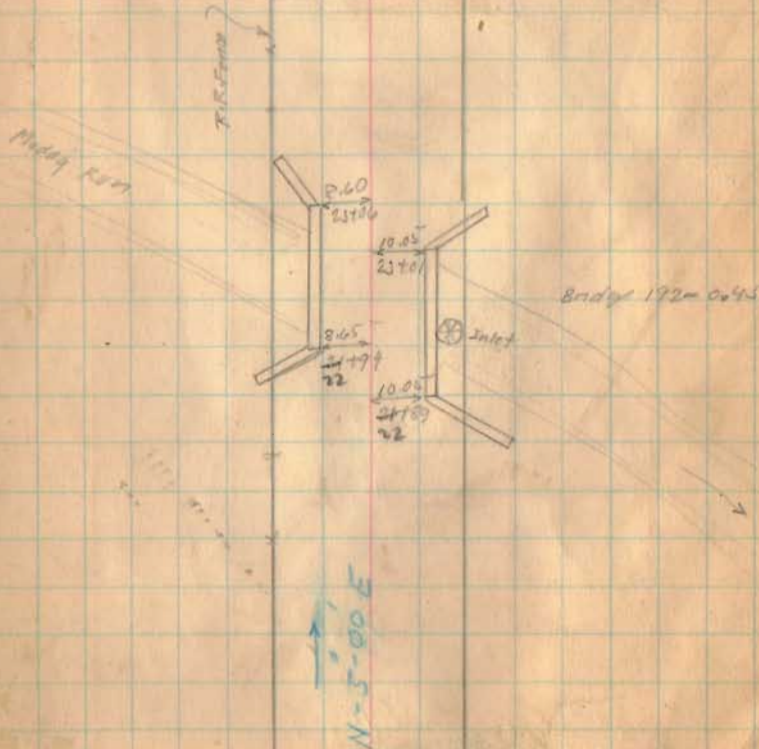



Road 192

35+00

29+00


27+

1698

INDEXED ON MAP

Dec. 10, 1933  
Rain-Snow  
F. Wright  
E. Carr,  
G. Wilgus

33

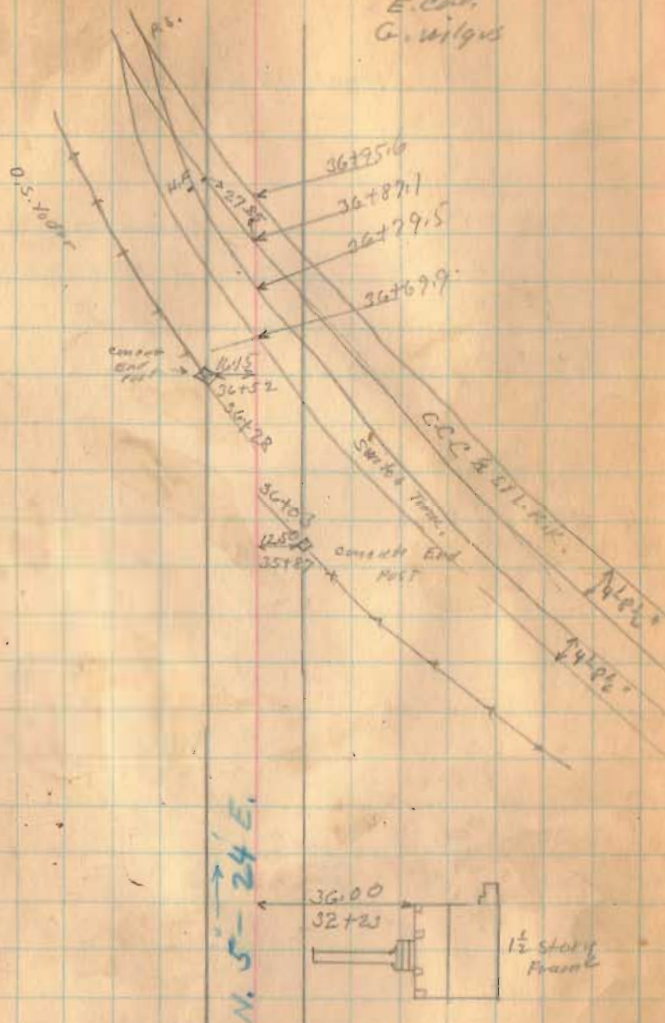

Road 192

53+00

47+00

41+00

1698  
INDEXED ON MAP

Dec. 11, 1935  
Clear - C. W. J.  
F. W. J. 1917  
E. Core  
G. Milgus

34

Bessie M. Elliott

60+04

D. B. Yoder

H. E. Shumaker

54+16

D. S. Yoder

Stone found  
54+16  
0°-33' left

47+66

lane

47+74

N 5°-24' E

D. S. Yoder

38+68

38+77

D. B. Yoder

38+27.4

38+19.0

E. R. R.



Road 192

Length 7421 Feet.  
Length 1.40549 Miles  
" 1.40 "

73+00

69+00

65+00

61+00

55+00

1698  
INDEXED ON MAP

12-11-55 36

