


West end Road 199 at road 32



Stamped Nov 19 1942 R.H.R.

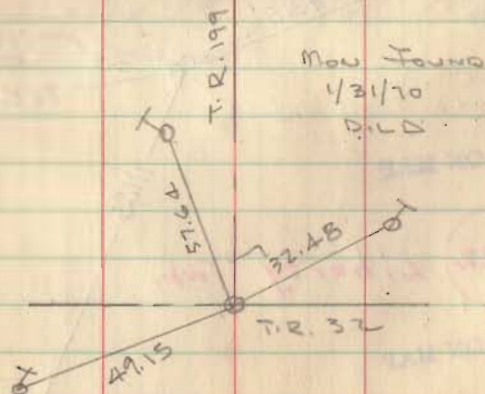


7
G. W. Inskip
F. Hurst
R. W. Gentry
9-14-42

Rd 199 - $\frac{1}{4}$ Cor 142 T3 R14

Found large boulder

Set concrete Mort 6" below surface

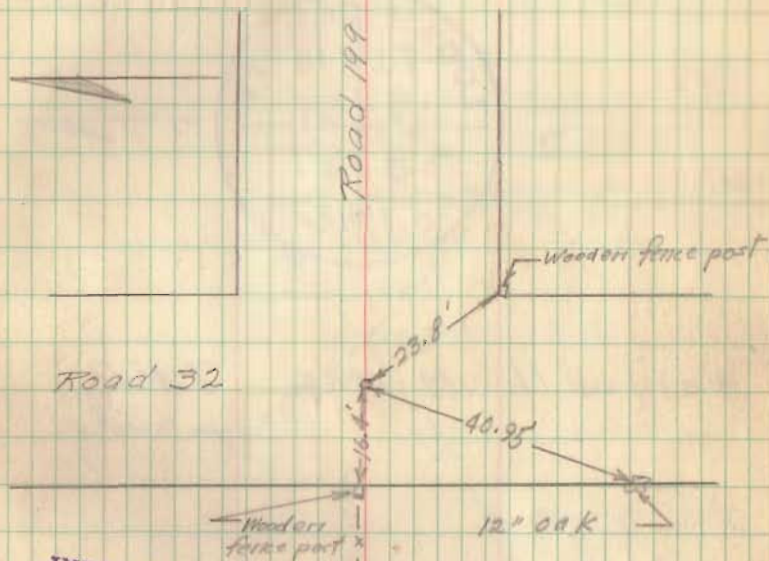

INDEXED ON MAP

2623

Liberty
&
Union Twp's.

INDEXED ON MAP