


10-13-44
 Insert
 Robbins
 Mr. Adams

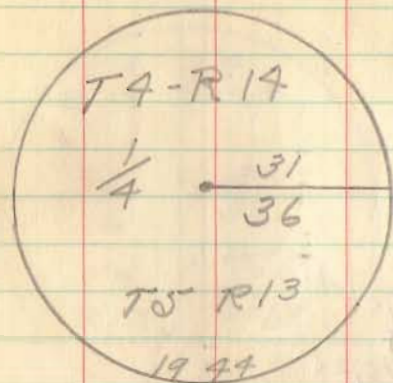

Set Concrete Mon. Where Located
 Aug. 1943.

See Field Book 448 p 11

Full Length - (4')

Top 7" below surface of road
 Marked as above

Road 190

