



10-13-99
Zybert
Dickinson
B. Wilgus

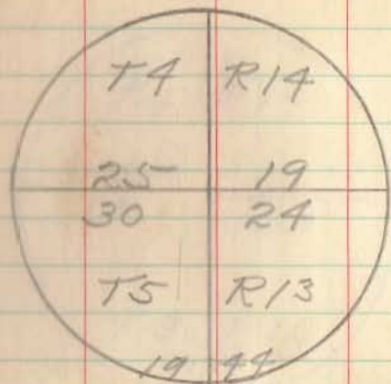

Found 2"x2"x24" Bar as called
for in Book 498 p. 52
Removed same and placed
Con. Mon. Full Length
Top 6" above ground
Marked as above

A. J. Young Farm

41

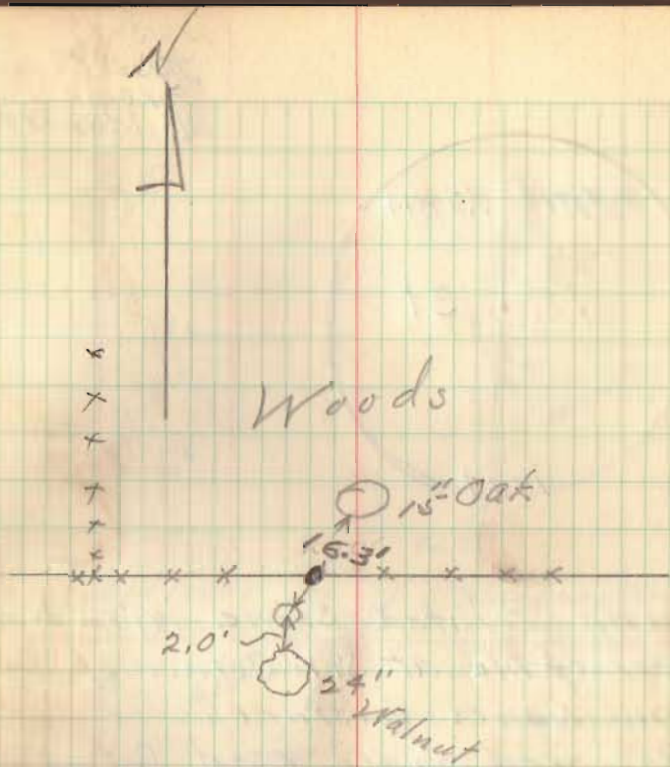

INDEXED ON MAP

Liberty &
Monroe Twp.

2653

INDEXED ON MAP