

FB 702

SURVEY C.H. No. 32
 FROM C.H. #190 SOUTH 1408'
 LIBERTY TWP.

R/W Staked 30'-15' R & Lt. of R
 by order of Township Trustees

Staked from C.H. #190, south 1408.0'

Ran random line from resurvey mon.
 @ C.H. # 32 & 190, south to 1/4 Sec. Stone,
 2681.8'

Set 3/4" pipe on Sec. Line @ 1408.0'
 (Deed - Don E. King Vol. 185, pg. 118)

See F.B. # 660 for Resurvey Mon.
 PAGE 37

Dodson
 Gilbert
 Tevis
 Lino

1-3-14

4-16-60

31-4-14

36

C.H. # 32


Don E. King
 45.00
 Vol. 181/536

Sec. 6.
 Resurvey
 Mon Found

S. 86° E
 C.H. # 190

Hub Set
 in N. Side ditch

Resurvey
 Mon Found
 46r.

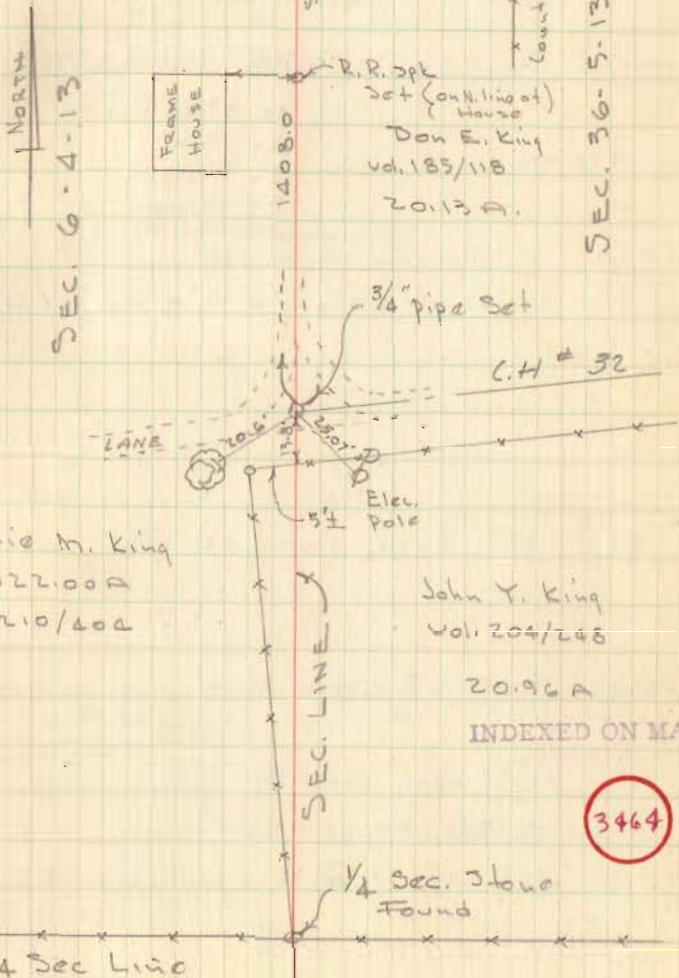

Artie M. King
 122.00A
 Vol. 210/400

John Y. King
 Vol. 204/248
 20.96A

INDEXED ON MAP

3464