


Brg. 31-7.17
(s. of S.P.#47)

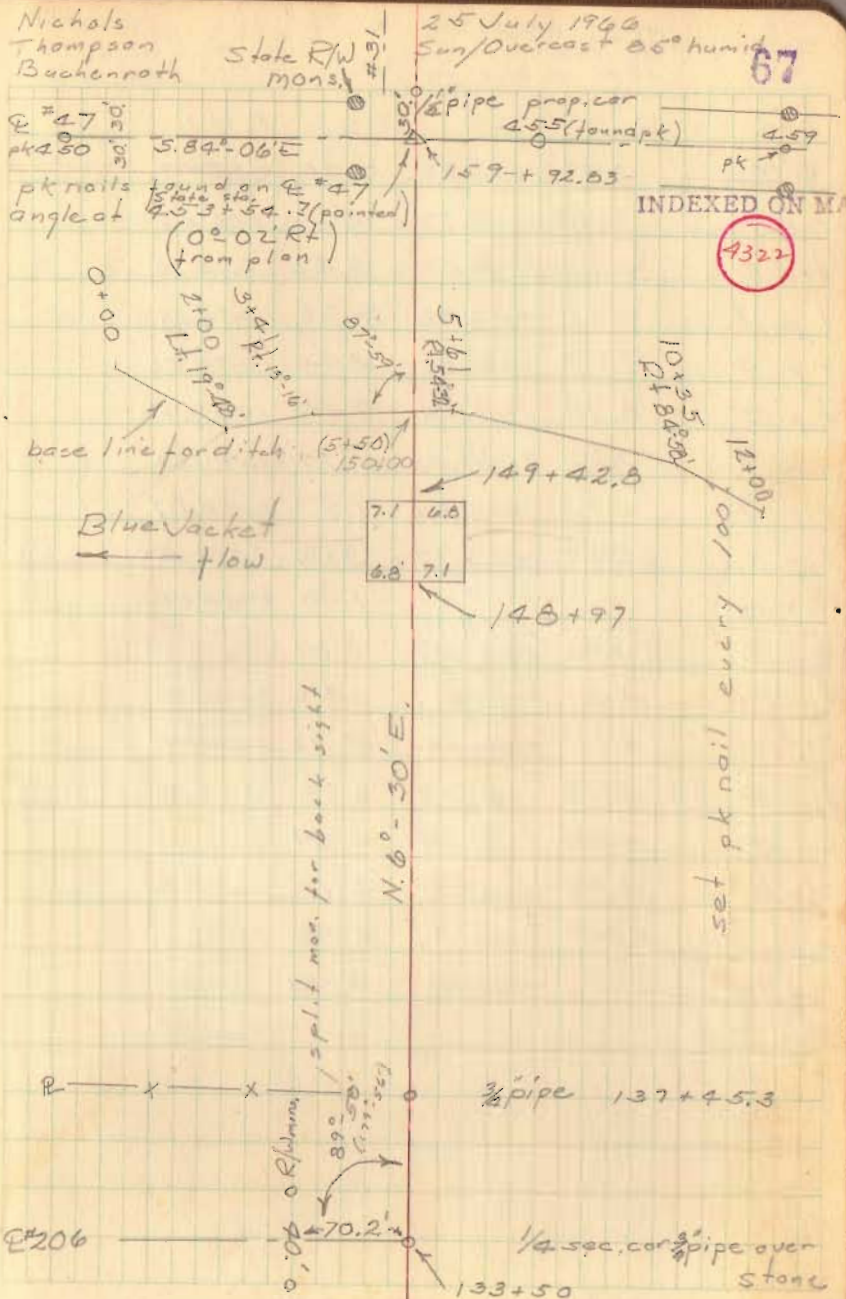

133+50