

Chester Ceepor etux
to
Jack Core etux

July 26, 1969

The following described real estate situated in the Township of Liberty, County of Logan, State of Ohio and being a part of the northeast quarter of Section 30, Township 5, Range 13, BMRS and being further described as follows:

Beginning at the southeast corner to Chester Ceepor's present 18.00 Acre tract, said point being a concrete monument shown as Station 44 + 66 of T. R. No. 190 survey as shown in Field Book 448 Page 50 and also being in the north line of Trella Treyer's present 115.50 Acre tract and being the southwest corner of James W. Robinson's present 24.74 Acre tract;

Thence with the centerline of T. R. No. 190 and the line between Ceepor and Robinson, N. 9° 00' E. 208.7 feet to a R. R. Spike set in said centerline and property line;

Thence N. 82° 42' W. 208.7 feet to an iron bar, passing an iron bar at 20.0 feet;

Thence S. 9° 00' W. 208.7 feet to an iron bar set in the line between Ceepor and Treyer;

Thence with the line between Ceepor and Treyer, S. 82° 42' E. 208.7 feet to the place of beginning, passing through an iron bar near a concrete post at 188.7 feet, containing 1.00 Acre, more or less.

The above described 1.00 acre tract being surveyed out of the southeast corner of Chester Ceepor's present 18.00 Acre tract as recorded in Vol. 195 Page 553 of the Logan County Deed Records.

I hereby certify that this a true and accurate description of a survey made by me on July 26, 1969.


Daniel E. Gilbert
Daniel E. Gilbert, P.S.
Reg. Sur. No. 5402
428 N. Madriver St.
Bellefontaine, Ohio 43311



INDEXED ON MAR

4557 ID

CHESTER COOPER ETUX
17.00 AC.

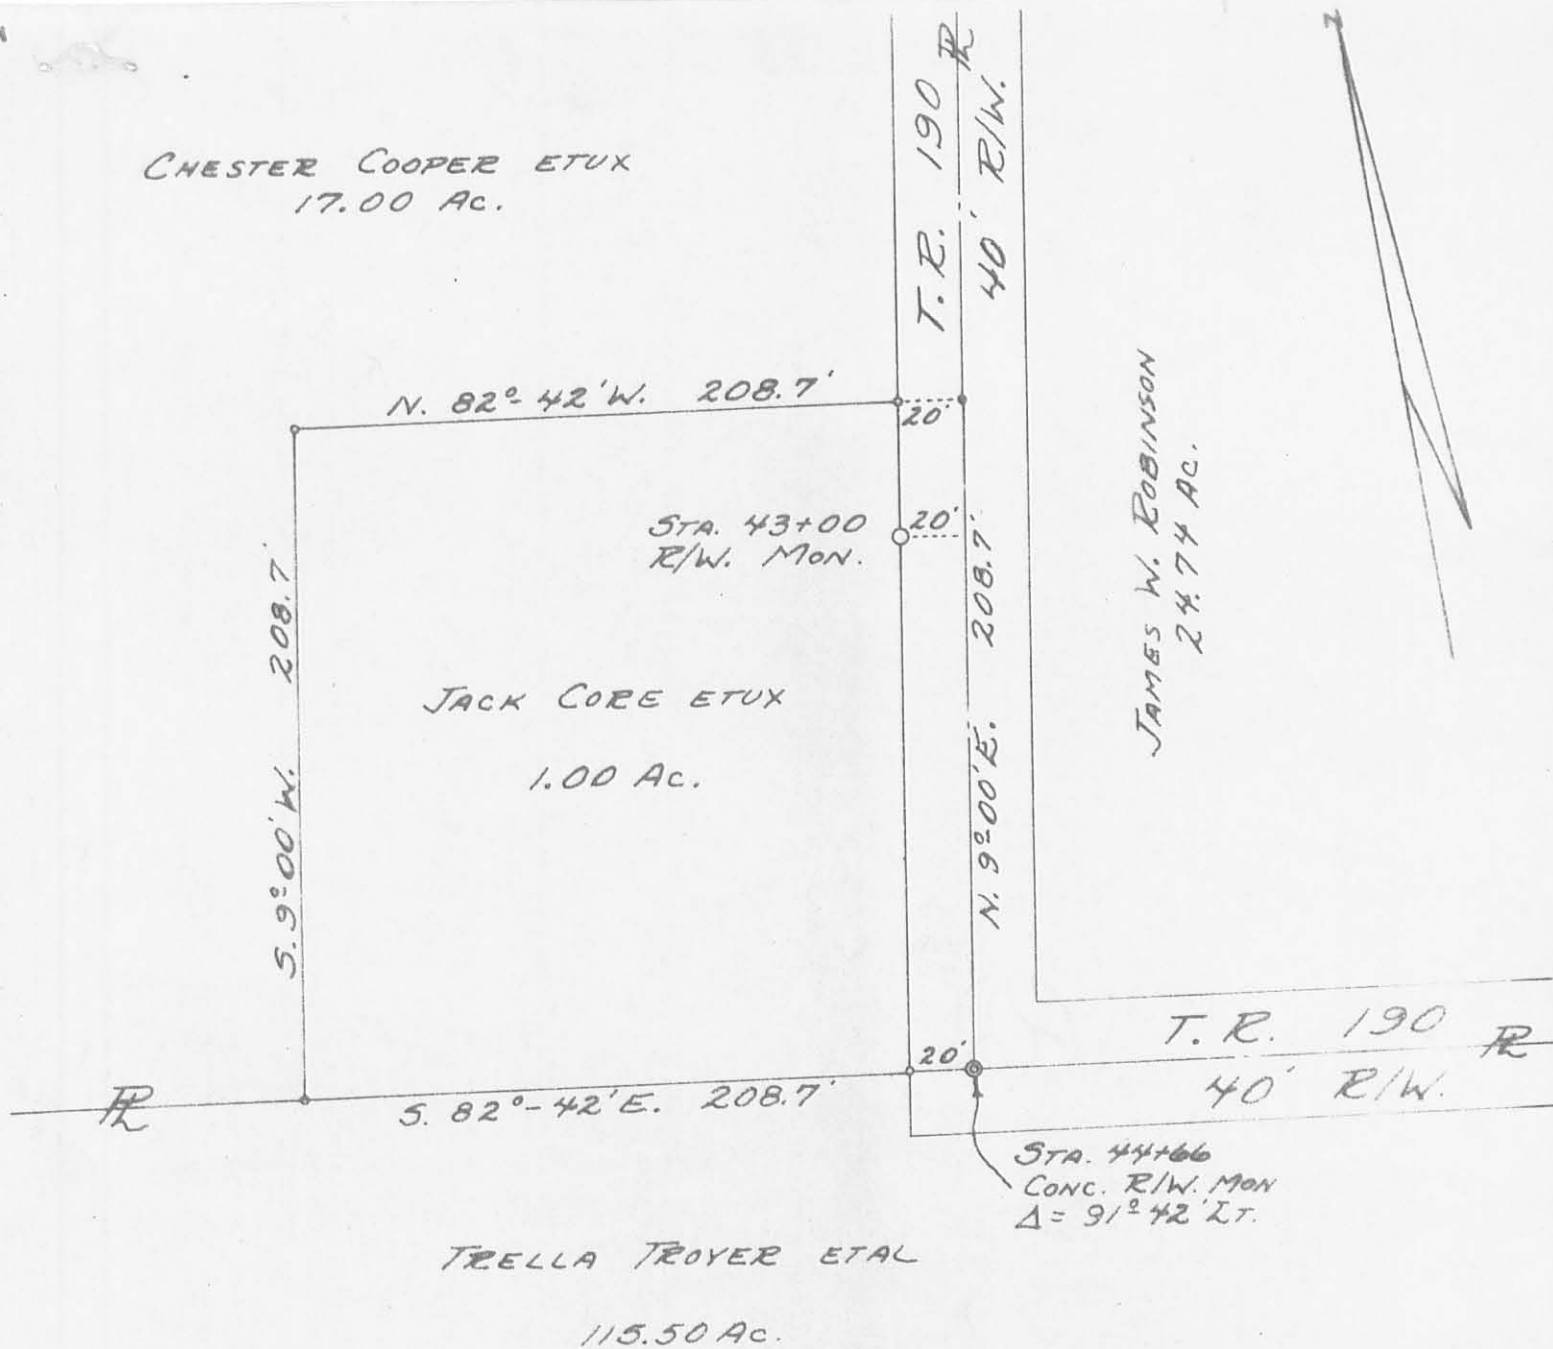

- - R.R. SPIKE SET.
- - 3/8" IRON BARS SET.

REFERENCE:
F.B. 448 PAGE 49-50.

SURVEYED AND PLATTED BY:
DANIEL E. GILBERT, P.S.
REG. SUR. No. 5402
428 N. MADRIVER ST.
BELLEFONTAINE, OHIO 43311

COOPER - CORE SURVEY
SEC. 30 T.5 R.13 M.R.S.
LIBERTY TOWNSHIP
LOGAN COUNTY, OHIO
JULY 26, 1969

SCALE: 1" = 60'

INDEXED ON MAP

4557 IP