

Graber Survey

January, 1976

Being situated in Liberty Township, Logan County, Ohio; and being a part of Section 28, Town 5, Range 13.

Beginning at a point in the center of County Road 5 that is the southeast corner of Graber's 37.36 acre tract.

Thence with the south line of Graber's 37.36 acre tract N 82°-23' W 499.5 feet to an iron. Said iron is the true place of beginning for this description.

Thence S 5°-00' W 315.0 feet to an iron.

Thence N 82°-23' W 876.0 feet to an iron.

Thence N 3°-55' E 323.5 feet to an iron in the south line of Graber's 37.36 acre tract.


Thence S 81°-51' E 882.5 feet to the point of beginning.

Containing 6.43 acres more or less. This is all of the remaining land in the tract the Auditor carries as 11.34 acres.

Owen K. Shirk
Surveyor 4271



GRABER SURVEY
LIBERTY TWP., LOGAN COUNTY, OHIO
SECTION 28, TOWN 5, RANGE 13; 1" = 200'

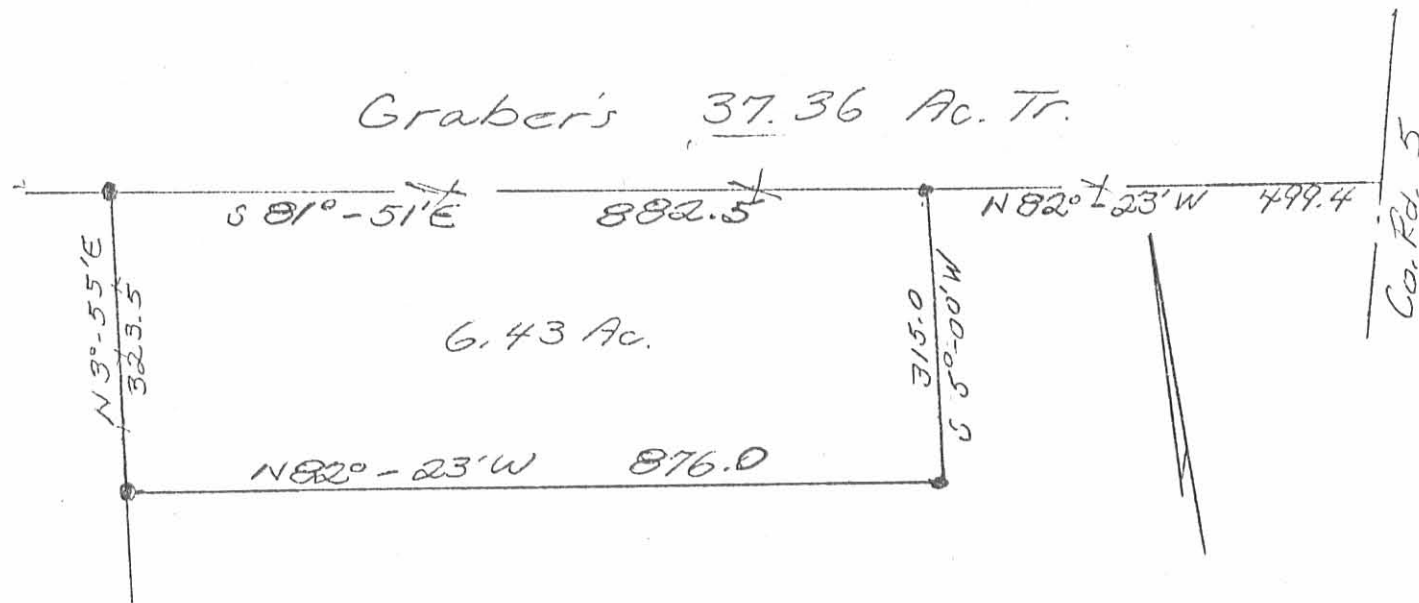

Owen K. Shirk
Surveyor 4271
Jan., 1976

INDEXED ON MAP
5295 1P