

Received 12-11-90

OK 12-12-90 C.R.

LESLIE H. GEESLIN
REGISTERED SURVEYOR NO 5248
P. O. BOX 274
RUSHSVLVANIA, OHIO 43347

TELEPHONE: (513) 468-2793

SMITH SURVEY

December, 1990

The following described real estate situated in the State of Ohio, County of Logan, Township of Liberty, being part of Section 29, Town 5, Range 13, B. M. R. S. and more particularly DESCRIBED as follows:

Beginning at a cap and nail set in the centerline of County Highway 5 at the northeast corner of Mark Vernon's 29.56 acre tract as described in O. R. Vol. 60 Page 638.

Thence with said centerline N. 64° 08' 00" E. 17.72 feet to a 1 inch iron pipe found at Station 85 plus 10.4.

Thence with said centerline N. 80° 46' 00" E. 19.64 feet to a ½ inch iron bar found.

Thence with said C. H. 5 centerline N. 81° 04' 00" E. 202.09 feet to a ½ inch iron bar found.

Thence with said centerline N. 73° 37' 00" E. 16.33 feet to a cap and nail set.

Thence S. 6° 44' 49" W. 573.38 feet to a 5/8 inch iron bar set, passing a 5/8 inch iron bar set at 32.62 feet.


Thence N. 83° 15' 11" W. 243.41 feet to a 5/8 inch iron bar set in the east line of said Vernon's 29.56 acre tract.

Thence with said Vernon's east line N. 6° 44' 49" E. 479.39 feet to the place of beginning.

Containing 3.000 acres more or less, of which 0.176 acre is in the right-of-way of C. H. 5.


The above described 3.000 acre tract being on the west side of Gary Smith's 32.33 acre tract as described in O. R. Vol. 53 Page 155.

Bearings are based on an assumed bearing (N. 81° 00' 00" E) for the centerline of C. H. 5, which was established by F. B. 509 Page 57, in this field survey.

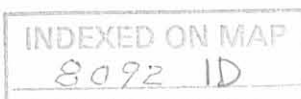

Leslie H. Geeslin

MARK VERNON
29.56 AC.
O.R. VOL. 60 PG 638

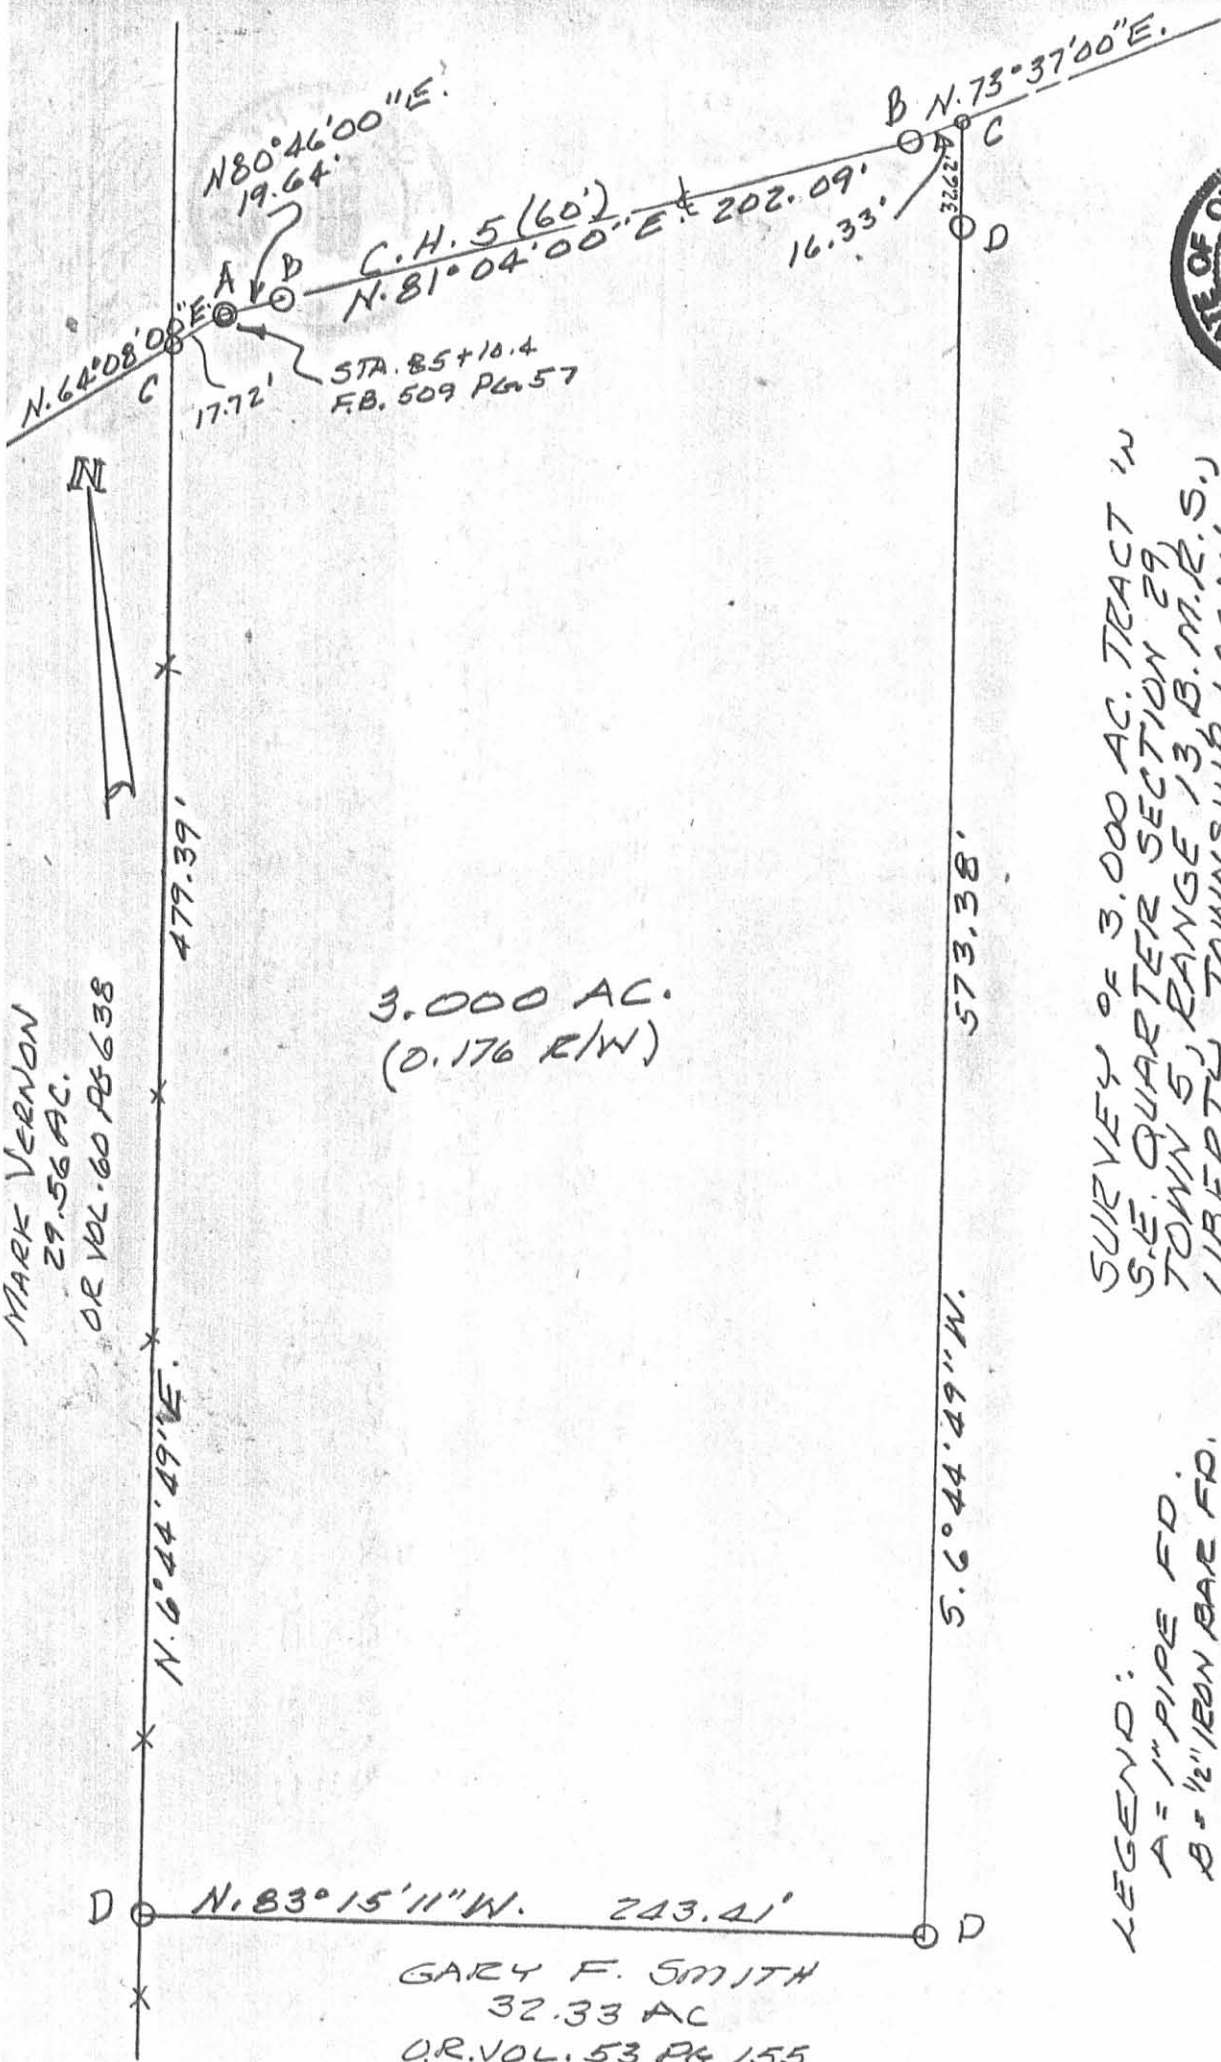

3.000 AC.
(0.176 R/W)

GARY F. SMITH
32.33 AC
O.R. VOL. 53 PG 155



SURVEY OF 3.000 AC. TRACT IN
S.E. QUARTER SECTION 29,
TOWN 5, RANGE 13, B.M.R.S.,
LIBERTY TOWNSHIP, LOGAN
COUNTY, OHIO FOR GARY SMITH.
DECEMBER, 1990
SCALE: 1"=60'

LEGEND:
A = 1" PIPE FD.
B = 1/2" IRON BAR FD.
C = CAP AND NAIL SET
D = 5/8" IRON BAR SET

INDEXED ON MAP
8092/P

Leslie H. Geeslin
LESIE H. GEESLIN
RUSHVILLE, OHIO
PH 513-468-2793