


72 10th mo. (Oct) 26th 1827 ✓ Survey no. 87 (8213)


Surveyed for Martin Shields and others; Beginning at a stake in the road leading from West-Liberty to Bellefontaine, where the east line of section 24 in Town. 5 Range 13 N.W. 1/4. crossing said road, also at the South east corner of the north east quarter of said section; thence north $37\frac{1}{2}$ poles to a stake a few feet South of a black oak bush; thence west, $\frac{1}{2}$ westerly variation, crossing said road at 32 poles, 170 poles, a white oak 170° N 10 links a white $63^{\circ} 6'$ 17 links; thence $63^{\circ} 6'$ poles, a black oak south 12 links; thence east $\frac{1}{2}$ westerly variation 170 poles to the beginning containing forty acres off of the south side of the south east q. sec 24 Town 5 Range 13 N.W. 1/4.

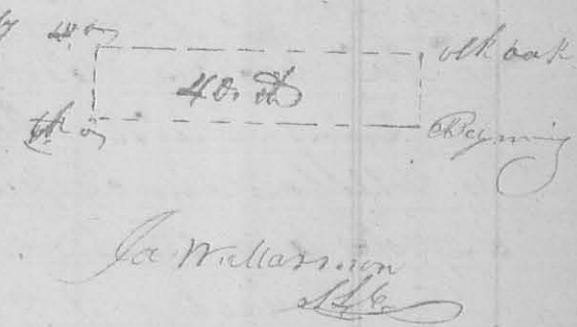

Ja. Williamson
S. L. C.

10th mo. (Oct) 27th 1827 ✓ Survey no. 88 (8214)

Surveyed for Joseph McBeth; Beginning at the south east corner of section 35 in Town. 5 Range 13 N.W. 1/4. a white oak 20 inches in diam. $\pm 40^{\circ} 6'$ 14 links dist. a white oak 130° N 25 links; thence north $37\frac{1}{2}$ poles to a large forked white oak; thence west ($\frac{1}{2}$ westerly variation) 170 poles; thence south 67° poles to a large white oak in the south line of the section; thence with said line east ($\frac{1}{2}$ variation) 170 poles to the beginning containing 40 acres off the south side of the south east quarter of said section.

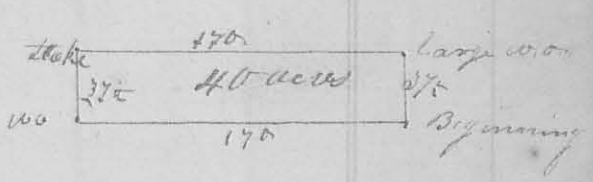

Ja. Williamson S. L. C.

10th mo. (Oct) 27th 1827 ✓ Survey no. 89 (8214)

Surveyed for Joseph McBeth; Beginning at a stake north west corner to the above survey no. 88; thence north 120 poles to a stake in the center of Sec. 35 Town 5 Range 13; thence east ($\frac{1}{2}$ variation westerly) 79.3 poles; thence west to a large oak

in his testimony and near a small ¹³⁵
 hickory bush, at which point I caused
 a large stone to be planted in the pres-
 ence of the following named persons -
 John Prater, Andrew Roberts, B. Stan-
 ton Esq, Henry Rosebrough, Wm D. Brun-
 son, Jeremiah Hill, Eros Williams,
 Samuel Searduff, -
 William Callahan } ch.ers.
 David Pugh }
 O. Hayes Sur. L.C.

Survey N^o 633 ^{Surveyed Aug. 5th 1848}
 for Samuel M^{rs} Beth the
 South West quarter of Section 35. Town
 5. Range 13 E. L. M. R. as follows -
 Beginning at the S. W. corner of said
 Section at a stone from which a
 Burr Oak stump bears N 53 E 17 links
 distant, thence N 10 E 160 1/2 poles to
 a stone and stake, thence N 89 3/4 E
 172 poles to a stake at the centre
 of the Sect. thence S 10 W 160 1/2 pos-
 to a stone in the centre of the South
 line of said Sect, thence S 89 3/4 W 171 1/4
 poles to the place of beginning contain-
 ing 172 Acres and 186 perches.

Saml M^{rs} Beth }
 John Stow } ch.ers.
 April 3rd 1848 }
 O. Hayes Sur. L.C.
 Subdivided the foregoing gr. by ~~line~~
 for Samuel M^{rs} Beth and Shepard Green by
 a line beginning at the middle of the S. line
 thence N 10 E to the centre of that S. line of the same
 S. Green } ch.ers.
 O. Hayes Sur. L.C.