

85
 a branch at 10 poles to a stake. - Thence S 17° 24 poles (copying a branch at 3 poles) to a stake. - Thence N 89 1/2° W 14 poles to a stake. - Thence S 17° 40 poles to a stake in the south line of the north west q. a white oak diam. 120 & 15 links dist. - Thence S 89 1/2° E. (set a stake at 25 poles) 50.6 poles to the centre corner of the sec. the stake having been removed and the bearing tree a live - one 12 in. diam. N 40° E 12 links dist. being cut down. I set another stake (see surveyors. 32, page 19). - Thence N 10° E 108 poles to the beginning corner (copying a branch at 48 poles and one at 100 poles) containing 48 acres off the east side of the N. W. q. in said sec. &c.




Jackson McClain } 66
 Samuel Houser }
 Jas. Williamson S. L. C.

7th mo. (July 25, 26, 27, 1828) Survey No 110
 (B 176) Surveyed and divided the north east and south west quarters of section 33 Town 5 Range 13 M. R. L. under the direction and by the orders of John Shelly, Jeremiah Fruton and John Moor, Commissioners appointed by the court of Comm. pleas in Logan County Ohio, to make partition of the estate of William F. well decd, equally to each of order of said Court to the Sheriff directed first with the cut line of the N. E. q. Beginning at the south east corner thereof in the east line of the section, a white oak 4 inches diam. S 72° E 13 links dist. a white oak 16 in. diam. N 29° E 11 links dist. - Thence north with the original line 86 1/2 poles to the north east corner thereof a stake in a prairie - Thence west 172 poles with the original line to a stone also comes to the N. E. q. - Thence South (copying a branch at 22 poles) 163 poles to the centre of the section, a white oak 20 in. diam. S 7° E 26 links - Thence east (copying

a branch at 150 poles) 172 poles to the beginning contain-
 -ing 175 acres. - The 1st division line begins at a stake in
 the north line of the gr 78.5 poles east of the stone
 e. w. corner thereof. Thence south 142 poles to a stone on
 the south bank of a branch. - Thence east 7 1/2 poles to a
 stake in said branch. - Thence south 26 poles to a stake
 in the orchard in the south line of this gr. making
 the east line of lot no 1, which which contains 50 1/2
 acres of 37 poles. - The 2nd division line begins at a stake in
 the east line of the

gr 8 1/2 poles south
 from the north east
 corner thereof. thence
 west 9 3/4 poles to a
 stake in a hazel
 thicket in the east
 line of lot no 1 -
 dividing the east
 part of this gr into
 2 parts containing
 47 acres each. -

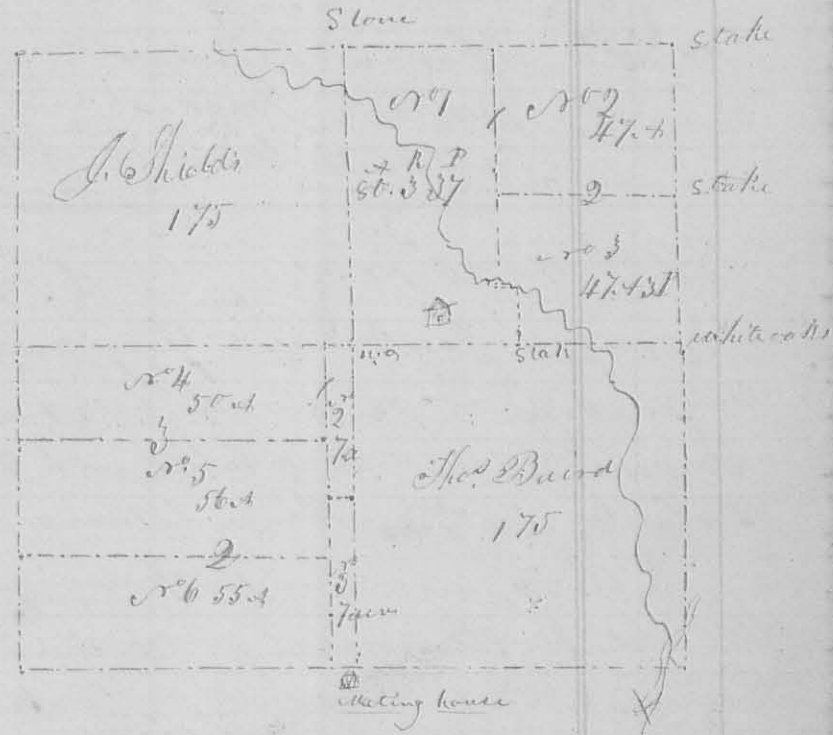

2nd the out line of
 the south west gr. Beginning at the south west corner thereof, the ori-
 ginal bearing trees yet standing, a bur oak 14 in. diam. e 25 1/2
 36 links, a white oak 12 in. diam. S 6 1/2 W 42 links. - Thence
 east 172 poles to a black oak 20 in. diam. S 52 1/2 E 33 links. -
 Thence north 16 3/4 poles to the south west corner of the e. w. gr in
 the center of the sec. - Thence west 172 poles to a bur oak
 in the west line of the sec. - Thence with said line south
 16 3/4 poles to the beginning, containing 175 acres. - The 1st
 division line begins at a black oak bush in the north
 line of this gr. 13.8 poles west from the centre corner of
 the sec. - Thence south 8 1/2 poles to a stake. - Thence east 13 1/2
 poles to a stake in the east line of this gr. - from the former
 stake south 8 1/2 poles to a stake in a grave yard e 25 1/2 W
 60 feet from David King's tomb, stone, making the ob-
 -long lots 2 1/2, containing 7 acres each. - The 2nd line

87 begins at a stake in a road 55.6 poles north from the last named, and in the east line of lot no. 3 in this gr. Thence west 158.2 poles to a hickory 14 in. diam. 17 1/2 links, making the north line of lot no. 6 which contains 55 acrs. The 3rd line begins at a stake in the west line of the Sec. 56.7 poles north of the last named corner a white oak bush thence east 158.2 poles to a stake in the east line of lot no. 2 in this gr. making the north line of lot no. 5 which contains 56 acrs and the south line of lot no. 4 which contains 50 acrs. Houston Crockett } Clk. J. M. Marmore
 Garland Crockett } S. G. S. L. C.
 Cartmell Crockett master

9th mo 26th 1828 Survey No. 111

Surveyed for Vincent Gray and brother Elephas Gray Beginning at the corner between sections 1 & 2, 7 & 8 in Town 5 N. 13 N. R. 13 W. a white oak 24 inches diam. 166° E 54 links dist. Thence between sec. 1 & 2 (41' westerly variation from the original line) 165 poles crossing a prairie, and deep pond to the original gr. sec. corner, a white oak now 14 in. diam. S 85° E 10 links dist. (The other tree called for in the original field notes is down). Thence south 169 poles to a white oak 12 inches in diam S 66° E 10 links dist. Thence west (41' variation westerly allowed) 165 poles to a stake in the west line of the sec. in Alex. Dokes orchard. Thence north 159 poles to the beginning containing 165 1/4 acrs. Then made a division line, beginning at a stake in the west line 77 1/2 poles south of the beginning. Thence east (allowing 41' variation) 165 poles to a white oak 18 in diam S 41° E 25 links dist dividing the gr. into two equal parts of 81 3/4 acrs each



George Gray } Clk.
 Andrew Gray }
 G. Gray master J. M. Marmore G. S. L. C.

212 (8116)

No. 705

April 10th 1850

Surveyed a

part of Runkle & Homing's subdivision
of the S. E. q^r. of Section 33 T. 5 R. 13 E. C. G.
M. R. for John Hunter to Jeremiah Clinger
as follows beginning at a stake at
the N. E. corner of lot (No. 43 in said sub-
division (see plat on pages 154-5) thence
S 67 $\frac{1}{2}$ ° W 3 $\frac{1}{4}$ poles to a stake, thence S $\frac{1}{2}$ ° W
88 $\frac{1}{2}$ poles to a stake in the South line
of said section; thence S 89° E 87 $\frac{1}{2}$ poles
to a stake (From the first of the last two
mentioned stakes a white Thorn 5 T. S. S.
bears N 39° E 41 links dist, and from the
other a white Thorn 6 S. S. N 23 $\frac{1}{2}$ ° W 115 links)
thence N 32° W 56 $\frac{1}{2}$ poles to a stake in
an old Road; thence N 35° W 69 $\frac{1}{2}$ poles
to the place of beginning. Containing
22 $\frac{3}{4}$ Acres - See plat of Clinger's lot pages 154-5,

Here: Clinger
R. H. Cheatham) C. C.

O. Hayes Sur. L. C. G.

No. 706

April 25th 1850.

Surveyed

the North half of the N. W. q^r. Sec,
No. 28 T. 5. R. 13. E. C. G. ^{for J. P. Miller} as follows. Begin-
ning at the N. W. corner of said section; thence
S 11 $\frac{1}{4}$ ° W 82 $\frac{1}{2}$ poles to a stake in the west line
of said section; thence S 89° E 162 $\frac{1}{2}$ poles to
a stake, in a pasture; thence, N 11 $\frac{1}{4}$ ° W. 82 $\frac{1}{2}$ poles
to a stake in a county Road; thence N 89° W,
161 poles along said road to the place of begin-
ning. Containing 83 Acres.

Archibald Prater
Newman Prater) M.

O. Hayes Sur. L. C. G.

(B. 577)