


Survey
Nov 20 1882

8523

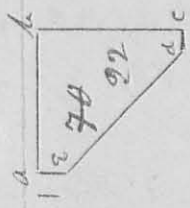

- ac = 150 ft
- bc = 150 "
- ca = 23 1/3 "
- ab = 175 "
- ba = 28 1/2 "
- fish furline
- hg =
- gf =
- kl = 65 1/3 ft
- lm = 71 1/2 ft
- mn = 72 ft
- no = 29 "
- nz = 72 "
- or = 148 "
- op = 261 "
- po = 215 "

- qg = 150 ft
- qv = 163 1/2 "
- rs = 319 "
- qt = 197 "
- qu = 67 "
- ut = 75 "

Note. Instead of 76 there are

But 107 lots in this addition

L. Hayes Esq. C. Ohio,

57	58	59
3	2	1

57	58	59
7	6	5

57	58	59
8	7	6

57	58	59
9	8	7

57	58	59
10	9	8

57	58	59
11	10	9

57	58	59
12	11	10

57	58	59
13	12	11

57	58	59
14	13	12

57	58	59
15	14	13

57	58	59
16	15	14

57	58	59
17	16	15

~~57 58 59~~
plat

~~57 58 59~~
of the

~~57 58 59~~
area

~~57 58 59~~
left

~~57 58 59~~
part

~~57 58 59~~
See map
of 1854

~~57 58 59~~
18 Street

~~57 58 59~~
13 Street

~~57 58 59~~
14 Street

~~57 58 59~~
15 Street


~~57 58 59~~
16 Street

~~57 58 59~~
17 Street

Beire Street

By agreement of P. Miller

See page 111

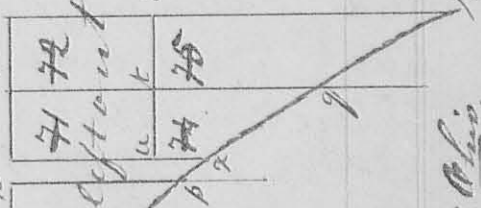

See next page

March 17, 1849 Surveyed an Addition to Miller's addition to the town of West Liberty for J P Miller, as represented by the above plat, Reynolds Street bears $\text{N } 2^{\circ} 30' \text{ W}$, & other Streets and alleys parallel & at right angles with said street, Lots 12, 13 & 14 are part of first addition made 27th May 1841. Lots from 15 to 69 inclusive, except 27, 28, 29, & 30 are each 50 feet in front and extend back 150 feet, Lots 71 & 72 are each 75 feet in front and 150 feet back. Lots all front as represented in plat, alleys are each 16 feet wide, Columbus, Reynolds and Fuscon Streets are each 70 feet wide. Baird, Miller's & Crockett Streets are each 60 feet wide. The south west side of Lots 75, 74, 73, 27, 28, 29, 30 & 70 is bounded by the east line of the Rail Road territory and is 50 feet from center of Rail Road track. A stone is planted at the ^{south} East Corner of Lot 15 which bears $\text{S } 2^{\circ} 30' \text{ E}$ from the South East Corner of Reynolds yard wall

A. H. Harrison
C. S. L. C. C.

J. Hangan } ex er
R Crockett }
Jordan mkr

Note. March 14th 1848 a Resurvey of the foregoing Lots was made and lots 28, 29, 30, 31, 32, 33, 34, 35, 36, 37, 38, 39, 40, 41, 42, 43, 44, 45, 46, 47, 48, 71, 72, 73, 74, and 75 were omitted to be laid out as they are represented on the foregoing plat, said lots were entirely excluded from the plat, to be laid out and recorded at some future period

O. Hays, Sur. Genl.