

Survey for Shick & Hughes

M^cARTHUR TWP VMS 9881

South line 6.725

approx 711 6725

West line of Shick S6W

from @ L 414 pole 17.18 ch

measured West side of 34 ans
24.55

found One stone 6.89

South line of Shick S83W

Bearing of Road N36W

28 ch ~~75~~ on old
Set stakes ~~429~~³⁰ ch from
Iron pin..

n line Shick N80W


10.95 length to corner

7.24 line of West

April 16 1921 ⁶⁸⁹ 9881

10.95
16.72
17.67

Hughes } ch.
Shick }

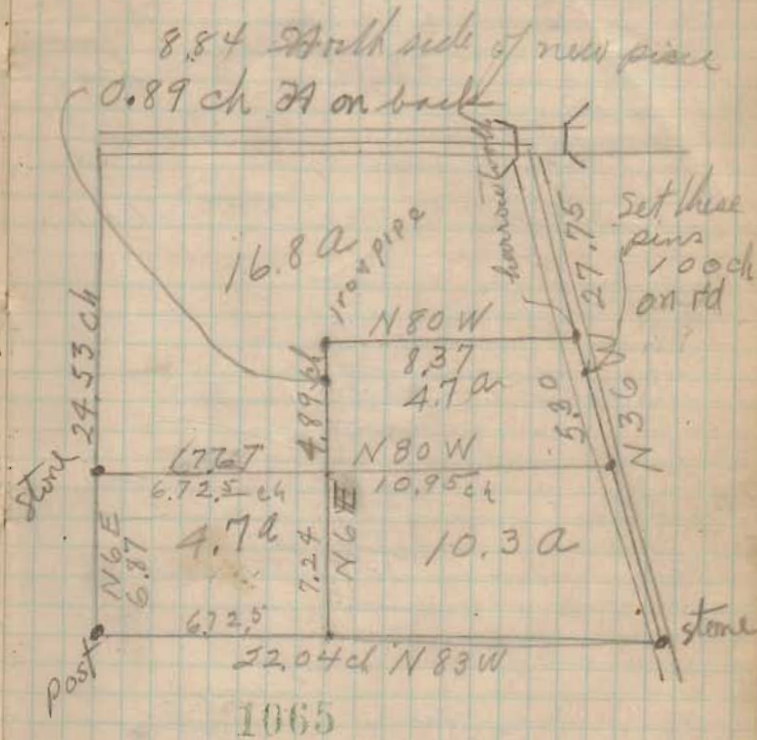

INDEXED ON MAP