


Road 222
 19^s Arthur Trapp

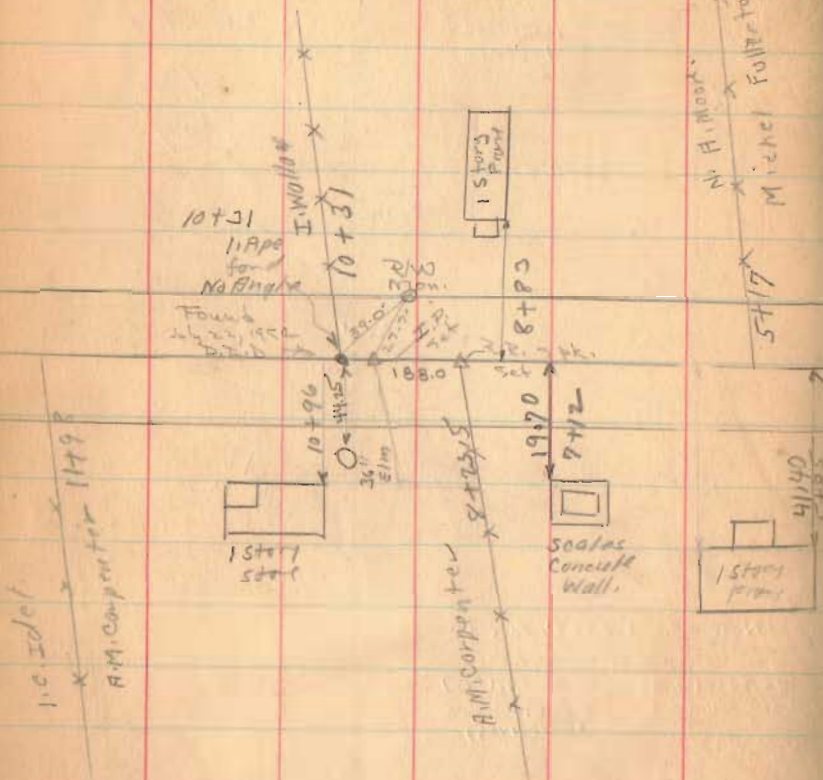


50' Huntsville - Belle Center Pike - 1873
 Free Turn Pike Record 3 Page 151

1577

INDEXED ON MAP


May - 30-1934
 Clear - Warm - Dry
 Wright
 Mills
 Ratsfelder
 Henry

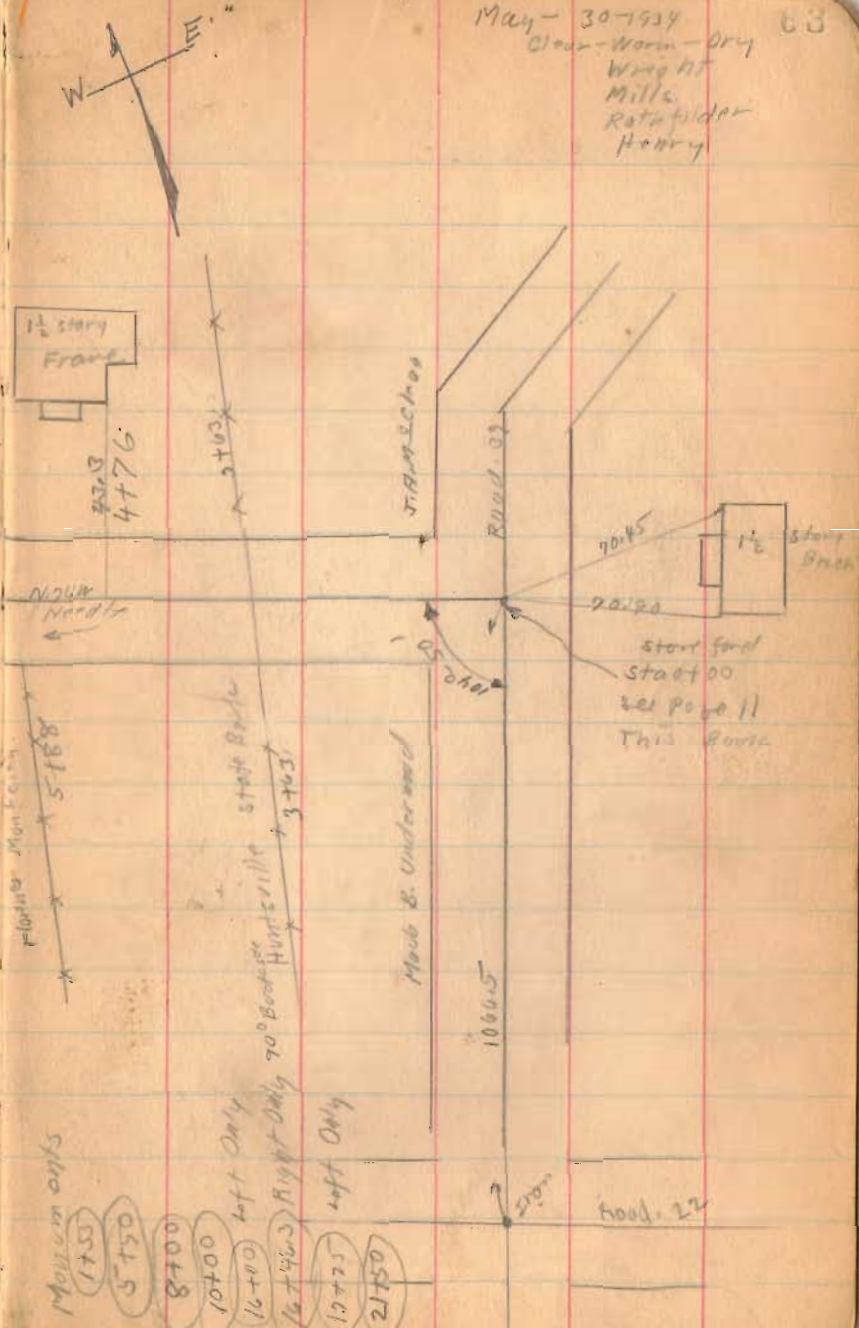


- Museum on left
- 1750
- 5750
- 8700
- 10+00
- left Only
- 16+00
- 16+46.3 Right Only
- 70° Boudier Huntsville
- 13+63
- left Only
- 17+75
- 21+50

Road 22

Road 222

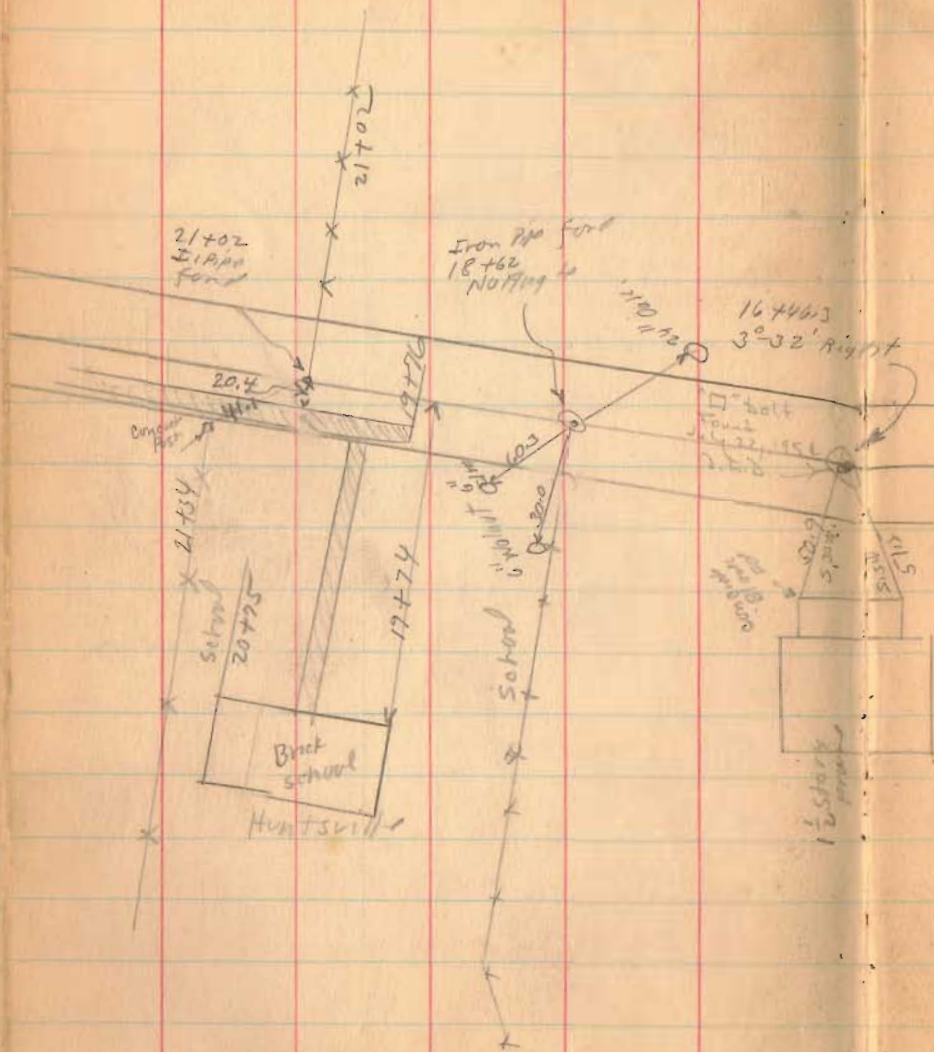

1 1/2 story frame
(old - vacant)

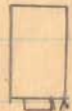

127.54

2134 feet = 4042 Miles
40 "

1577

INDEXED ON MAP