

McCormick Survey  
McArthur Township  
August 29, 1963

The following described real estate situated in McArthur Township, Logan County, Ohio and being part of Virginia Military Survey 9929 and more particularly described as follows:

Beginning at a spike in the centerline of C.H. 39 at the northeast corner of Charles E. Snapp's 1.00 acre tract; thence with Snapp's north line S.  $82^{\circ}-10'$  W. 236.16 feet to a corner post; thence N.  $7^{\circ}-50'$  W. 165.00 feet to a 1" pipe; thence N.  $82^{\circ}-10'$  E. 270.20 feet to a spike in the centerline of C.H. 39; thence with the centerline of C.H. 39 S.  $0^{\circ}-55'$  W. 73.18 feet to a 1" pipe, said pipe being Sta. 48+00 as shown in Logan County Engineer's Field Book 579, Page 13; thence continuing with the centerline of C.H. 39 S.  $6^{\circ}-03'$  W. 95.45 feet to the place of beginning.

Containing 0.97 of an acre more or less.

The above described real estate being taken from Grant McCormick's 102.42 acre tract.

Surveyed by: Donald L. Lewis  
Surveyor-in-Training


Approved by: Chester R. Kurtz  
Registered Surveyor 4849

10

3578

INDEXED ON MAP

Grant L. McCormick  
102.42 Ac.

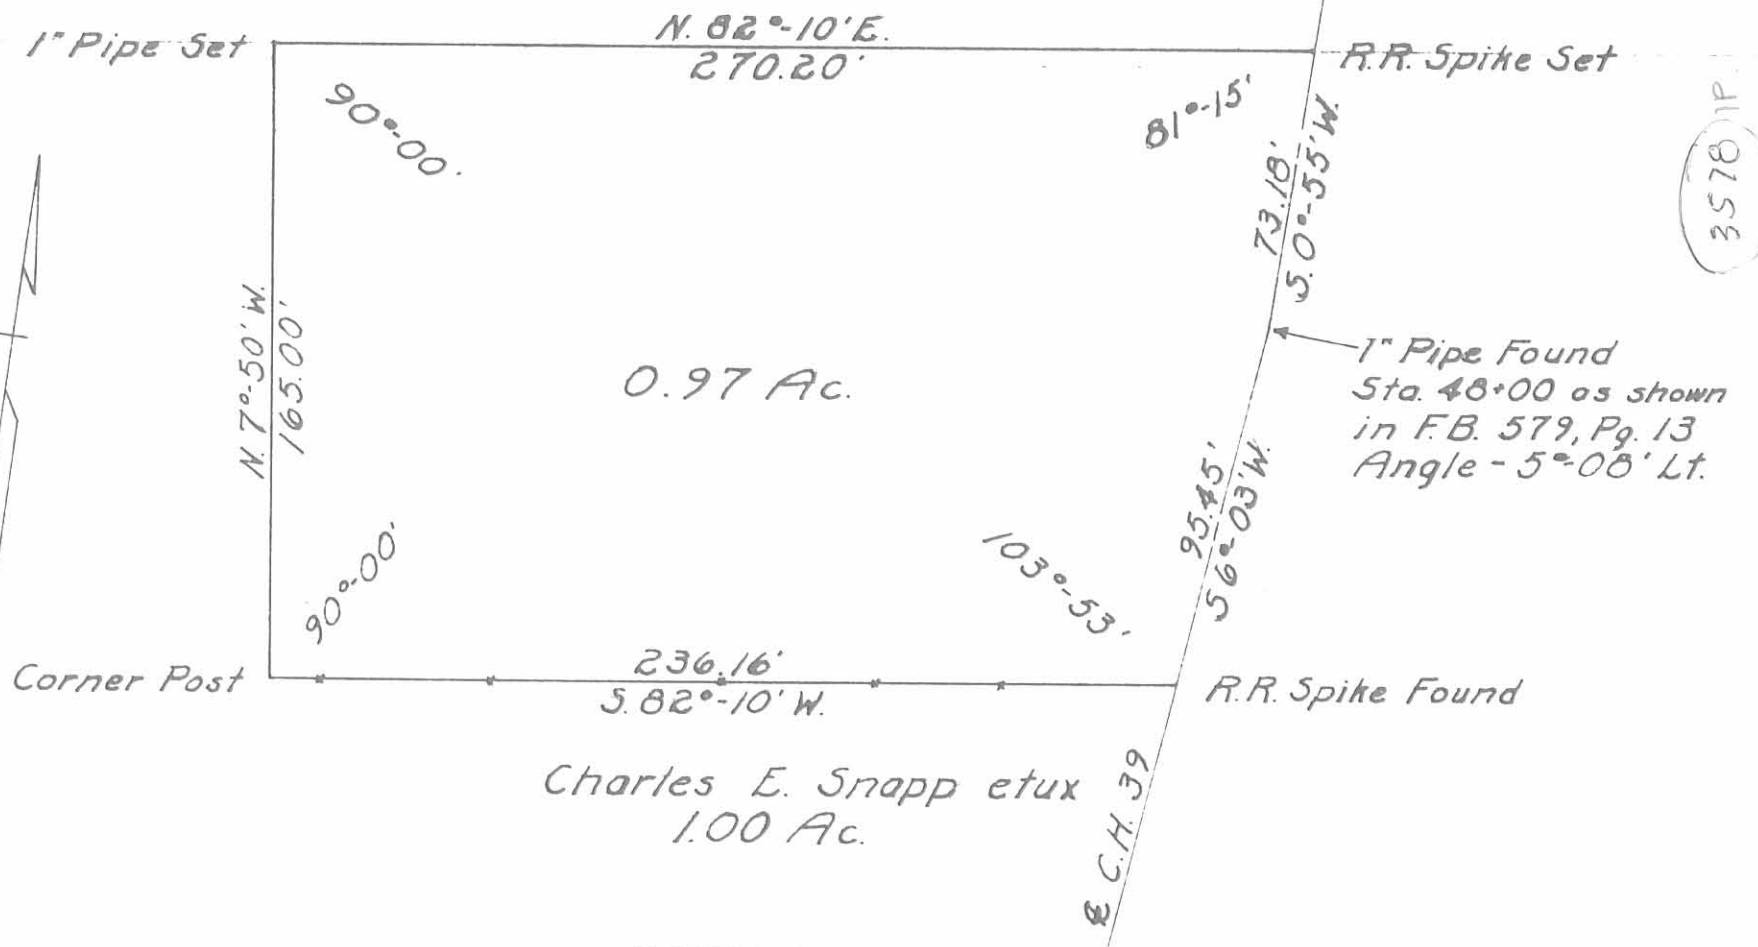

3578 IP

INDEXED ON MAP

0.97 Ac.

Charles E. Snapp et ux  
1.00 Ac.

McCORMICK SURVEY

VIRGINIA MILITARY SURVEY 9929

McARTHUR TOWNSHIP

August 29, 1963

Scale-1"=50'

Surveyed by: Donald L. Lewis  
Surveyor-in-Training

Approved by: Chester R. Kurtz  
Registered Surveyor 4849