

KAHL SURVEY
V.M.S. 9907
McArthur Township
May 18, 1968


The following described real estate situated in McArthur Township, Logan County, Ohio and being part of Virginia Military Survey 9907 and more particularly described as follows:

Beginning at an iron bar in the center of McArthur Township Road No.37 at the southwest corner of said V.M.S. 9907, said iron bar also being Sta. 446+12.9 as shown in Logan County Engineers field book 687, page 28, said bar also being the southeast corner of Ronald M. Snapp's 3.67 acre tract; thence with said Snapp's east line $N.3^{\circ} 49'W.$ 579.6 feet to an iron bar at the northeast corner of said tract; thence $N.70^{\circ} 09'E.$ 120.0 feet to an iron bar; thence $S.47^{\circ} 28'E.$ 325.2 feet to an iron bar; thence $S.21^{\circ} 53'E.$ 380.0 feet to an iron bar in the center of said T. R. No.37, passing an iron bar at 359.2 feet; thence with the centerline of said T. R. 37, $N.84^{\circ} 11'W.$ 458.0 feet to the place of beginning.

Containing 4.58 acres more or less.

The above described tract being part of Ivan D. Kahl's 108.50 acre tract.

4276 ID
Indexed On Map

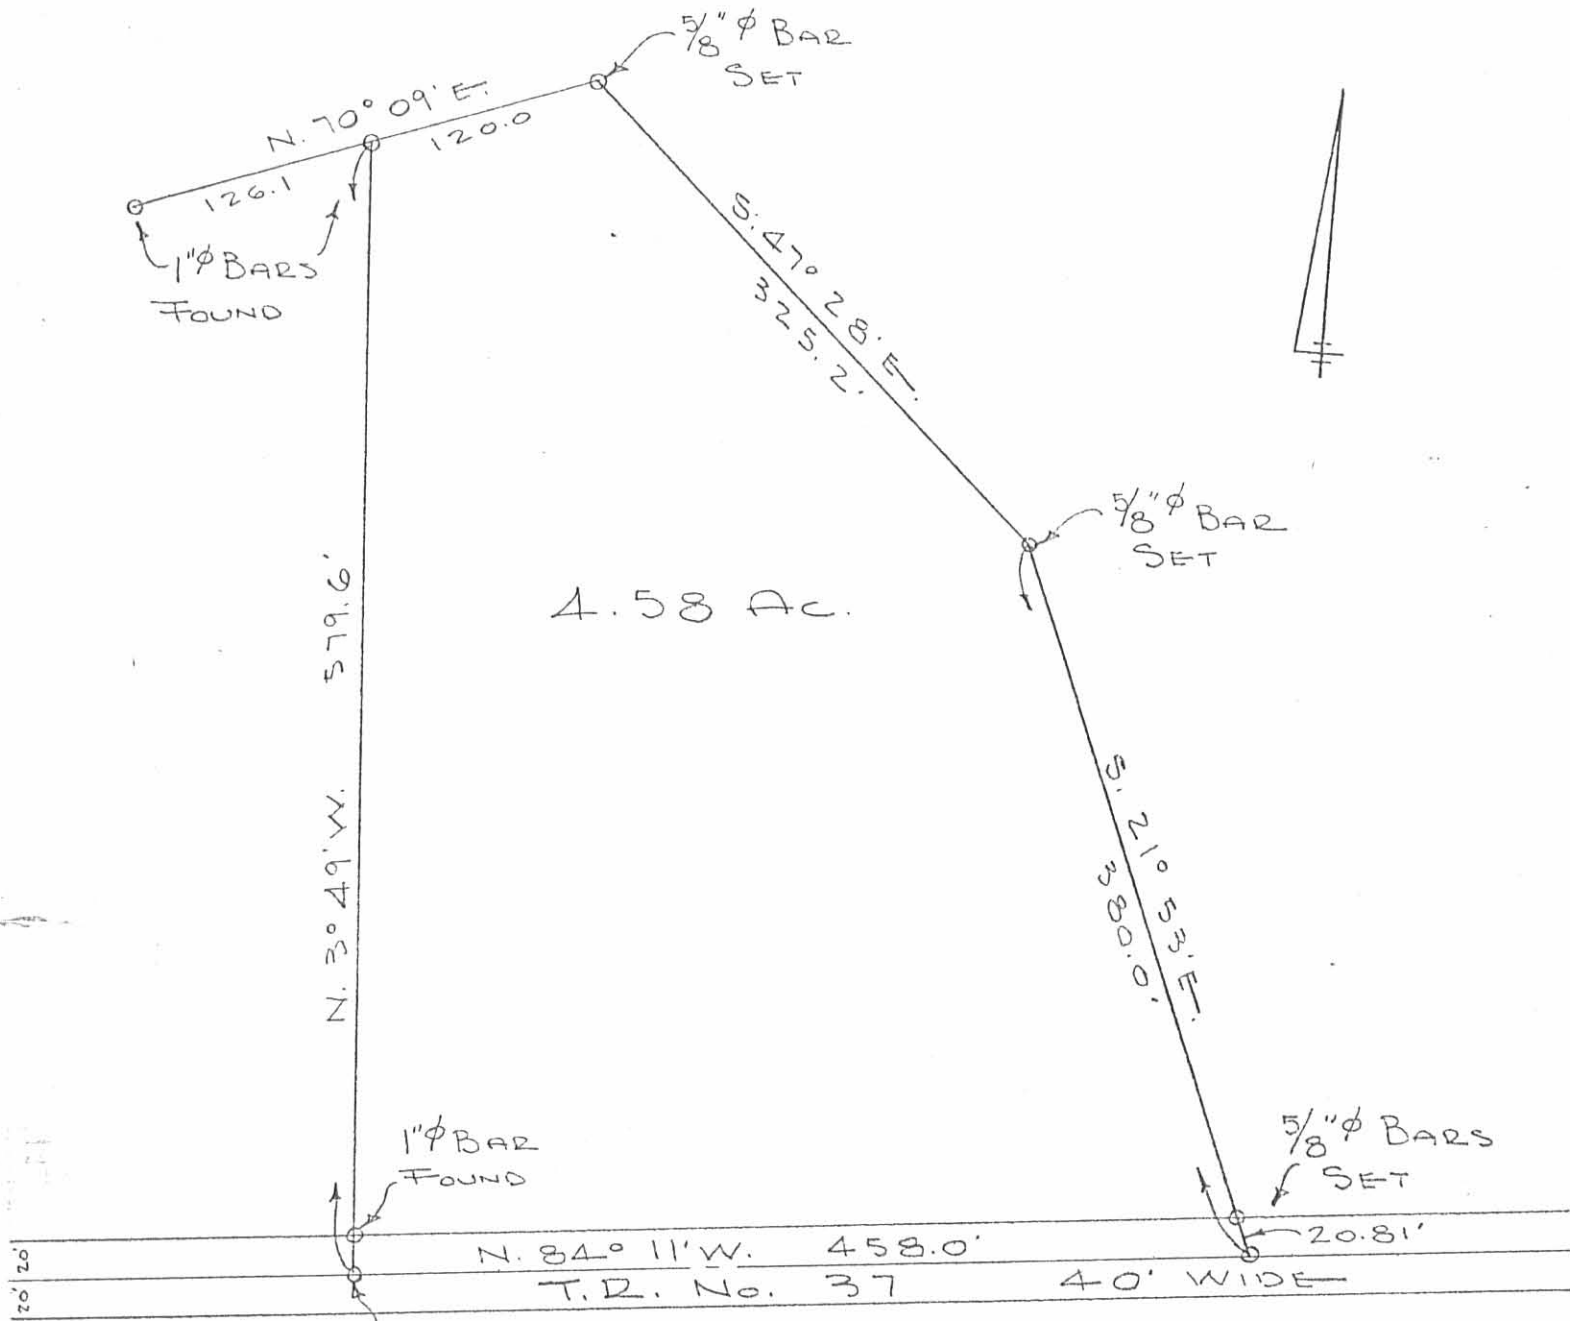

4.58 Ac.



3/4" ϕ BAR FOUND
 STA. 446+12.9
 FB. 687 Pg. 28

KAHL SURVEY
 V.M.S. 9907
 McARTHUR TWP.
 LOGAN COUNTY, O.
 MAY 18, 1968
 SCALE 1"=100'

DAN L. DODSON
 REG. SURVEYOR 4270
 BELLEFONTAINE, O.

(4276) IP
 Indexed On Map

ELLIOTT SURVEY

V.M.S 3320

RUN+CREEK TWP.


Dodson
Nichols

June 3, 1968

75°

78

R.R. Spk Found
48+23.85

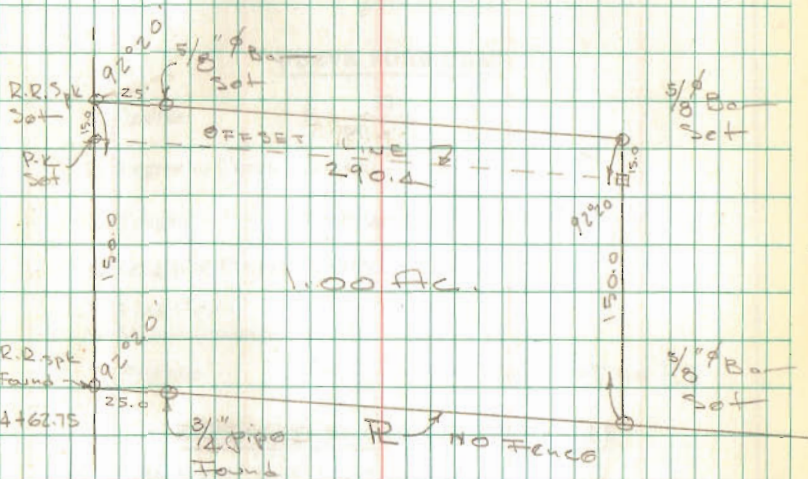

Joe D. Elliott

10.18 AC.

INDEXED ON MAP

4277