

May 5, 1971

The following described real estate, situated in the Township of McArthur, County of Logan, State of Ohio and being a part of Virginia Military Survey No. 10306 and being more particularly described as follows:

Beginning at a stone in the centerline of T. R. No. 57, said stone being the southeast corner to Nellie B. Rose's present 64.91 Acre tract and being in the Greenville Treaty Line and the line between McArthur and Harrison Townships;

Thence with the centerline of T. R. No. 57, (Greenville Treaty Line), S. 84° 30' W. 125.00 feet to a harrow tooth iron;

Thence N. 5° 15' W. 350.00 feet to an iron bar, passing through and iron bar at 30.00 feet;

Thence N. 83° 30' E. 125.00 feet to an iron bar set in the fence line between Rose and Lynn;

Thence with the line between Rose and Lynn, S. 5° 15' E. 352.10 feet to the place of beginning, containing 43,881.25 square feet or 1.007 Acres, more or less.

The above described real estate being surveyed out of the southeast corner of Nellie B. Rose's present 64.91 Acre tract.

I hereby certify that this is a true and accurate description of a survey made by me on May 1, 1971.

*Daniel E. Gilbert*  
Daniel E. Gilbert, P.S.  
Reg. Sur. No. 5402  
128 N. Madriver St.  
Bellefontaine, Ohio 43311


4777

ID



NELLIE B. ROSE

64.910 Ac.  
- 1.007 SURVEYED  
63.903 Ac.

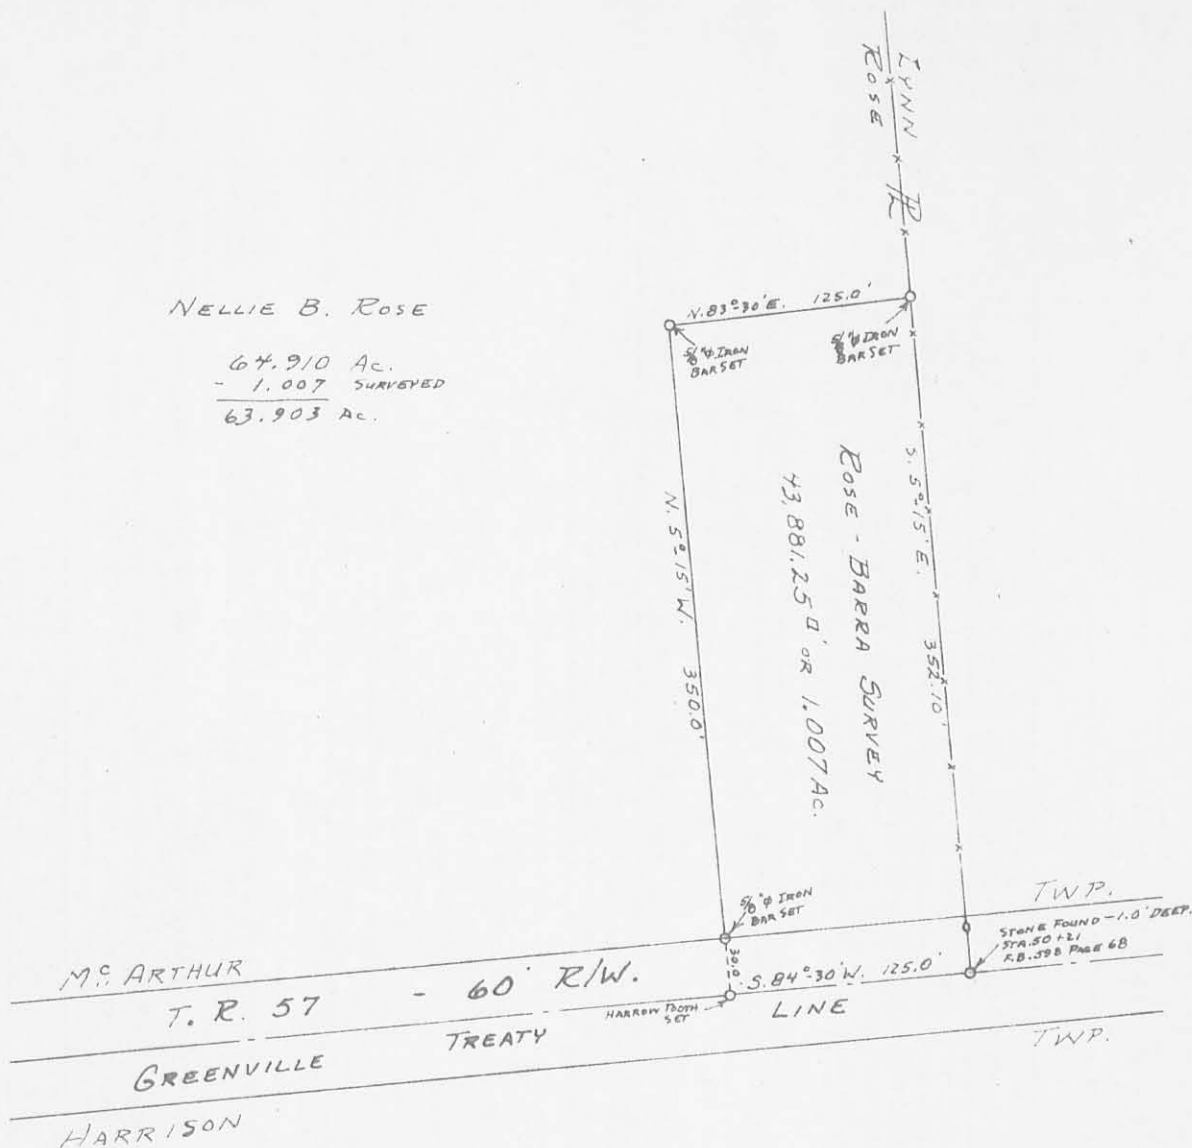

REFERENCE :

T. R. No. 57  
ENC. F. B. 598 PAGE 68

ROSE - BARRA SURVEY  
V. M. S. 10306  
M. S. ARTHUR TOWNSHIP  
LOGAN COUNTY, OHIO  
MAY 1, 1971

SURVEYED AND PLATTED BY:  
DANIEL E. GILBERT, P.S.  
REG. SUR. No. 5402  
428 N. MADRIVER ST.  
BALLEFONTAINE, OHIO 43311

SCALE: 1" = 100'

4777 IP

INDEXED ON MAP