

Glen Hurley Survey
May 31, 1980

The following described real estate situated in the Township of McArthur,
County of Logan, State of Ohio and being a part of Virginia Military Survey No.
9927 and being more particularly described as follows:

Beginning at a stone at the northeast corner to V. M. S. No. 9927;

Thence with the east line of V. M. S. No. 9927 (which is also the east right
of way line of T. R. No. 99) S. $7^{\circ} 00'$ E. 1,414.50 feet to an iron bar at the north-
east corner to Glen Hurley's present 140.00 Acre tract;

Thence with Hurley's north line, S. $82^{\circ} 38'$ W. 2,075.50 feet to an iron bar for
the true place of beginning for this description;

Thence continuing with Hurley's north line, S. $82^{\circ} 38'$ W. 1,250.00 feet to an
iron in the west line of V. M. S. No. 9927, passing through an iron at 89.10 feet;

Thence with the west line of V. M. S. No. 9927, S. $7^{\circ} 08'$ E. 1,238.50 feet to
an iron in the north right of way line of U. S. R. No. 33;

Thence with the north right of way line of U. S. R. No. 33, S. $67^{\circ} 05'$ E. 1,444.10
feet to an iron bar;

Thence N. $7^{\circ} 08'$ W. 1,966.66 feet to the place of beginning, passing through iron
bars at 742.26 feet and 1,886.46 feet, containing 45.988 Acres, more or less.

The above being surveyed off the west end of Glen E. and Edna M. Hurley's present
140.00 Acre tract as described in Deed Volume 361 Page 885 (1-15-1976).

I hereby certify that the above description is true and accurate according to
a survey made by me on May 31, 1980.

Daniel E. Gilbert

Daniel E. Gilbert, P.S.
Reg. Sur. No. 5402
1041 N. Main St.
Bellefontaine, Ohio 43311

10
5858

THOMAS E. HURLEY

113.95 Ac.

3325.50'
2075.50'

S. 82°-38' W.

N 82°-38' E

1160.75

1,250.00'

S. 7°-08' E.

1444.10'

GLEN E. HURLEY ETUX

140.000 Ac.

45.988

94.012 Ac.

45.988 Ac.
SURVEYED

V.M.S. 9927
V.M.S. 1276

EVAN SAEHLER ETC
116.069 Ac.

V.M.S. 9927

V.M.S. 9927

N. 7°-00' W.

I.R. No. 99



V.M.S. 12742
V.M.S. 12715

LAWRENCE SHIPP, JR
PAUL V. BONEZKY

V.M.S.
12350-13277
V.M.S. 9903-9925

1978.00'

STONE

V.M.S. 9927
1766

N 67°-05' W.
R/W

U.S. R. No. 33

1/2 Iron Bar Set

1/2 Iron Bar Set

1.40'

N. 82°-46' E.

2,060.00'

PAUL V. BONEZKY ETC
27.60 Ac.

ORIGINAL 140.00 Ac. SURVEYED 12-22-75
By D. K. SHIPK - No. 4271
SEE SURVEY INDEX No. 5858

GLEN HARLEY SURVEY
V.M.S. No. 9927
MS. ARTHUR TOWNSHIP
LOGAN COUNTY, OHIO
MAY 31, 1980

SCALE: 1" = 200'

IP
5858
INDEXED ON MAP

SURVEYED AND PLATED BY:
DANIEL E. GILBERT, P.S.
REG. SUR. No. 5402
1041 N. MAIN ST.
BELLEFONTAINE, OHIO 43311

Glenn Hurley Survey
December, 1975

Being situated in McArthur Township, Logan County, Ohio;
and being a part of V.M.S. 9927.

Beginning at a stone at the northeast corner of V.M.S. 9927.

Thence with the east line of V.M.S. 9927 (also the east right
of way line of Township Road 99) S $7^{\circ}-00'$ E 1414.5 feet to an
iron. Said iron is the true place of beginning for this description.

Thence S $82^{\circ}-38'$ W 3325.5 feet to an iron in the west line
of V.M.S. 9927.

Thence with the west line of V.M.S. 9927 S $7^{\circ}-08'$ E 1238.5
feet to an iron in the north right of way line of State Route 33.

Thence with the north right of way line of State Route 33
S $67^{\circ}-05'$ E 1456.5 feet to an iron.

Thence with the north line of a 27.60 acre tract, N $82^{\circ}-46'$ E
2060.0 feet to a stone in the east line of V.M.S. 9927.

Thence with the east line of V.M.S. 9927 (also the east
right of way line of Township Road 99) N $7^{\circ}-00'$ W 1978.0 feet to
the place of beginning.


Containing 140.00 acres more or less. Being surveyed from a
253.95 acre tract.

Owen K. Shirk
Surveyor 4271

2D
5858

INDEXED ON MAY

G. HURLEY SURVEY
 McARTHUR TWP., LOGAN CO., OHIO
 V.M.S. 9927 - 1" = 500'

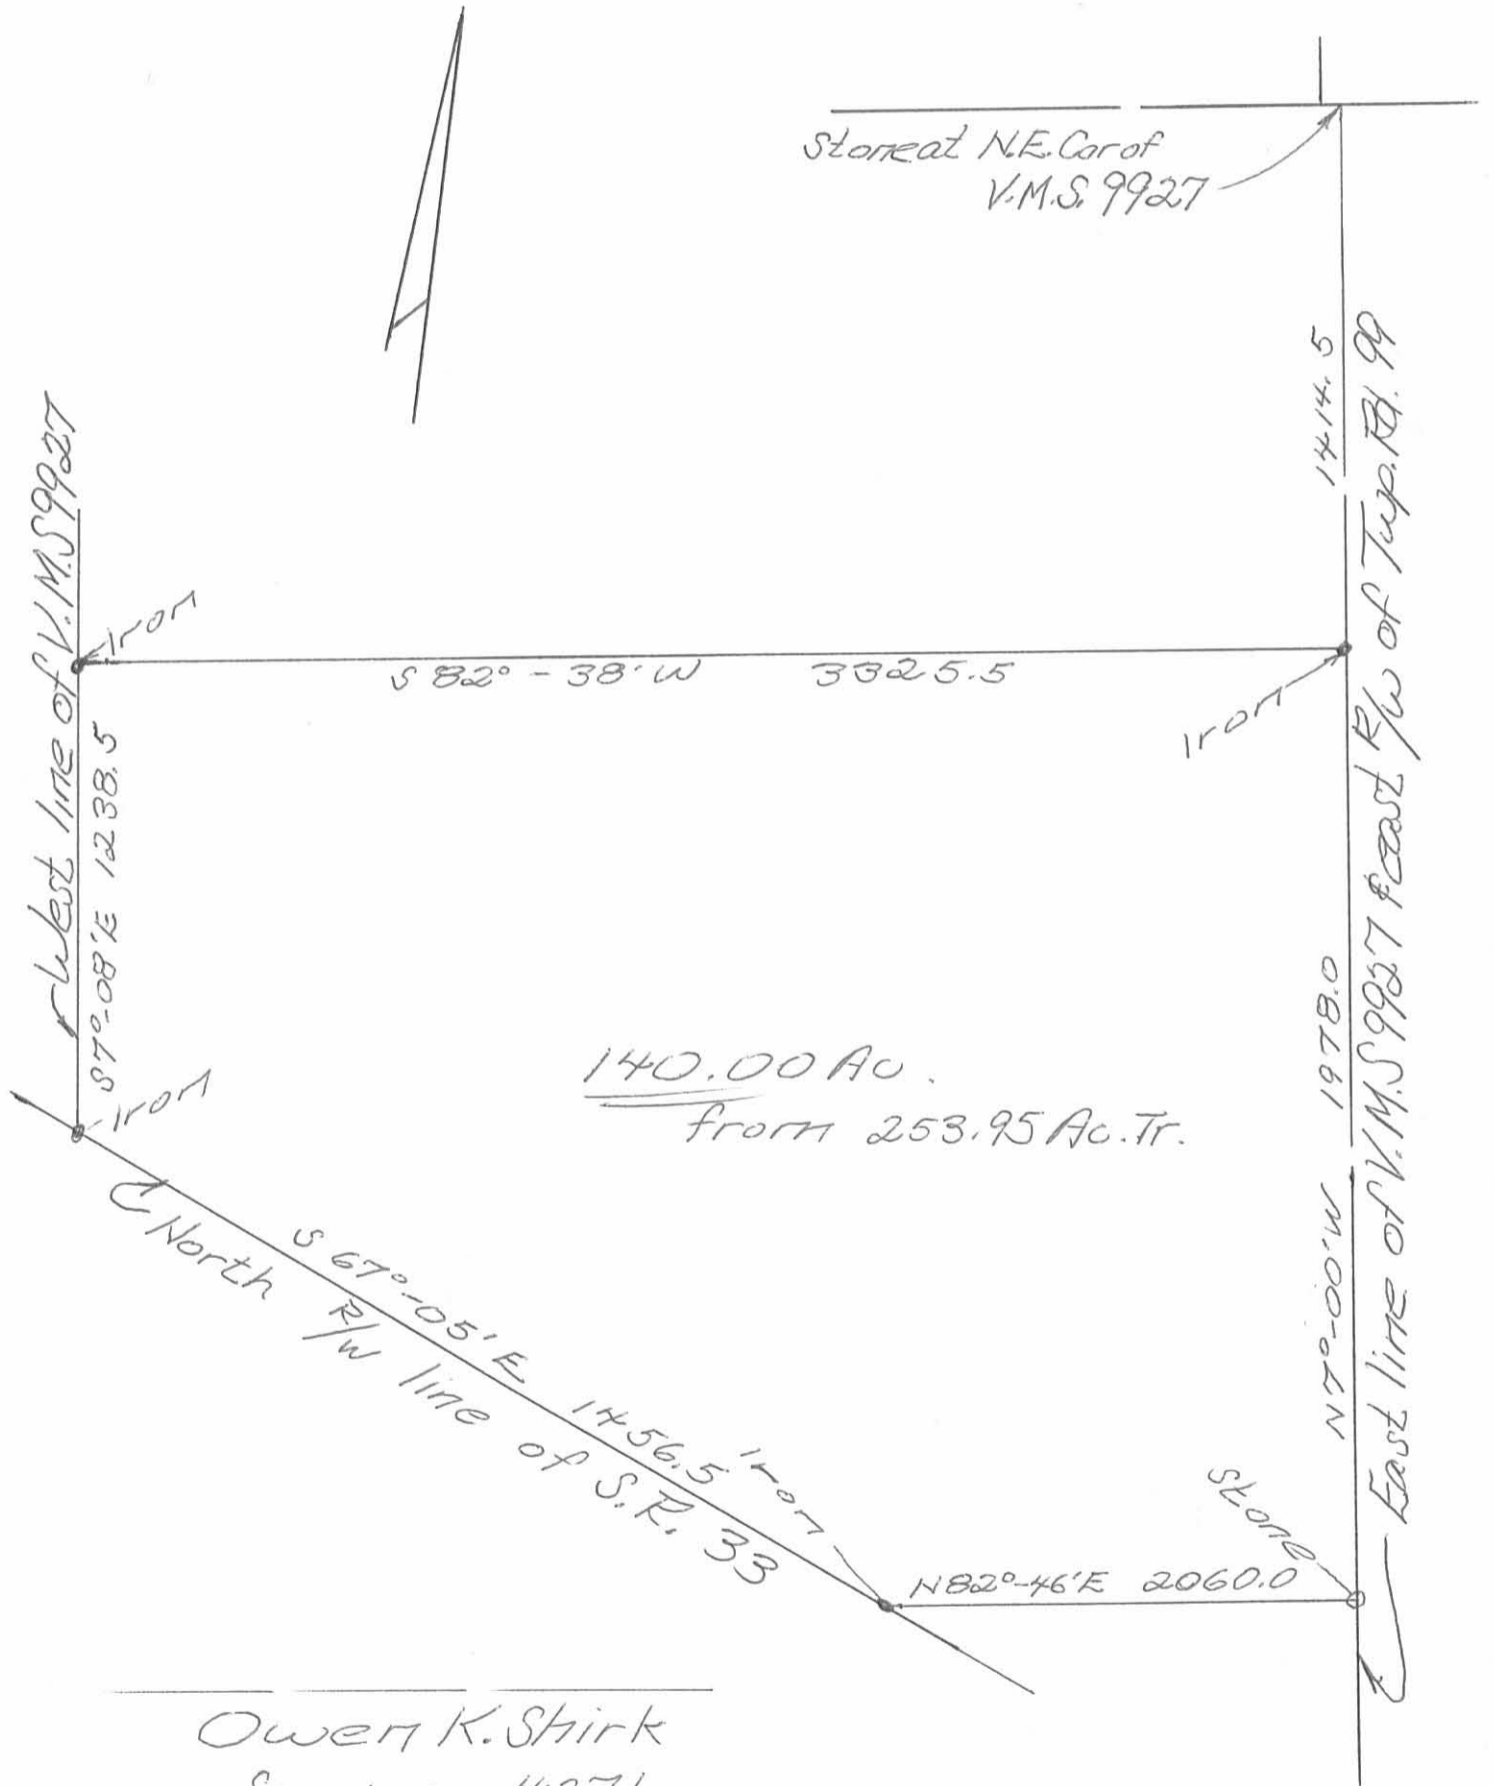

140.00 Ac.
 from 253.95 Ac. Tr.

Owen K. Shirk
 Surveyor 4271
 12-22-75

2P

5858