

(142)

last named corner, a stone and black oak, thence  
 S  $2^{\circ}$  W 163  $\frac{1}{2}$  poles to a stone and hickory in the south line  
 N  $3^{\circ}$  being at a stone and elm in the south  
 line 16 poles from the latter corner thence N  $2^{\circ}$  E 163  $\frac{1}{2}$   
 poles to a stone & white oak in the north line - then  
 dividing the west side into two equal lots of 79 acres  
 each & the east side into two of 77 acres each -  
 Solomon Thrasher }  
 Peter Provost } J. M. Marmion  
 C. S. L. C. S.


John Benders

13<sup>th</sup> March, 28<sup>th</sup> 1832

Survey No 179

(8267)

Surveyed 103 acres for John Benders beginning  
 at a red oak and two buck stumps in a line N.E. of Ropp's  
 house - thence with said line N  $78^{\circ}$  E 104 poles to a small sugar  
 tree - thence N  $2^{\circ}$  W 160 poles to an ash and white oak - thence  
 S  $78^{\circ}$  W, crossing the road from Bellefontaine to Detroit  
 at 22 poles) 102 poles to a sugar tree ash & buck corner to John  
 Piatt's 50 acres - thence  
 with the east line  
 S  $12^{\circ}$  E 160 poles (crossing the  
 aforesaid road at 108 poles)  
 to the beginning part of  
 Survey 9984 on Cherokee  
 - Mar's run

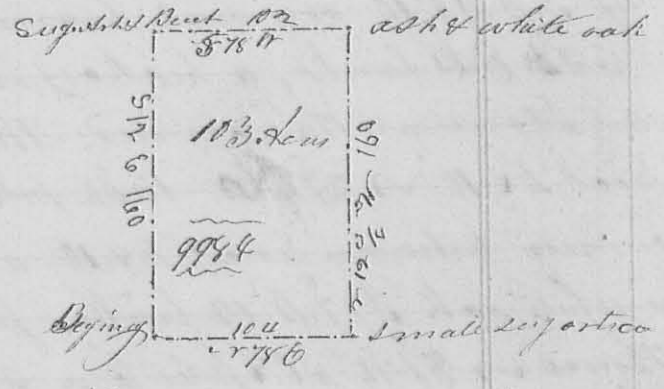

Ch. Lorenus Patrick }  
 Peter Beards } J. M. Marmion  
 C. S. L. C. S.

Survey No 180

Thomas Morquis } 4<sup>th</sup> Mo, April 16<sup>th</sup> 1832

(8268)

Survey the E<sup>h</sup> of sec. 1 Town. 2 Range 15<sup>th</sup> M<sup>h</sup> 1832  
 for Thomas Morquis; Beginning at the south corner of said  
 sec. an original corner tree a hickory standing & N  $57^{\circ}$  W 21 links  
 distant, the other tree is down there yet being some remains  
 thereof - thence with the south line of the sec. west 160 poles to  
 a stone marked a black oak N  $80^{\circ}$  E 9 links dist hickory N  $8^{\circ}$  W  
 43 links, a white oak S  $25^{\circ}$  E 48 links distant - thence north up  
 ing a branch at 116 poles or at 186 poles) 332 poles to a stone