


200  
INDEXED ON MAP

T. 3. R. 13.

MONUMENTS:  
No. 31 ~ Stone ~ 20 feet east and 20 feet north of Sec. Corner.  
No. 32 ~ Stone ~ On Qr. Sec. Line, 20 feet South of Co. Line

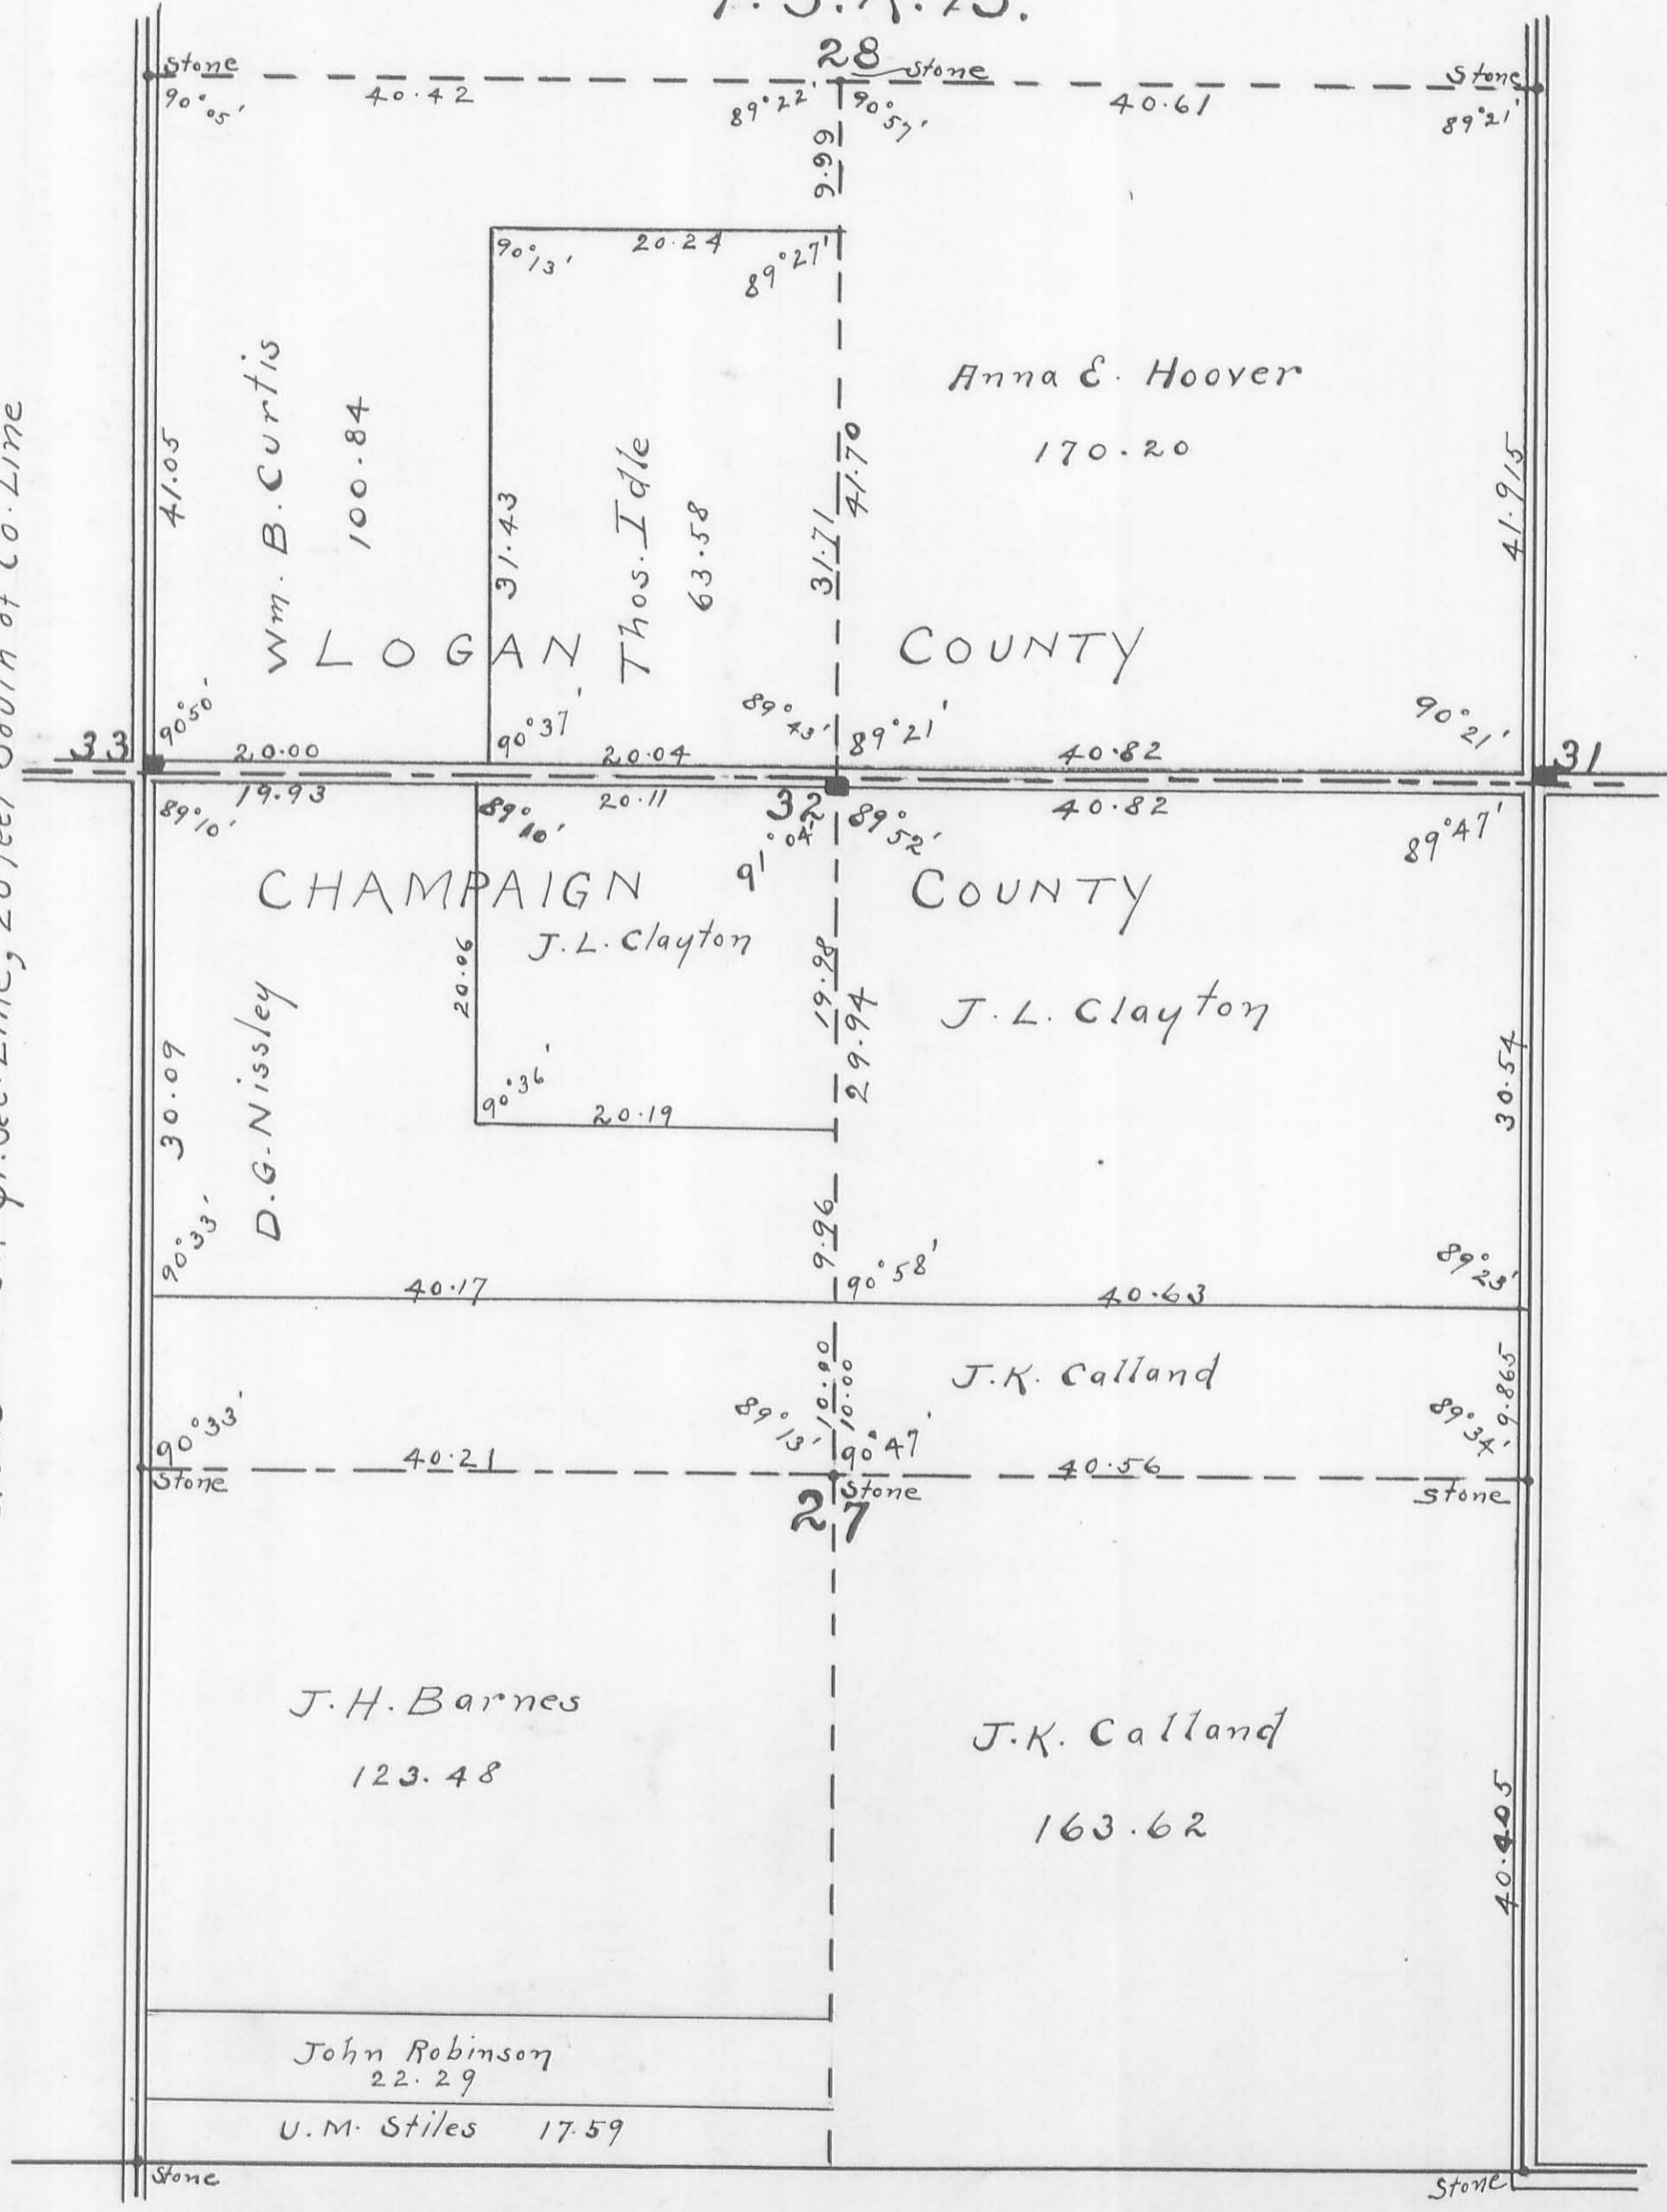

22 lines  
100 rods  
0 ft.