


946 1P

Secs. 28, 34, 35,
T. 3. R. 13,
Miami Township

Surv. Record "H", p 204
Oct. 1834

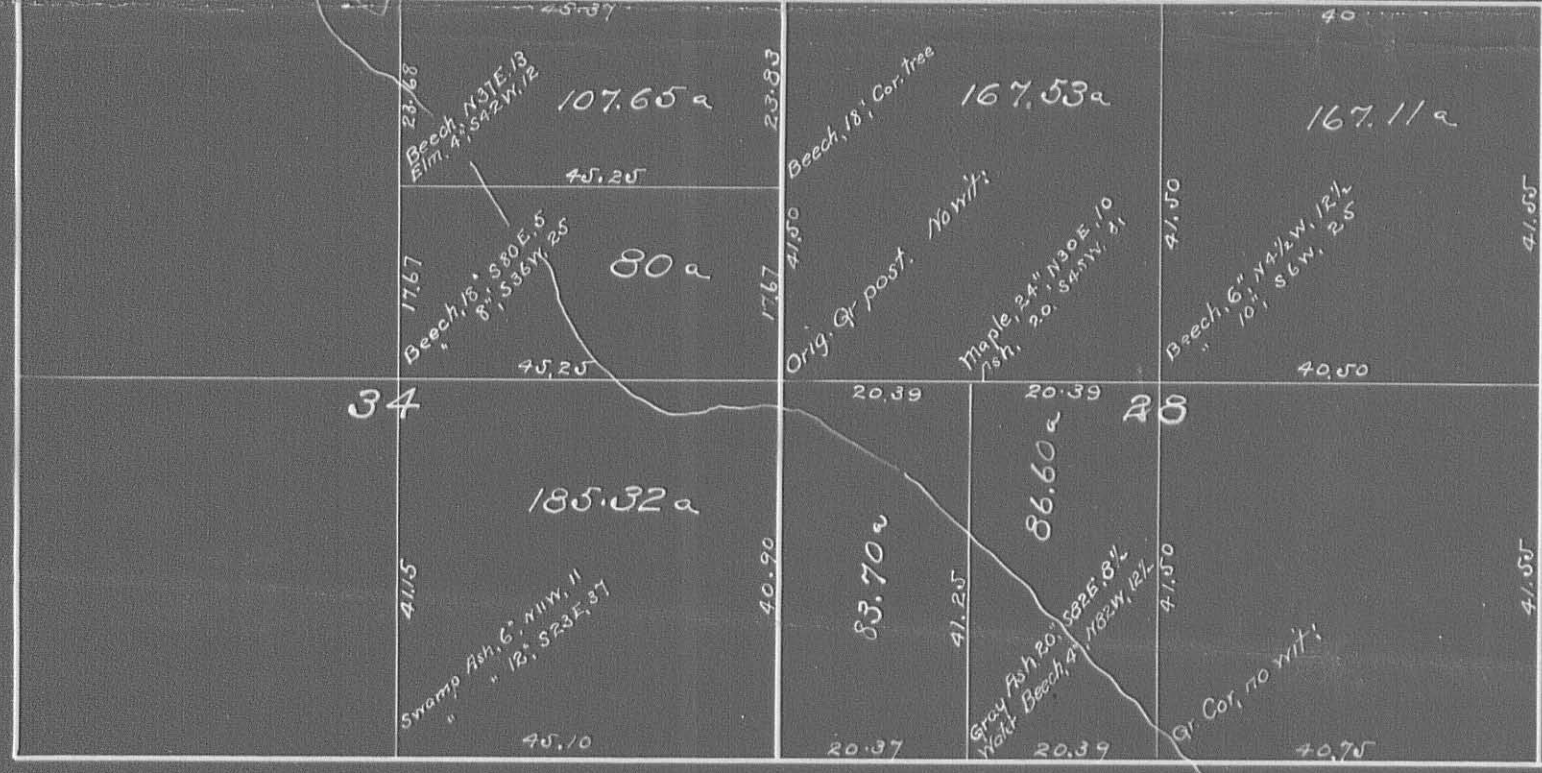

Elm, 4", S 55 W, 32
" 4", N 66 W, 91