


Road No. 19  
DeGraff To West Liberty

60' Road. Commissioners Journal 3 Page 61 Aug-1832  
 " " 6 " 71-162 1837  
 " " 7 " 80-139  
 " " 8 " 131

West Liberty - Logansville Pike 1868  
 Width not given

1519  
 INDEXED ON MAP

Dec. 1-1933  
 Clear-Nite Day 10  
 F. F. Wright  
 J. S. Crane  
 A. W. Rathfelder  
 W. B. Dugan  
 O. N. Mills

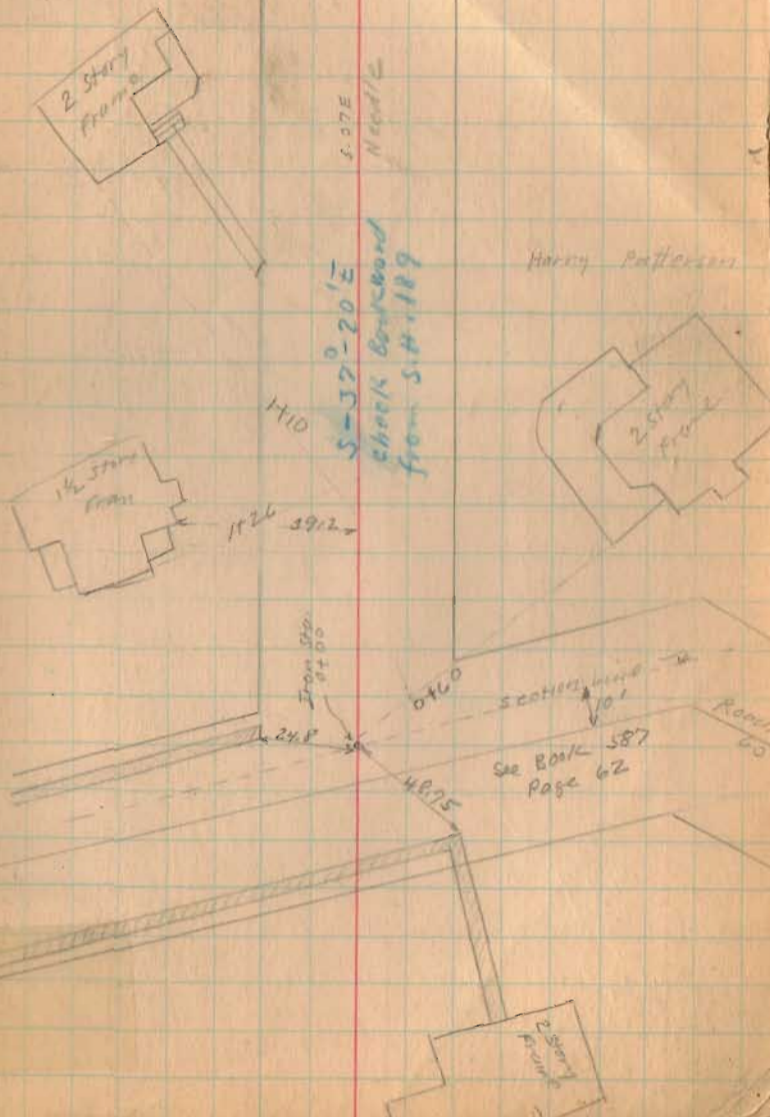

Road 19

INDEXED ON MAP

1519

5140 Monument

Monuments 30' from E

Both sides unless otherwise noted.

12-1-30 11



5140  
Iron Found.  
No. 11/12

Frank plots

Corporation  
DC Grant  
(Recorders  
Post 92)

Vol. A



Road 14

23+00

15+00

13+96.2

Mon set

1519

INDEXED ON MAP

12+00



12-1-33

12

23+46  
Iron Found  
No Angle  
Sub. B. D  
P. 11

Stone & Iron  
Found

705.6

No Angle

Elizabeth Crowley

15+84.3  
018.78

Frank Platts

519-27 E

Minnie D. Reapp

Road 65

SWW  
Road 14

Harry  
Patterson

Iron  
15+84.3  
No Angle

13+96.3  
Iron Placed  
17° 53' Right

30.38 20.38

Road 14

53+00

47+09

42+32.7


37+00

32+20

29+69.72

1519

INDEXED ON MAP

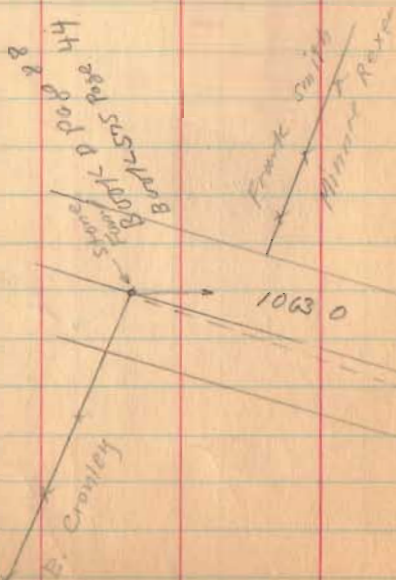

183

12-1-23  
S 25-48 E  
S 25-E  
Road 14

Iron  
47+09  
2°-30 left

Iron  
42+32.7  
22°-06 Right



Frank Smith

27+75

Minnie Rexer

S 45-24 E

S 45-E  
NO. 25

27+75

Chas. Notakine  
27+75  
Minnie Rexer

5' sugar

Iron  
32+20  
25°-51 left



S. 22 1/2 E under

of Road 2 No. 25

section

14-5

30.79

30.79

30+08  
Iron  
No. Right

29+69.72

Road 14

62+24.7

57+02

1519

INDEXED ON MAP

Li. Knick  
28+01  
Chas. Notstine

305-MS  
22-20-05  
20-20


12-30

1/4

Iron  
62+24.7 left  
11-29

47.25  
29.70


Yard Fence  
61+99

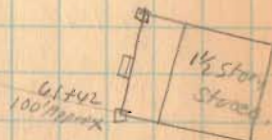

S 35-01E

26+40

Silo

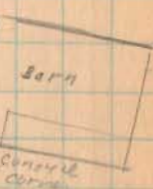

57+49

01 30

Chas. Notstine

x x x x x 58+10  
Frank Smith

Iron  
57+02  
9-13 left

41.3

corner post

x x x 54+30

Road, 14

81+70

76+00


71+00

66+00

1519  
INDEXED ON MAP

12-1-55

25

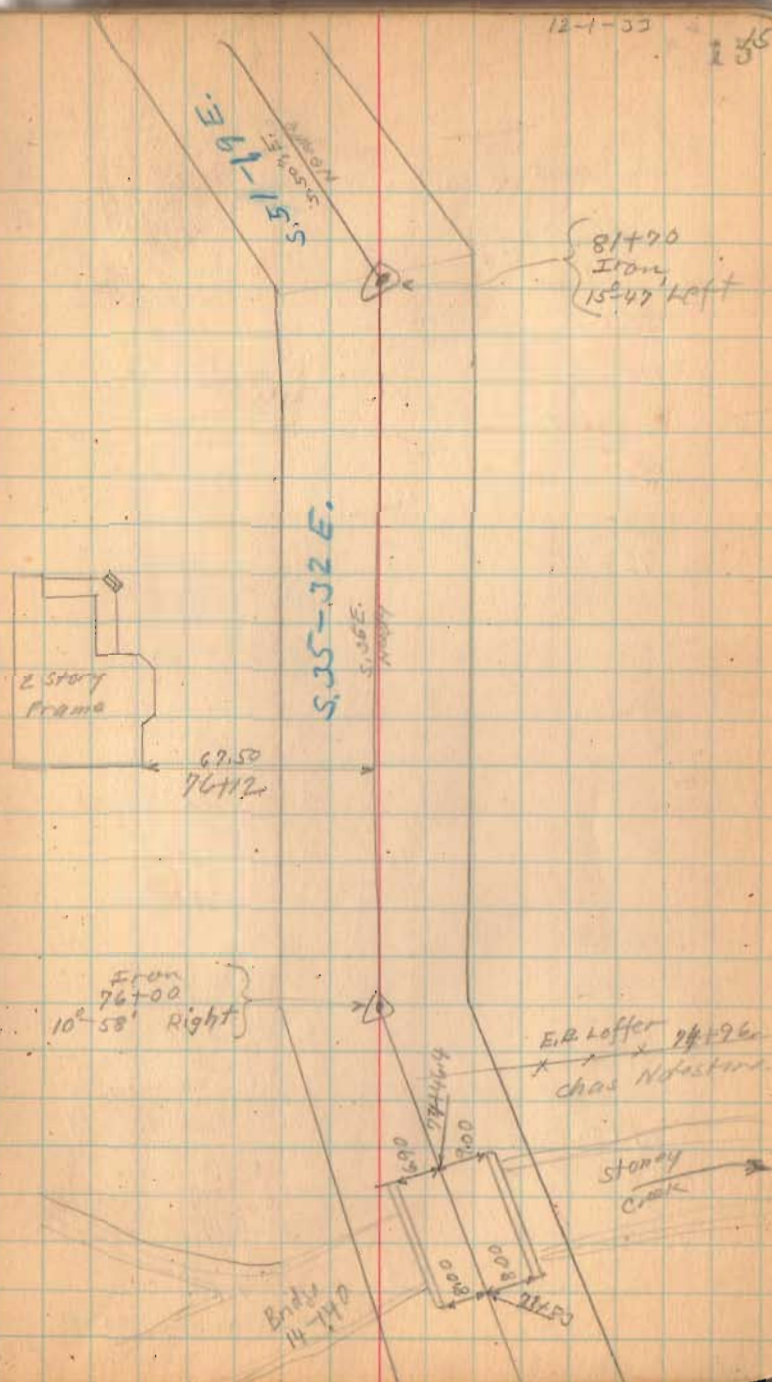

Road 14

107+00

101+35

99+50

92+00

85+50.6

1519

INDEXED ON MAP

Iron  
101+35  
5=45' Right





12-1-33

J. A. Simpson

Saml. Smith



Saml. Smith  
97+21  
Geo. Ocker

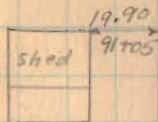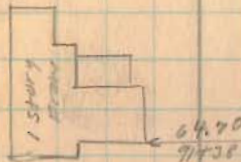

S. 52-59 E.

sec. 35

Geo. Ocker

U. Hinkley

sec. 5

S. D. E.  
North

T. 4 R. 12

Saml. Smith

Iron

85+50.6

1 1/2 story  
E. B. Koffer

T. 3 R. 13

Road 14

128+00

124+00

118+00

116+00

112+00

110+00

INDEXED MAP

1519

12-1-33 17/1

N.W. Life Ins. Co.  
x 125+29.5 x  
H.D. Stewart

122+18  
Lot 4  
122+00

Bridge No.  
14-2120

Homer Walker  
& Estor Co.

116+73

Saml. Smith

Stone found  
Plaid Brick  
on top  
116+73  
No Angle

117+20.9  
116+98.7  
115+90

A.O. Stewart

Road 62  
Stutz Pike

Mary M. Terrel

S 84-57E

115+90

111+61  
37-43 left  
R/W MONUMENT  
STA. 111+61





Road, 14

178+00

172+00

167+00

161+00

155+00

FO. RIGHT ONLY

1519  
INDEXED ON MAP

Ralph Atkinson

x x x 162+97

James Tamplin



169+86  
stone  
No. 111/2

Lena Harwick

stone  
road

A. & E. Holly Doss

25-30

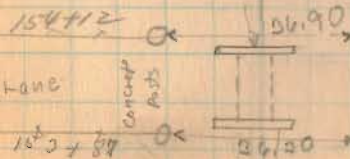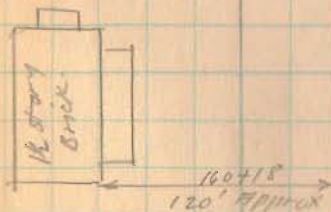

Road 14

198+00

192+00

184+50

182+00

1519  
INDEXED ON MAP

22270  
21.12  
24920  
22371  
20.75

Sec 23-4-13


Z (No Fence)

Sec. 2874R13

Sec. 29-4-13

X 193+04 X  
LANE  
X 192+84 X

M. M. Huber  
X X 186+01  
H. & D. Royer

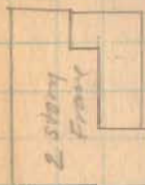

H. & D. Royer

Road 31

Ralph Atkinson

Sec. 22-4-13 20

C. & M. Mohr

196459

H. & D. Royer

Sec. 28-4-13

S. 84 7/8 N 85-17E

From  
183+24  
6'-05" Right

H. & D. Royer

Road 31

183+24

LENA HORNER

Road 17.

224+00

222+00

216+00

211+00

209+00

204+00

1519  
INDEXED ON MAP

224+76

Lane



2 story  
Frame

150' 4"

224+75

From

02-09-199

223+08.7

585-01 E

584-52 E

58 E  
Handle

Dec. 4 1933

Foggy

Wright

Croft

21

Chas. Croft

223+24

Road 202

222+85

217+22

Lane

217+04

H.D. Near

209+95

Road 202

M. & M. Huber

2020

Cor. Caprock stand  
in concrete  
for triangular  
historic  
Mason to  
center of  
Caprock

Point Workman

C. & M. Huber

Square

1.0m

209+95

02-25-1911

02-25

02-25

99.00

201+14

2 story  
Frame

Road 14

250+00

249+00

244+00

237+00

Right Only

236+81.4

Left Only

236+00

Right Only

230+00

INDEXED ON MAP  
1519

12-4-32 22  
22

D.S. Voder

Road No 201.  
249+70



1 story  
Frame

W.L. Plank

245+26

H.R. Weer

63100

5560  
249+47

S.B. Plank

249+20

Stone found

0°-32'

Right

S. 85-06 E.  
S. 85-08 E.

110+95  
242+12



2 story  
Frame

Stone found  
236+81.4  
0°-09' left

Chas. Mohandass

236+83

Chas. Mohandass

8919  
226+13

2 story  
Frame

Road 14

269+00

263+00

259+00

1519  
INDEXED ON MAP

Iron  
263+39  
0.25' Right

584-41E

20.5

To Hole

12-4-33

23

23

J.M. Hand

J.I. Veder

2 Story  
Frame

47.30

262+02

20.45  
261+31

20.85  
260+43

258+57  
Hole

J.I. Veder

252+41

SIB. plank

1/2 story  
Frame

61.30

251+47

Road 1A

278+00

277+00

270+00

1519  
INDEXED ON MAP

M. Holzman  
x 277+99.6 x  
Dis. Yoder

270+94  
Lane  
270+97

S 85-11 E

S. 84 1/2  
West

12-4-33

24  
2 1/2

Hugh Newell

x 277+58  
O.M. Newell

Stanford  
02-31 left  
277+39.6

162.90  
277+94

2 story  
Frame

Drill

273+26

20'

20.6

267+27

Cometery

S. 84 1/2  
West

261.0

269+93

Road 14

304+00

296+00

291+00

285+00

1519  
INDEXED ON

12-4-33

25  
25

585-42E

585 1/2 E  
North

Frank Hayes

Road 18

E. Magdon

205+36  
Stone found  
placed stone  
on top.  
0° 30' left

Mary A. Brown

Road 18

Hugh & Newell

63.35  
299+00



E. Magdon

x 296+32 1/2

M. Holyman

283+61

x lane

x 283+41



Road 14

338+00

332+00

331+00

325+00

318+00

309+00

INDEXED ON MAP  
1579

12-4-37

26  
26

Luther Horn

x x x x  
339+45  
H.J. Yoder



A. J. Yoder

x x x 331+68.7  
L.M. Hayes

Iron Pipe Found  
0° 04' Right  
331+68.7



L.M. Hayes

x x x x  
Front Hayes

318+30s  
Iron Pipe Found  
No Angle

Road 14

365+00

359+00

356+00

350+00

345+00

1519  
INDEXED ON MAP

12-4-33 27  
27

S. 84-47 E.  
S. 24 E.  
N. 40 W.

0°-51' Right  
356+49.6  
Found stake  
found stone  
& brick  
with Voder

Road 187

with Hog

358+62 Z  
Paul D. Yoder

90.75  
357+81  
Walmart  
Store  
No. 1895

184.8  
with not right  
J.H.H. 7/24/40

356+99 Road 187  
(Girard Pike)

Math. R. Brown  
old school  
lot.

354+82 Z

28.9  
340+41

25000  
Egan

Road 14

409+00

403+00

396+00

390+00

383+16.7 Top Line

377+00

372+00

INDEXED OF  
1519


W. H. Yoder  
Road 32  
409+00  
L. H. Yoder  
Stone Found  
403+30

409+00 12-4-33  
Stone Found  
0-10' left  
Lee M. Yoder  
403+30  
Paul D. Yoder

387+14

Lane

380+83

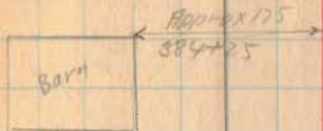

x 383+61

Lane

x 382+38

584-18E

383+16.7  
Square Stone  
29 Right

LIBERTY

N. 4° 45' E. 383+16.7

ROAD

UNION

88°-50'

TOWNSHIP

TOWNSHIP



Road 14

428+00

422+00

417+00

411+00

Dec. 5, 1933

NOT Cold

Wright


Crane

Dugan

Mills

Rathfelder

279

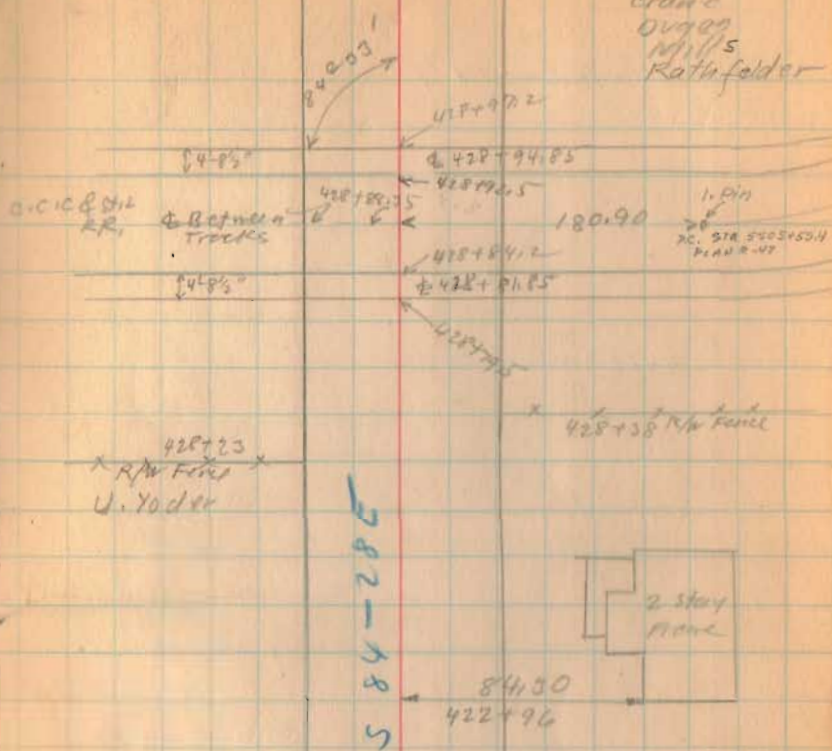

Road 14

441100


439100

431700

1519  
INDEXED ON MAP

12-5-33

380

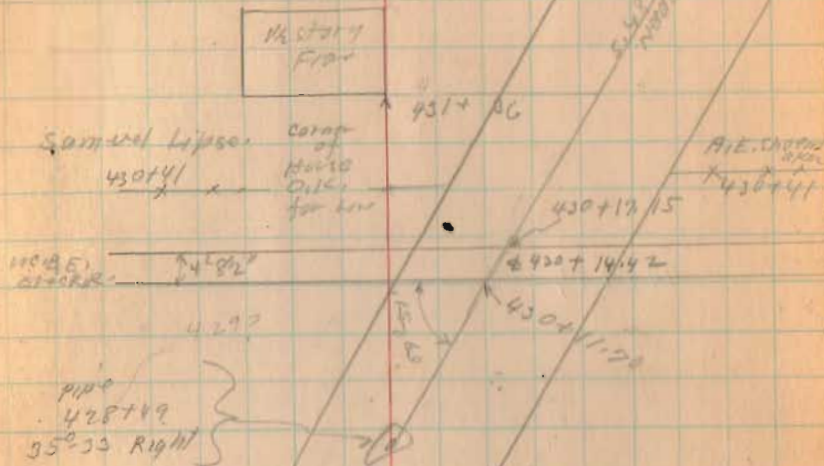






479+00


476+00

471+12.3

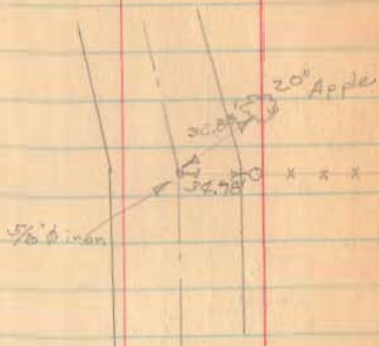

468+00

463+64.5

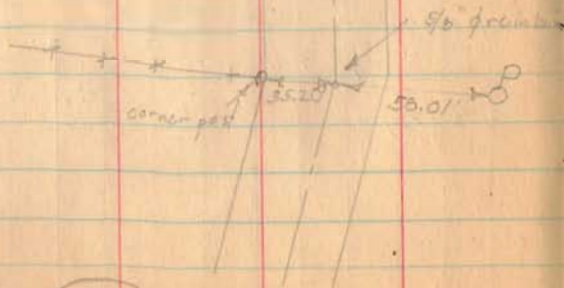

1519  
INDEXED ON MAP

12-5-30 383

Ed. 5/8" iron  
19 July 1968

Iron  
471+12.3  
5' 4 1/2" left

D.B. Vader  
11 3/4" W. Noddy  
Bessie McElliot

S. 28°-06' E  
5.27 E.  
Noddy

A.F. Hafinzer  
Bessie McElliot  
5' 6 1/2" E


Iron  
463+64.5  
3' 4 1/2" left

Ed. 19 July 1968  
5/8" iron bar (top part)

S. 24°-19' E



Road 14

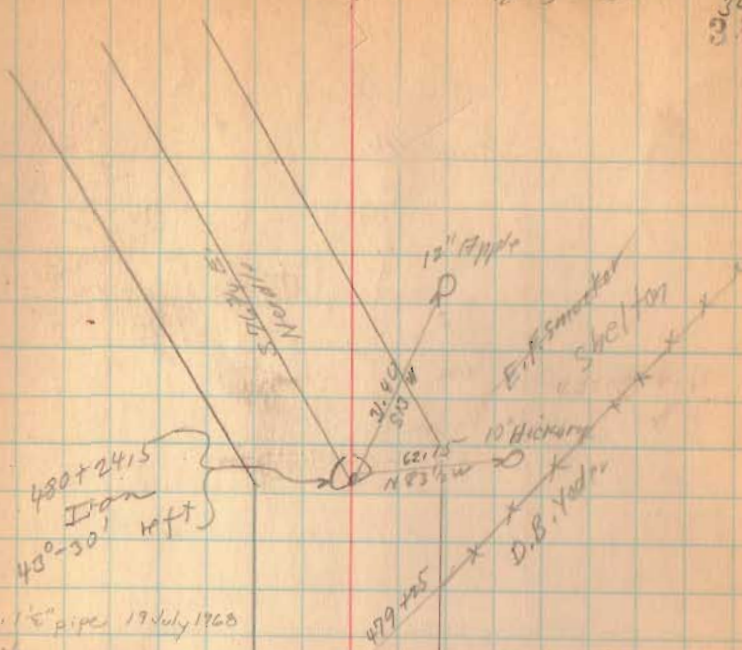


Ed. 1 1/2" pipe 19 July 1968  
C.M.


1519  
INDEXED ON MAP






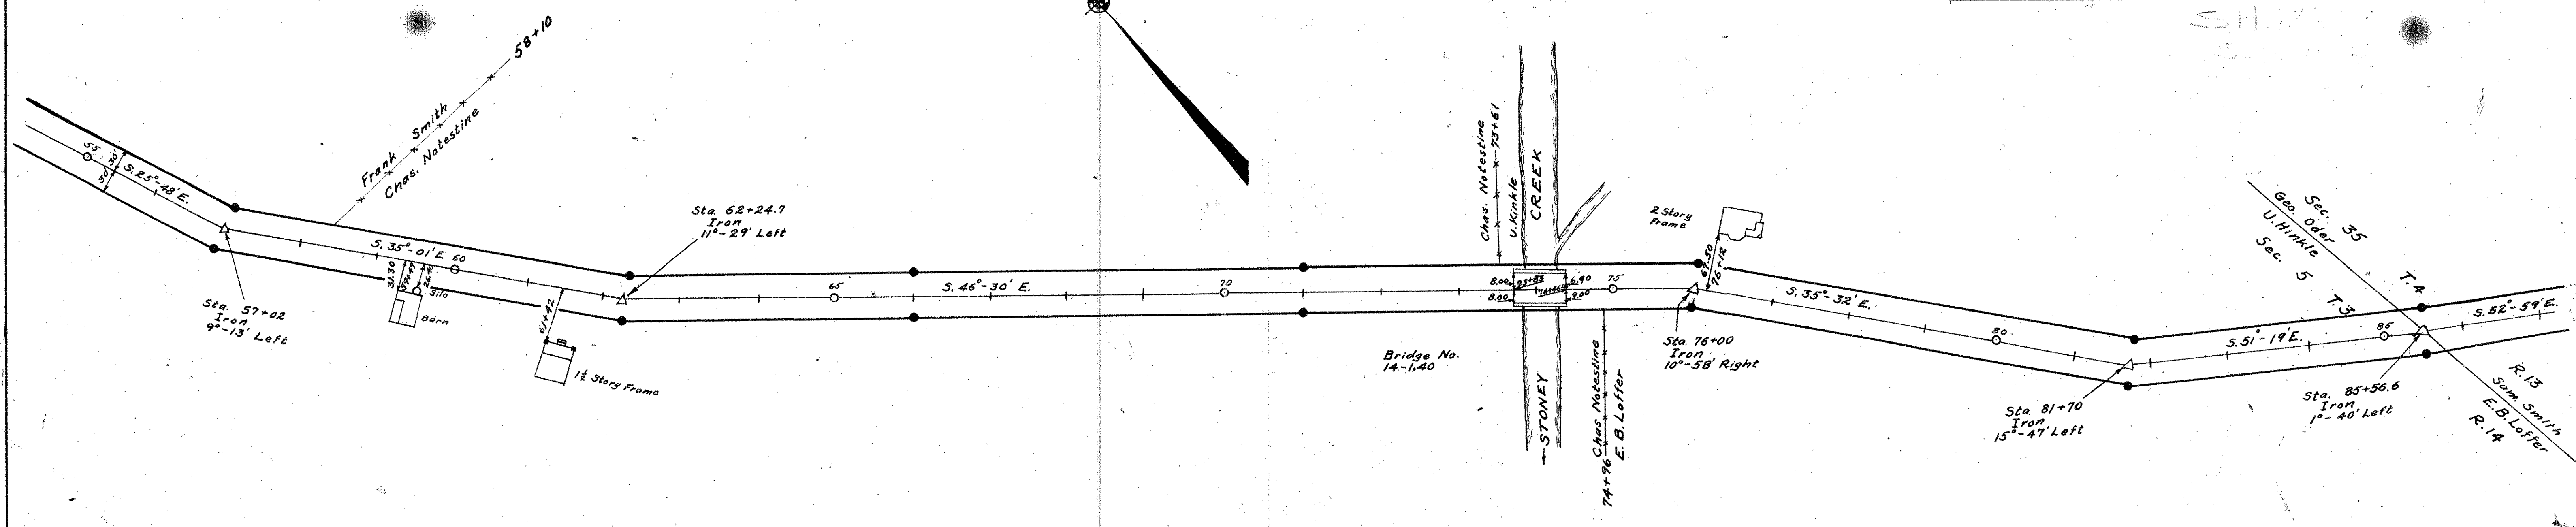


See Sheet No. 1 for Right-of-Way Record  
 Concrete R/W Posts set as shown  
 Field Notes Logan County Surveyor's Book 582

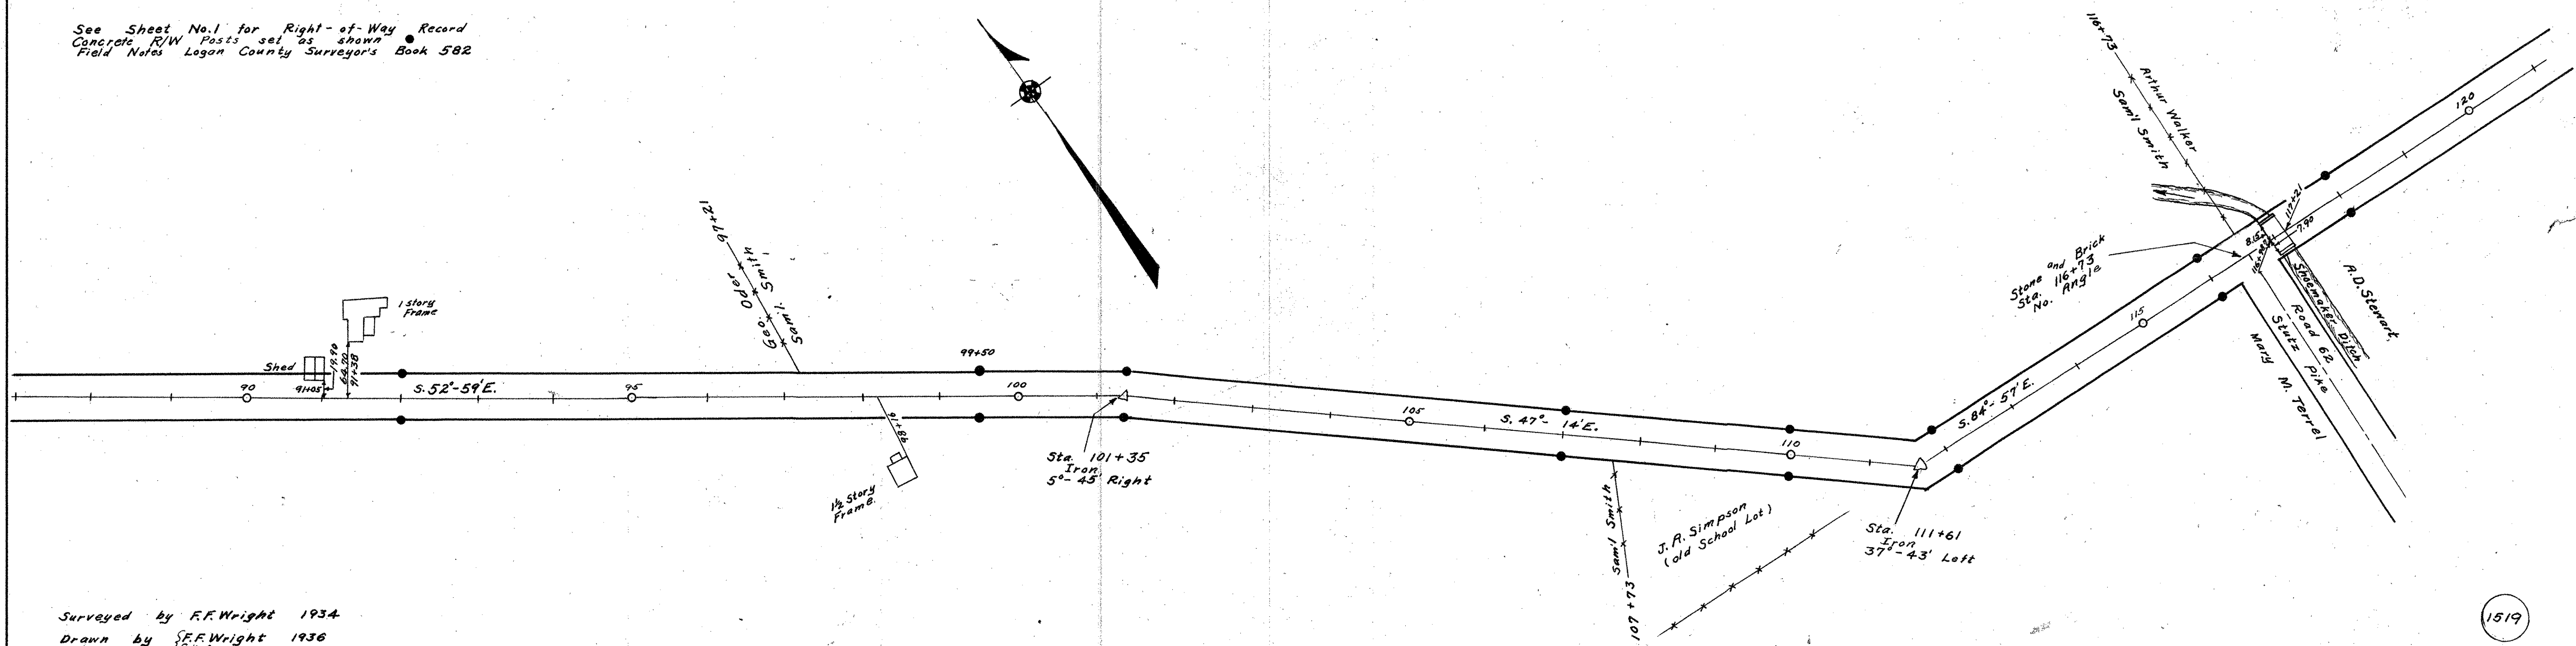


Surveyed by F.F. Wright 1934  
 Drawn by S.F. Wright 1936

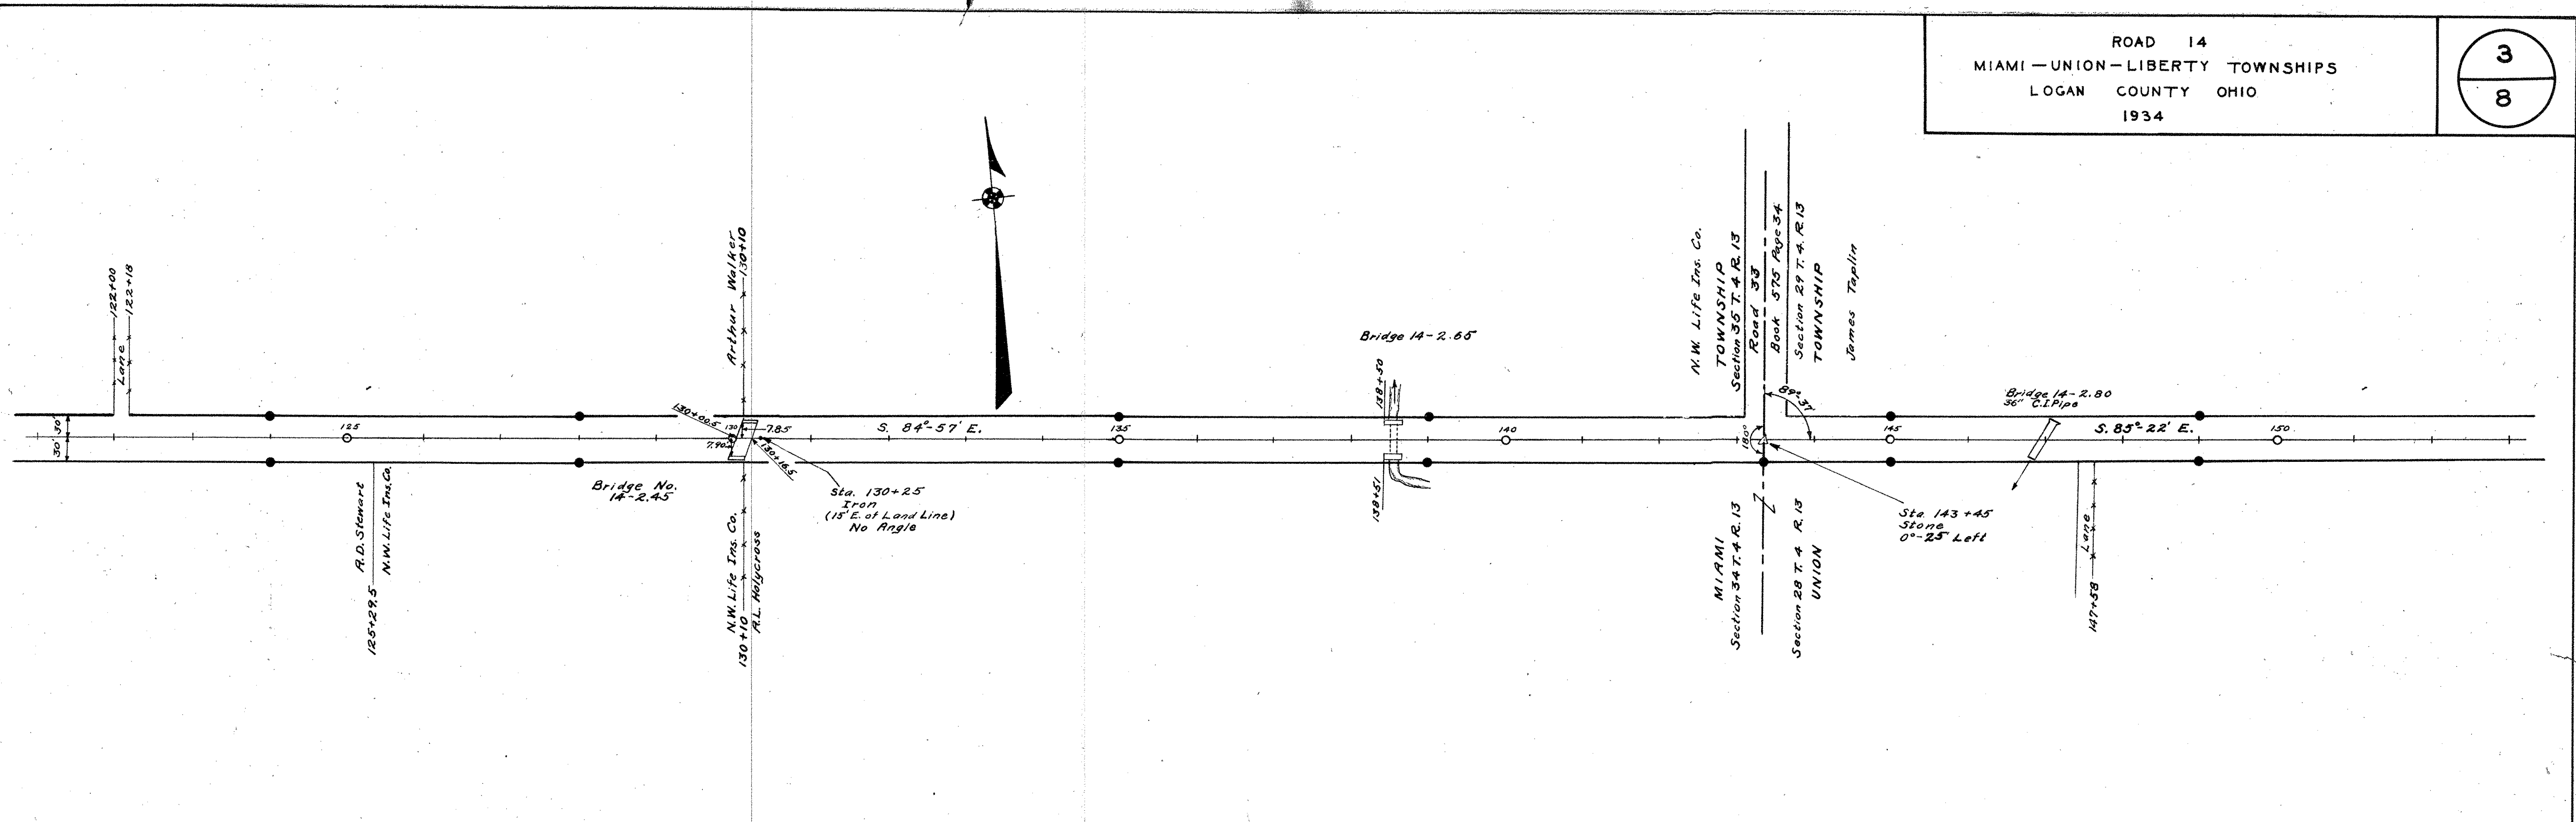


See Sheet No. 1. for R/W record  
 Concrete R/W posts set as shown  
 Field notes Logan County Surveyors Book 582

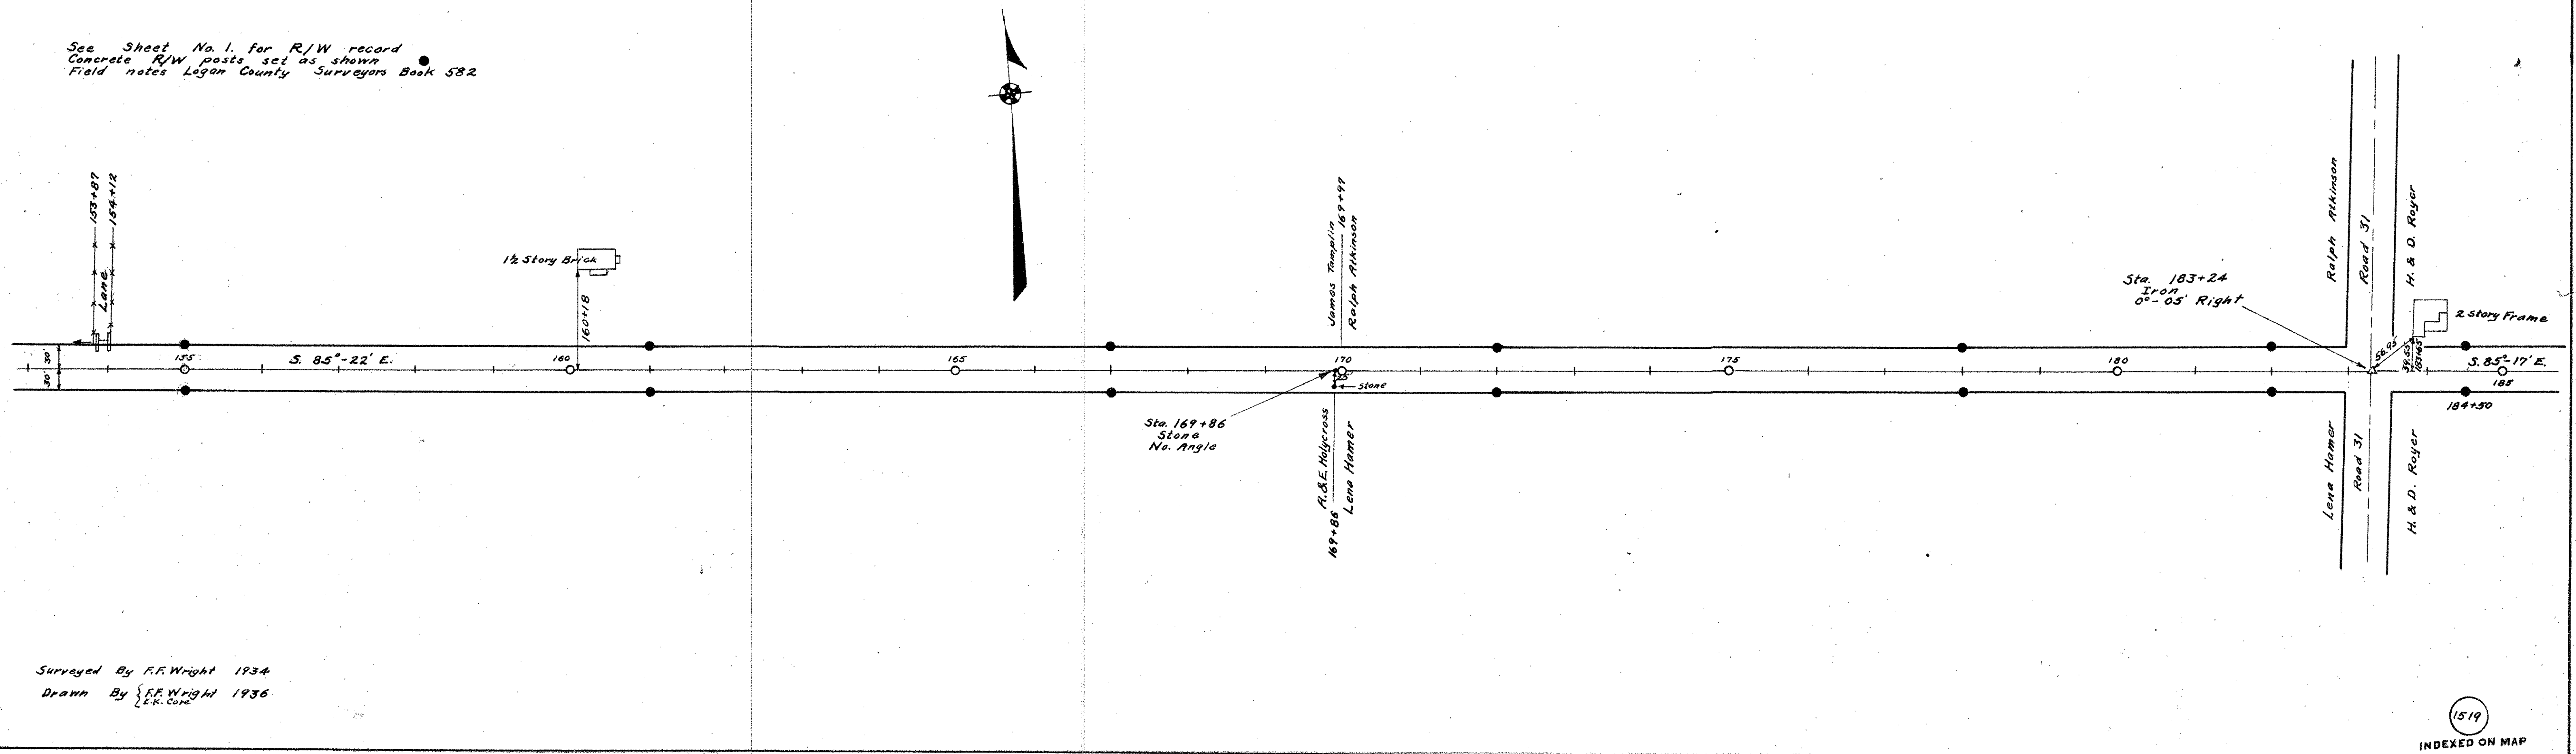



Surveyed By F.F. Wright 1934  
 Drawn By F.F. Wright 1936  
 G.W. Coe

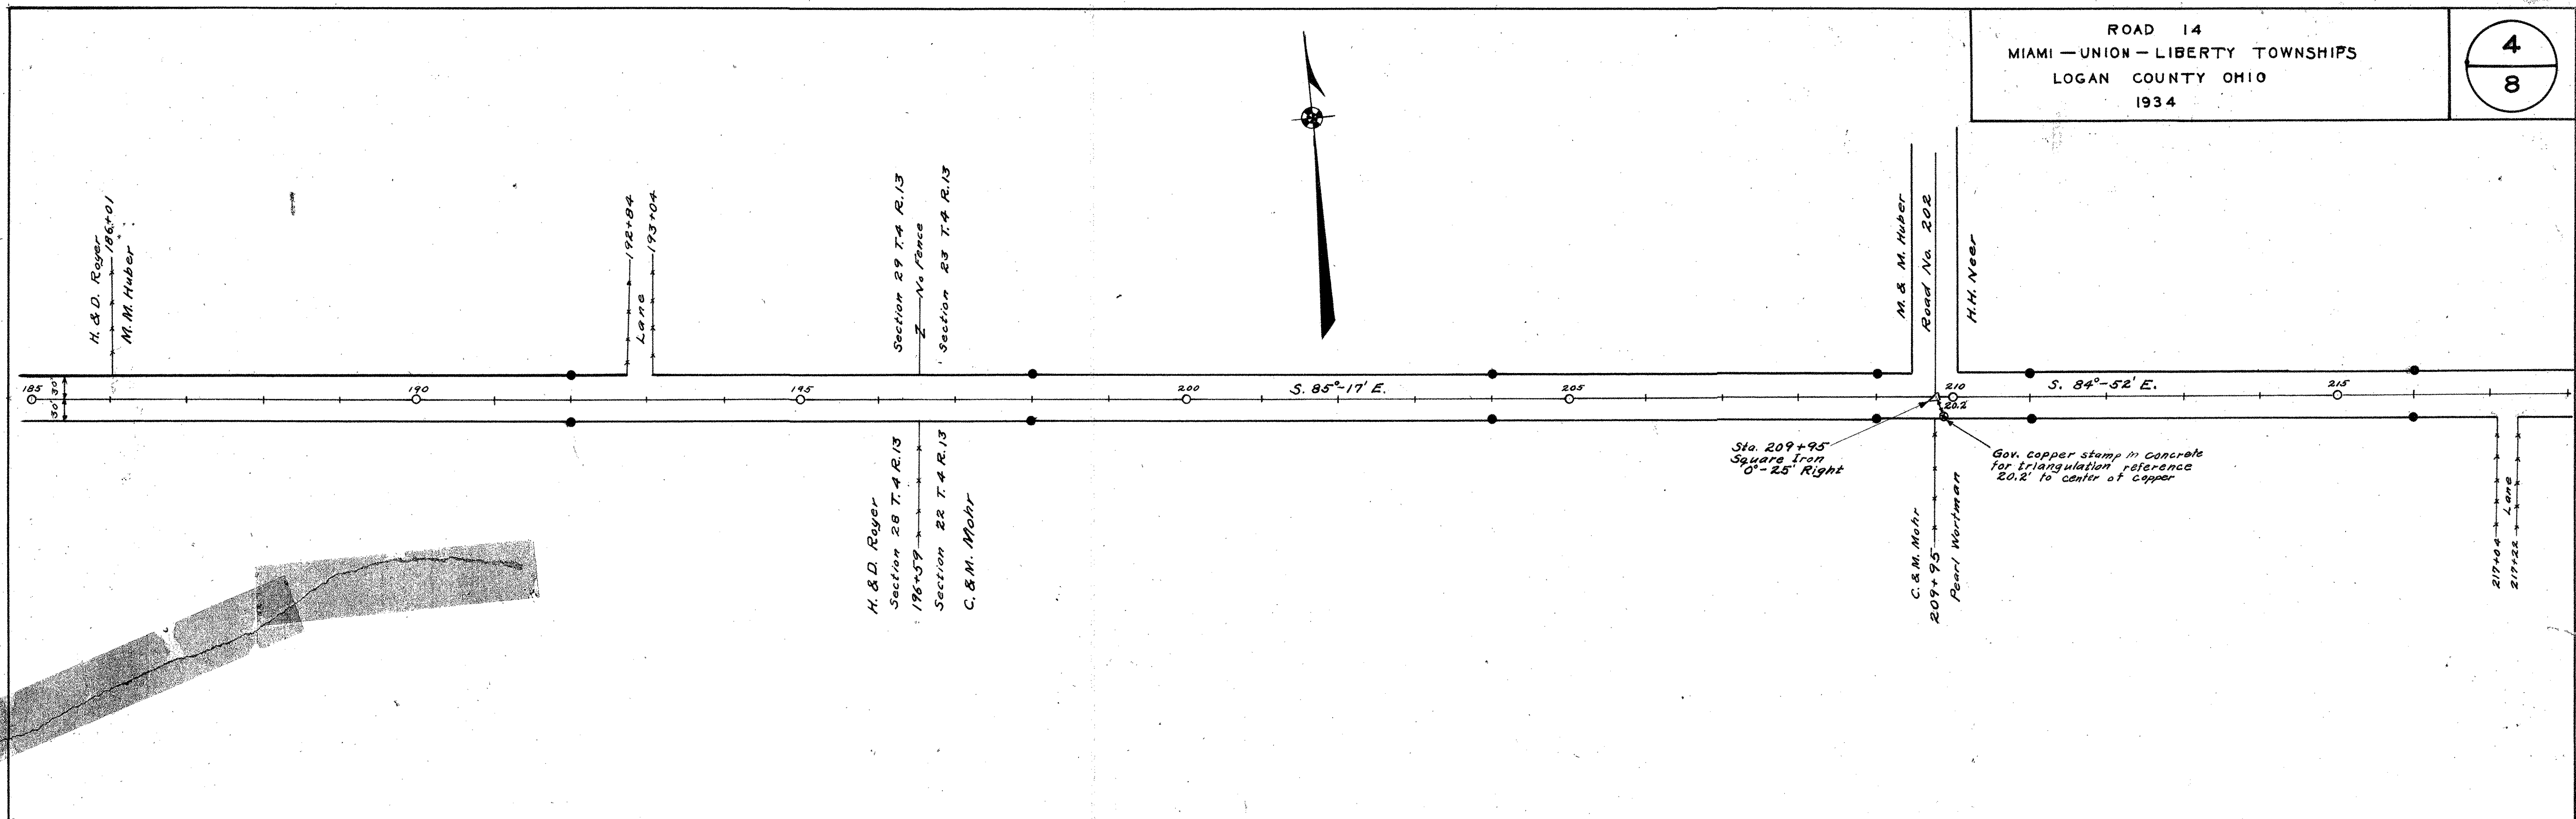


See Sheet No. 1 for R/W record  
 Concrete R/W posts set as shown  
 Field notes Logan County Surveyor's Book 582

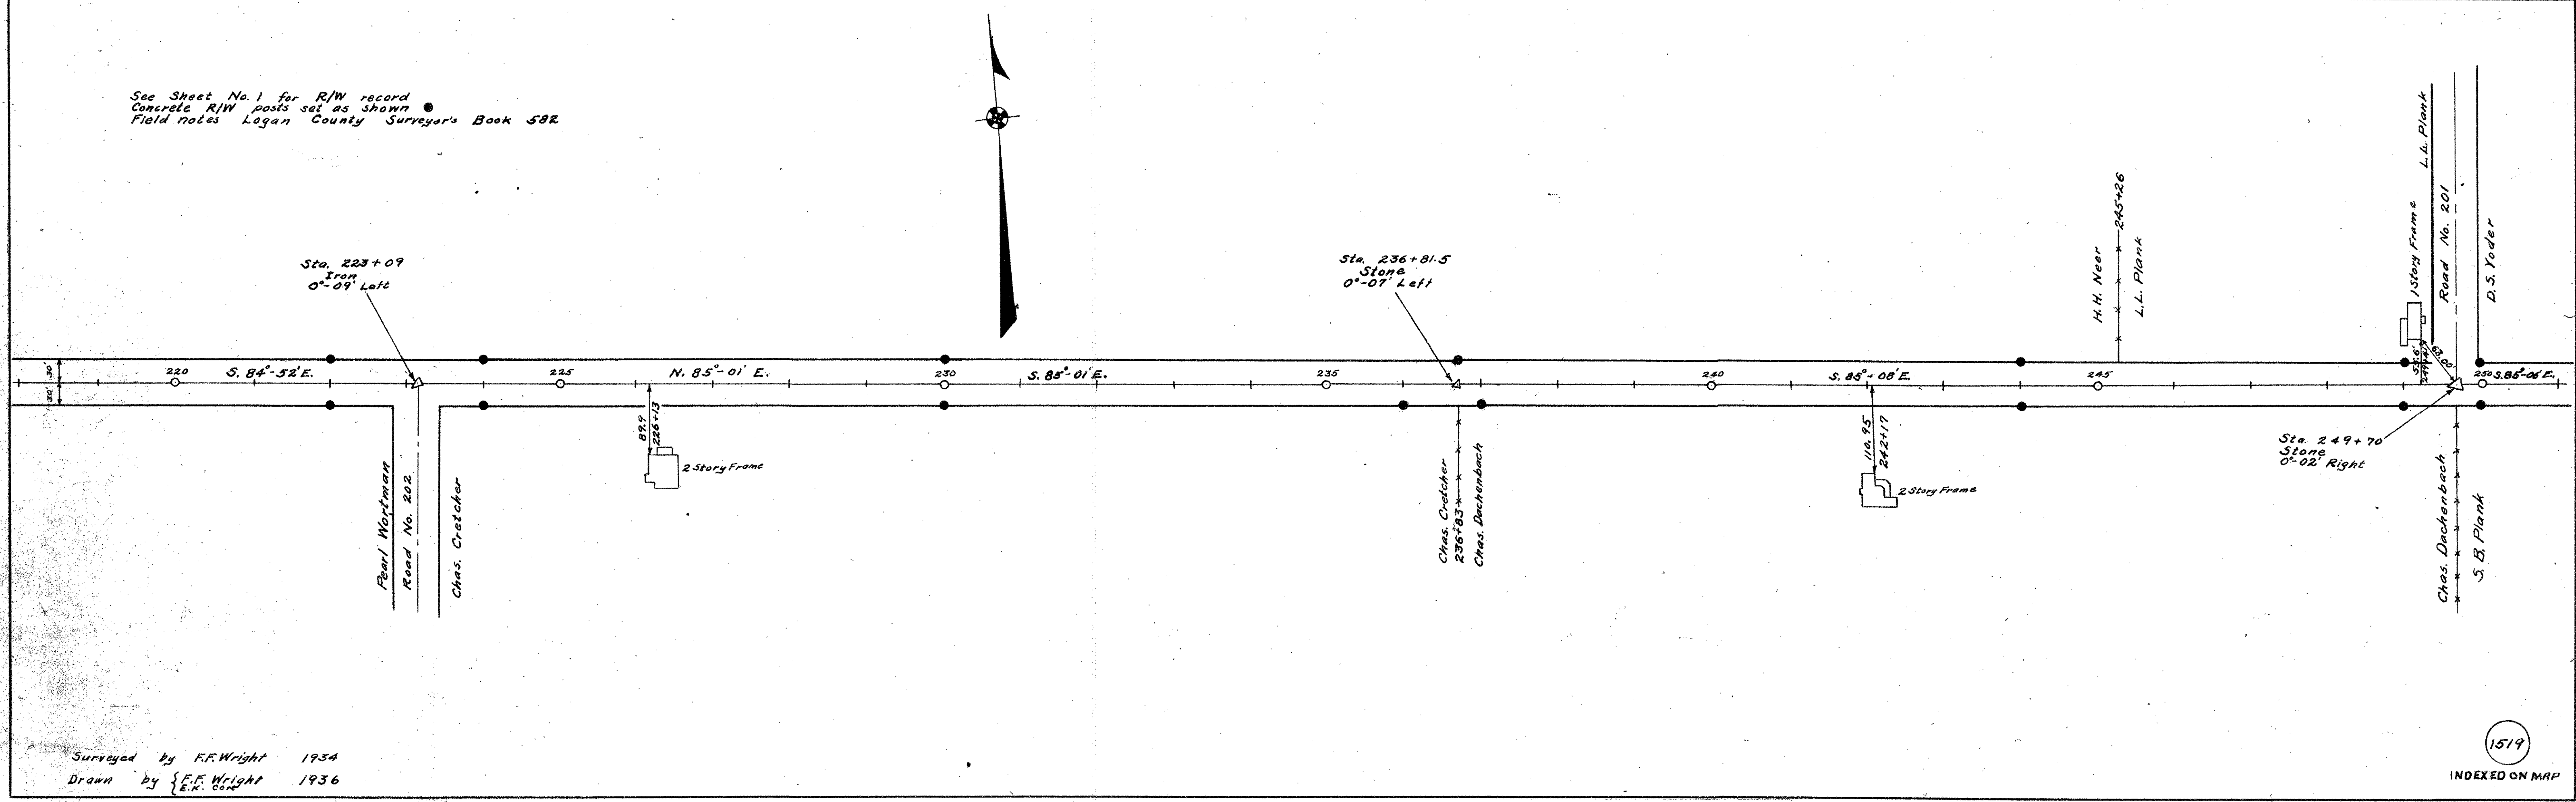


Surveyed by F.F. Wright 1934  
 Drawn by F.F. Wright 1936  
 E.C. Co. Inc.

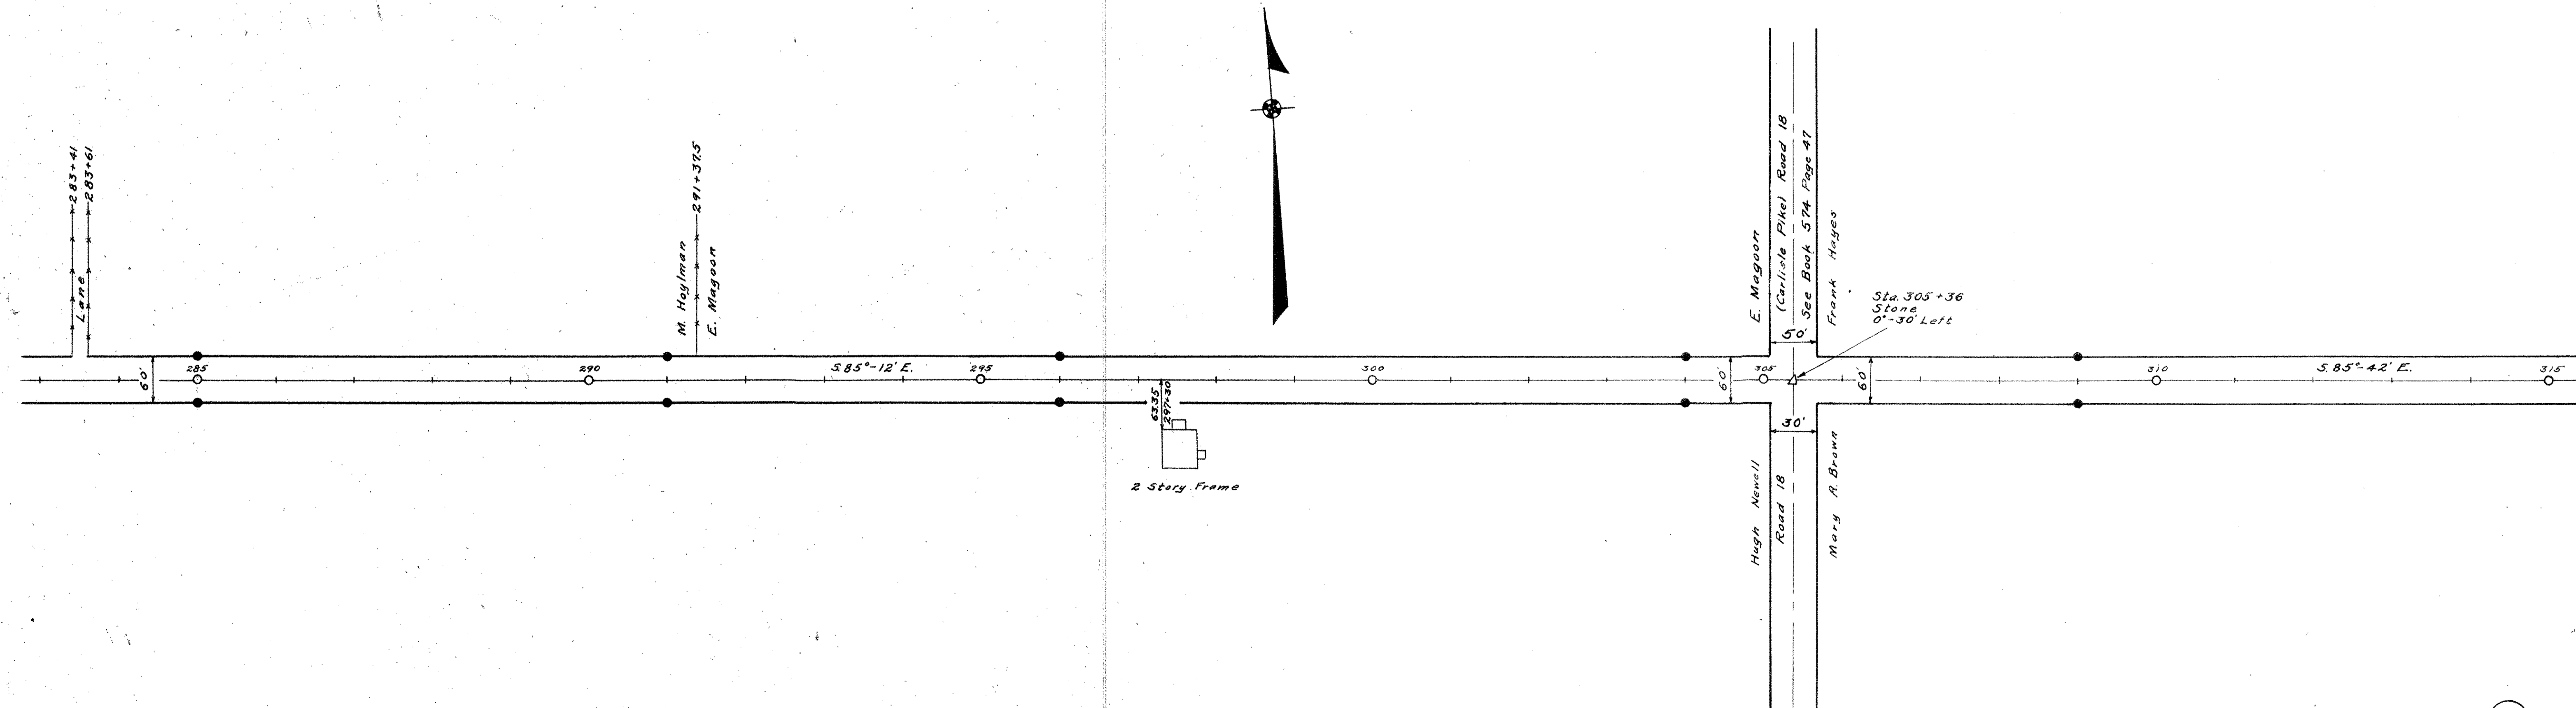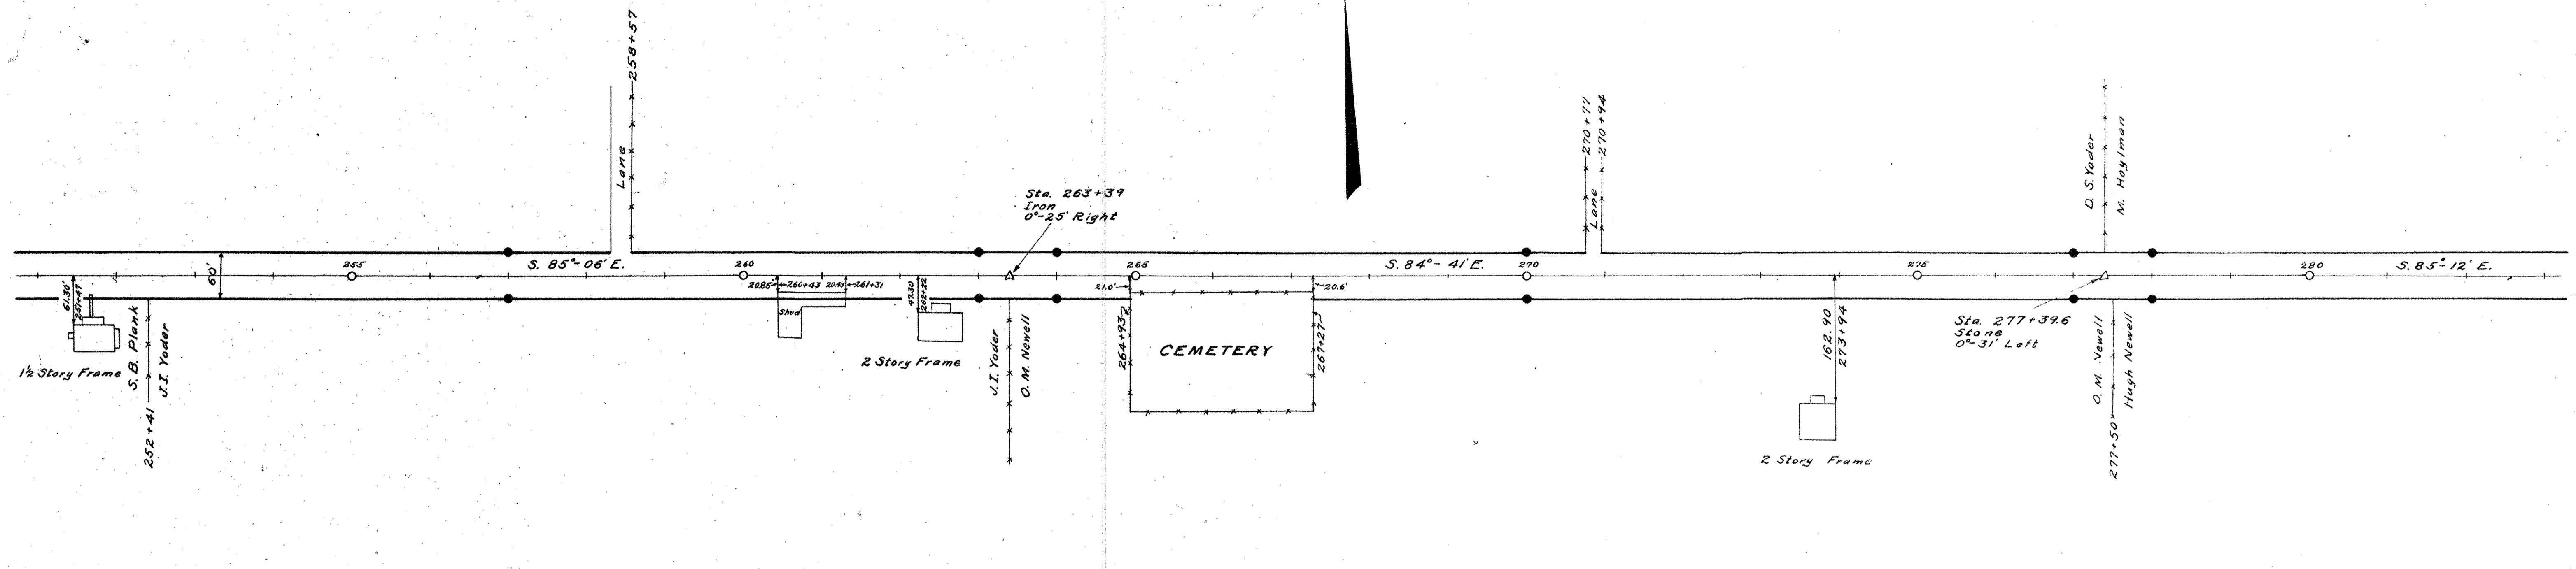

Surveyed By F.F. Wright  
 December 1933  
 Drawn By E.K. Core  
 April 1936

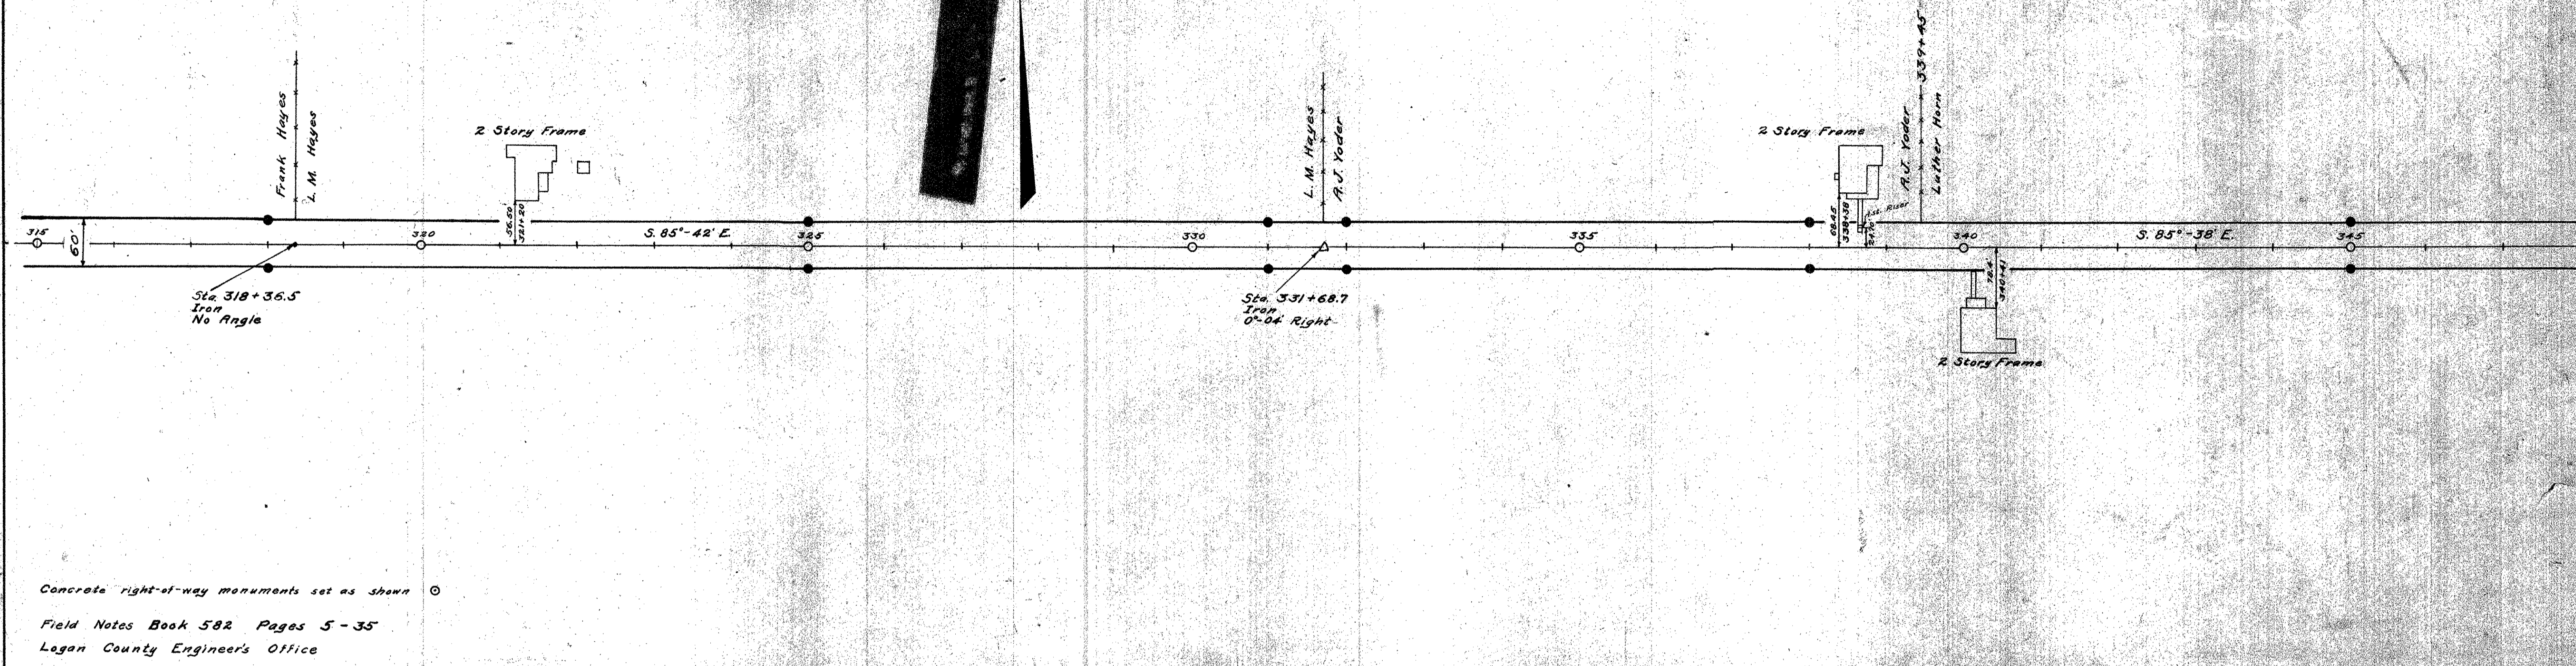


Concrete right-of-way monuments set as shown  
 Field Notes Book 582 Pages 5-35  
 Logan County Engineer's Office

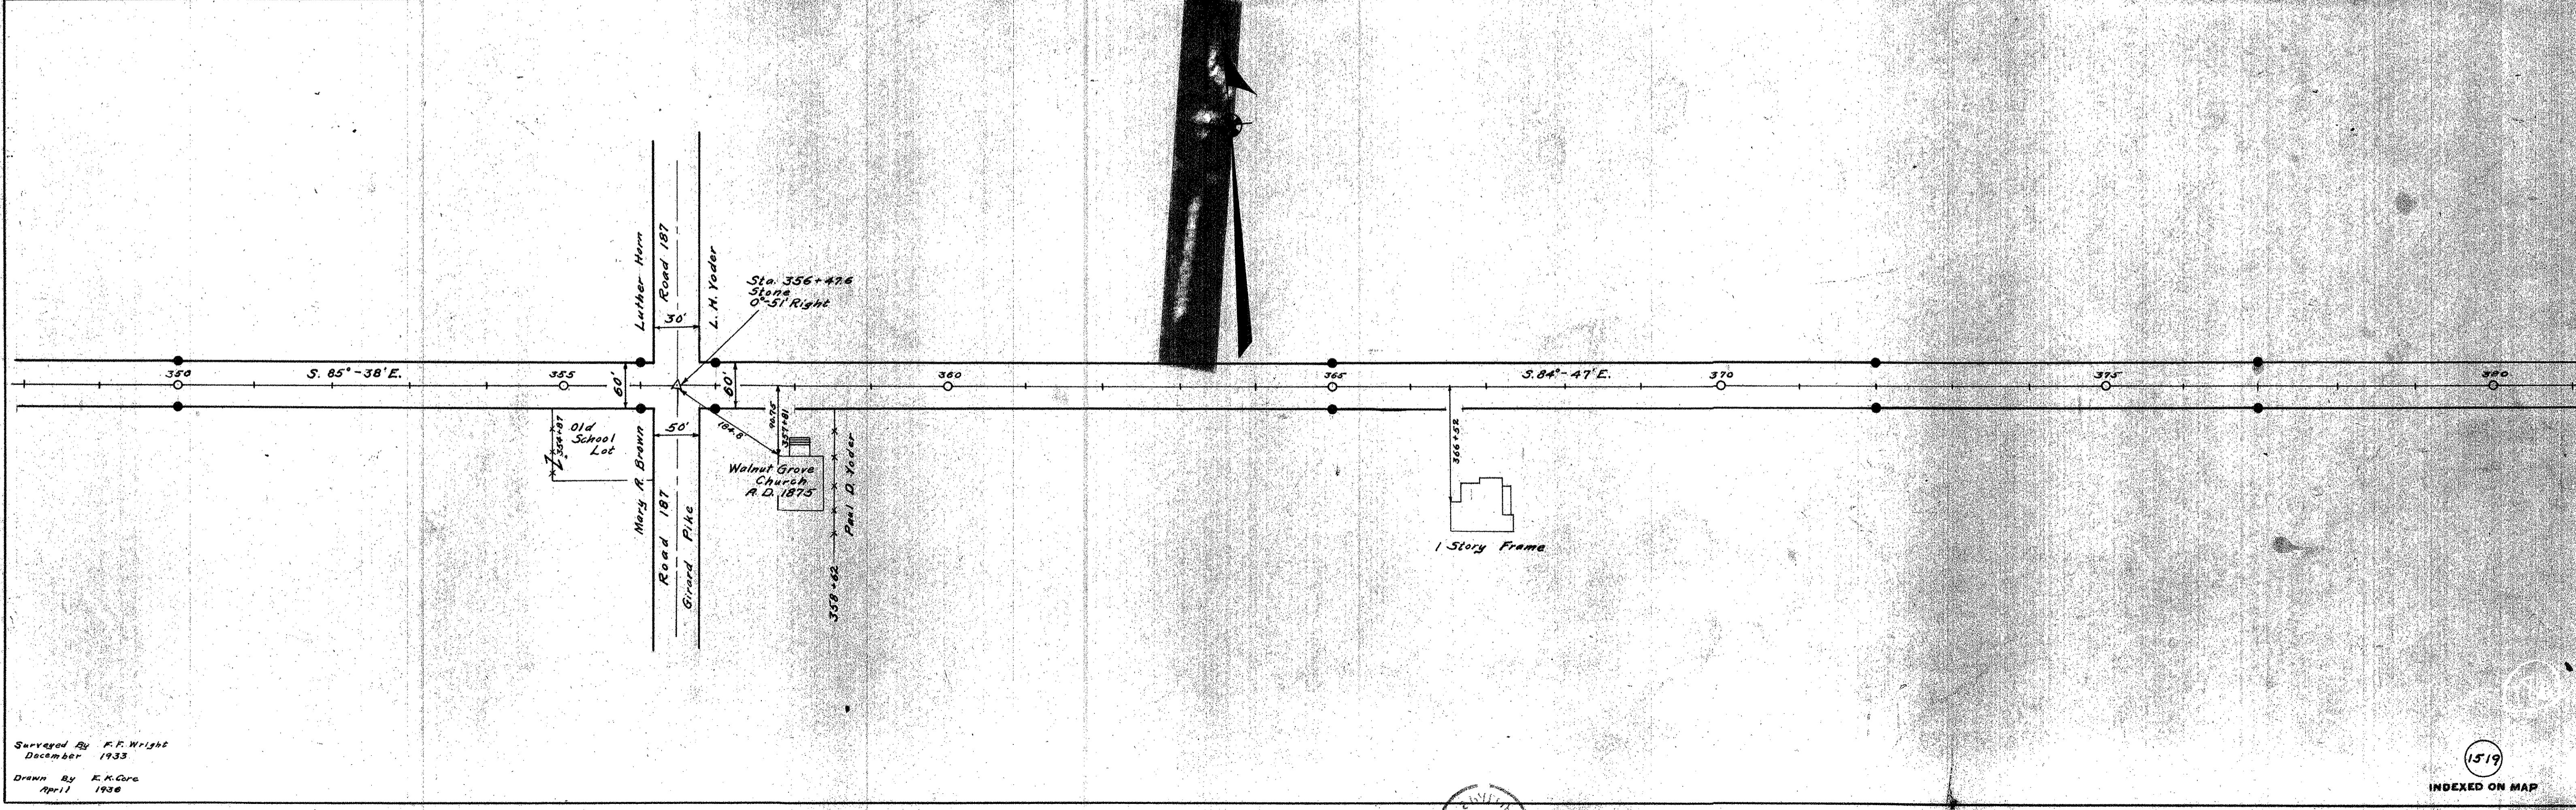


Surveyed By F.F. Wright  
 December 1933  
 Drawn By E.K. Core  
 April 1938




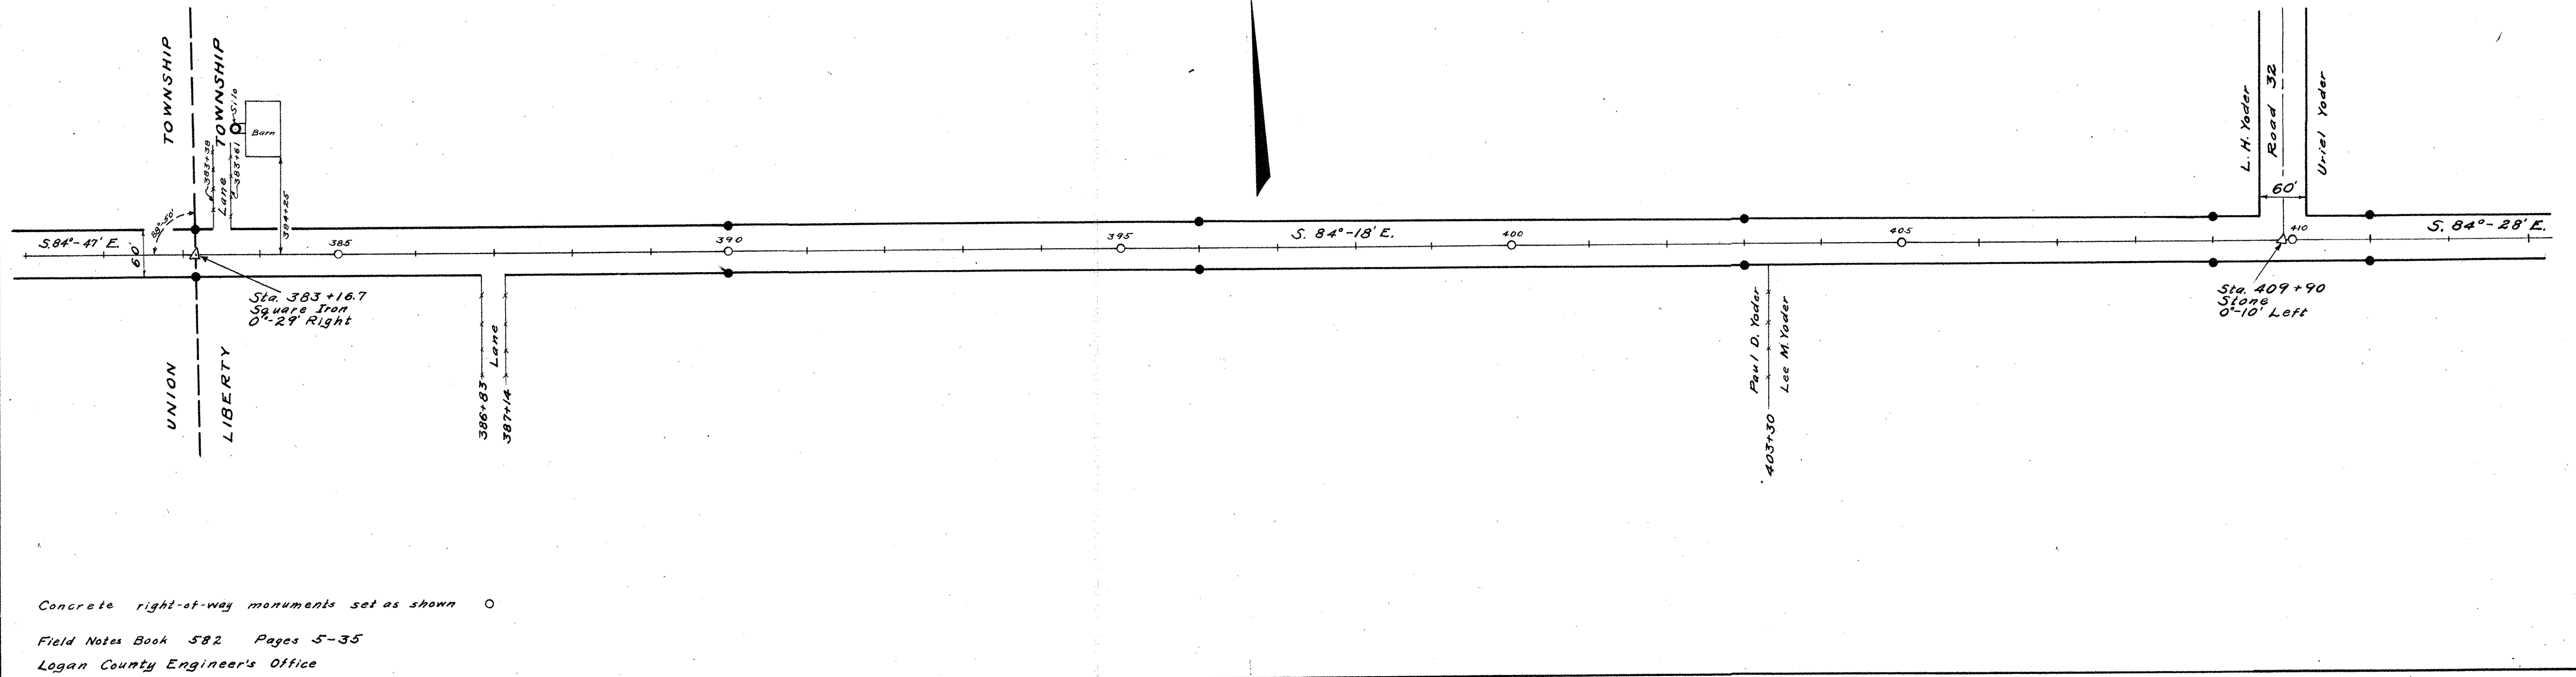



Concrete right-of-way monuments set as shown ○  
 Field Notes Book 582 Pages 5-35  
 Logan County Engineer's Office

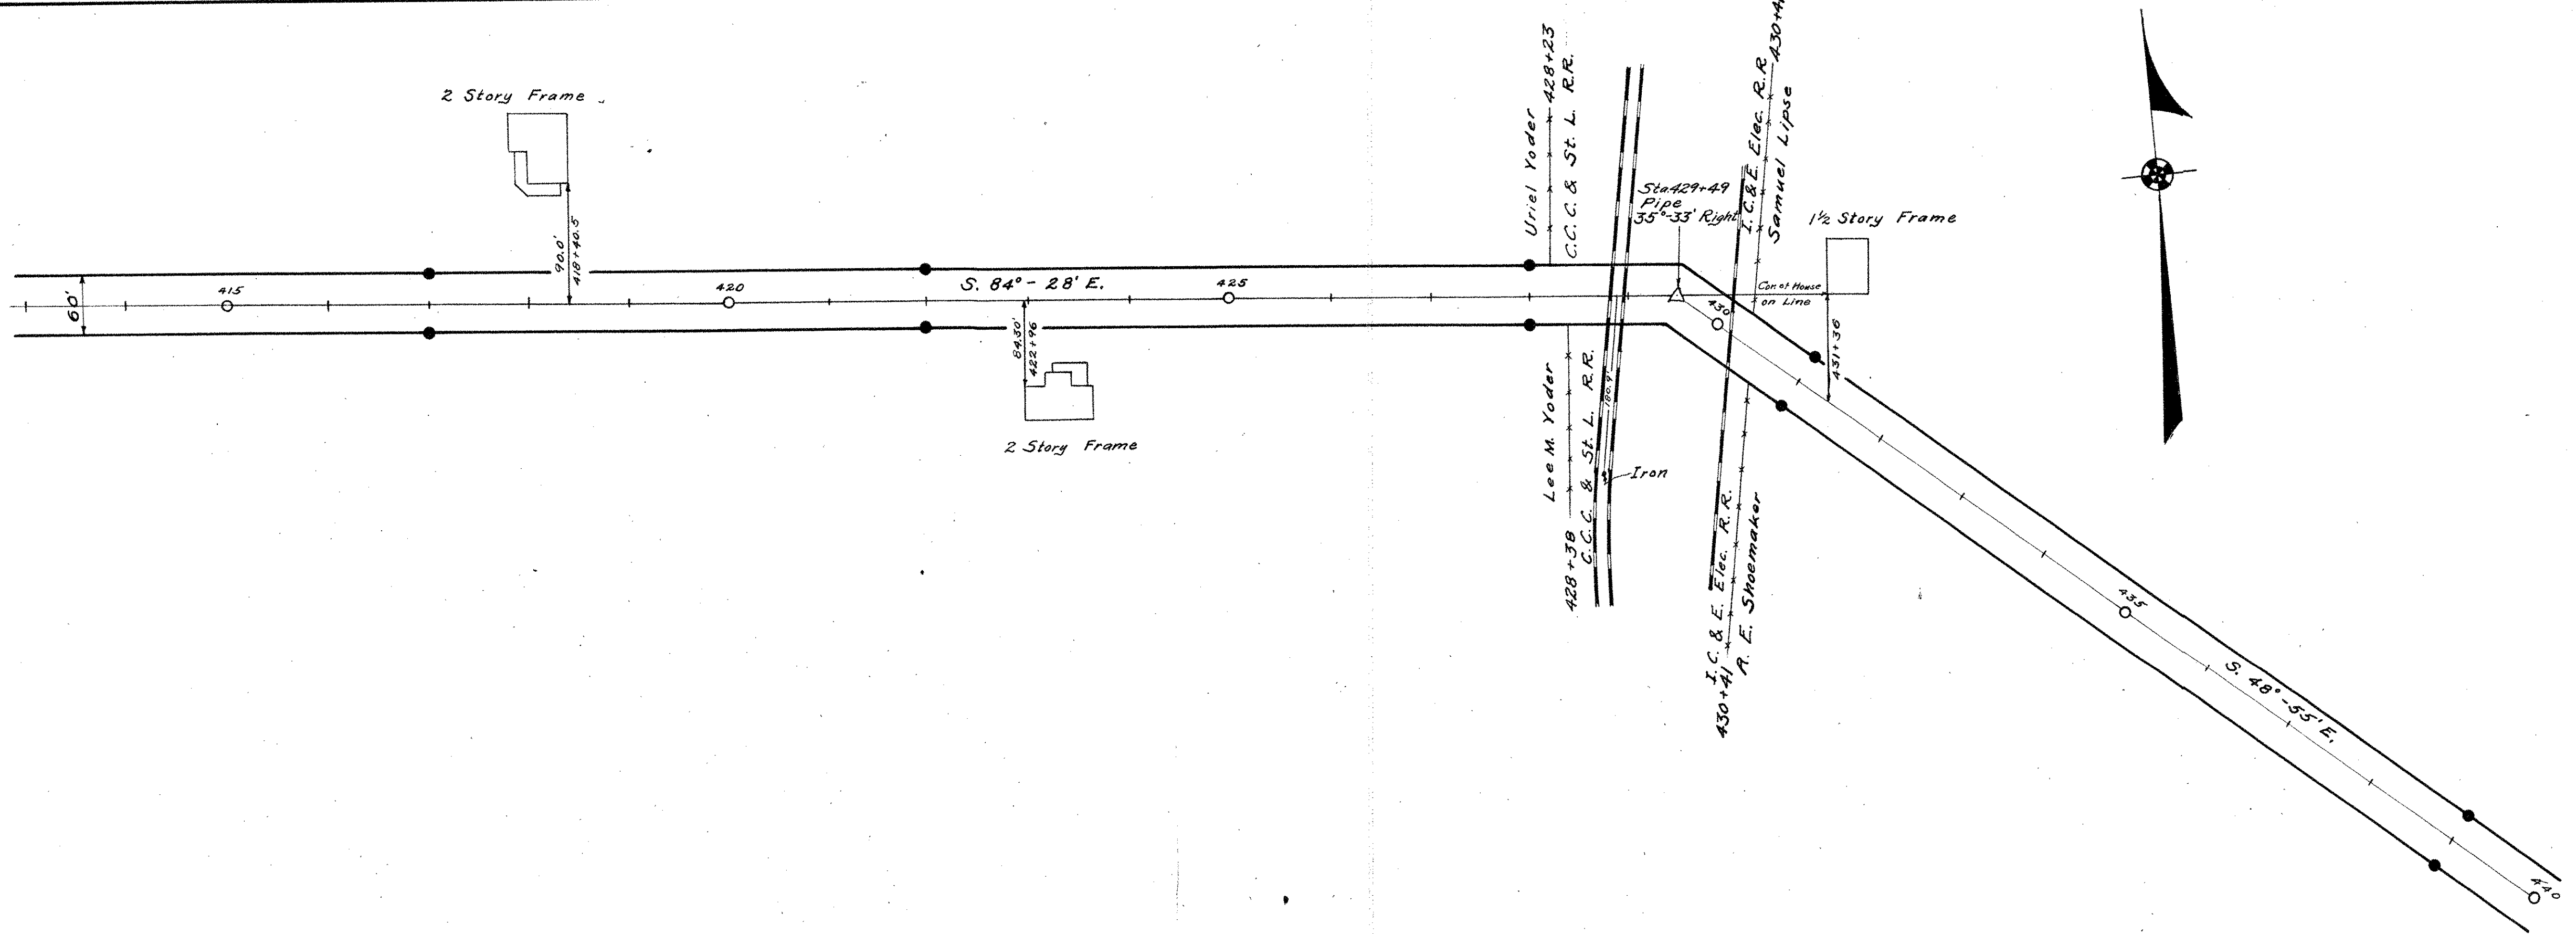

Surveyed By F.F. Wight  
 December 1933  
 Drawn By E.M. Core  
 May 1936

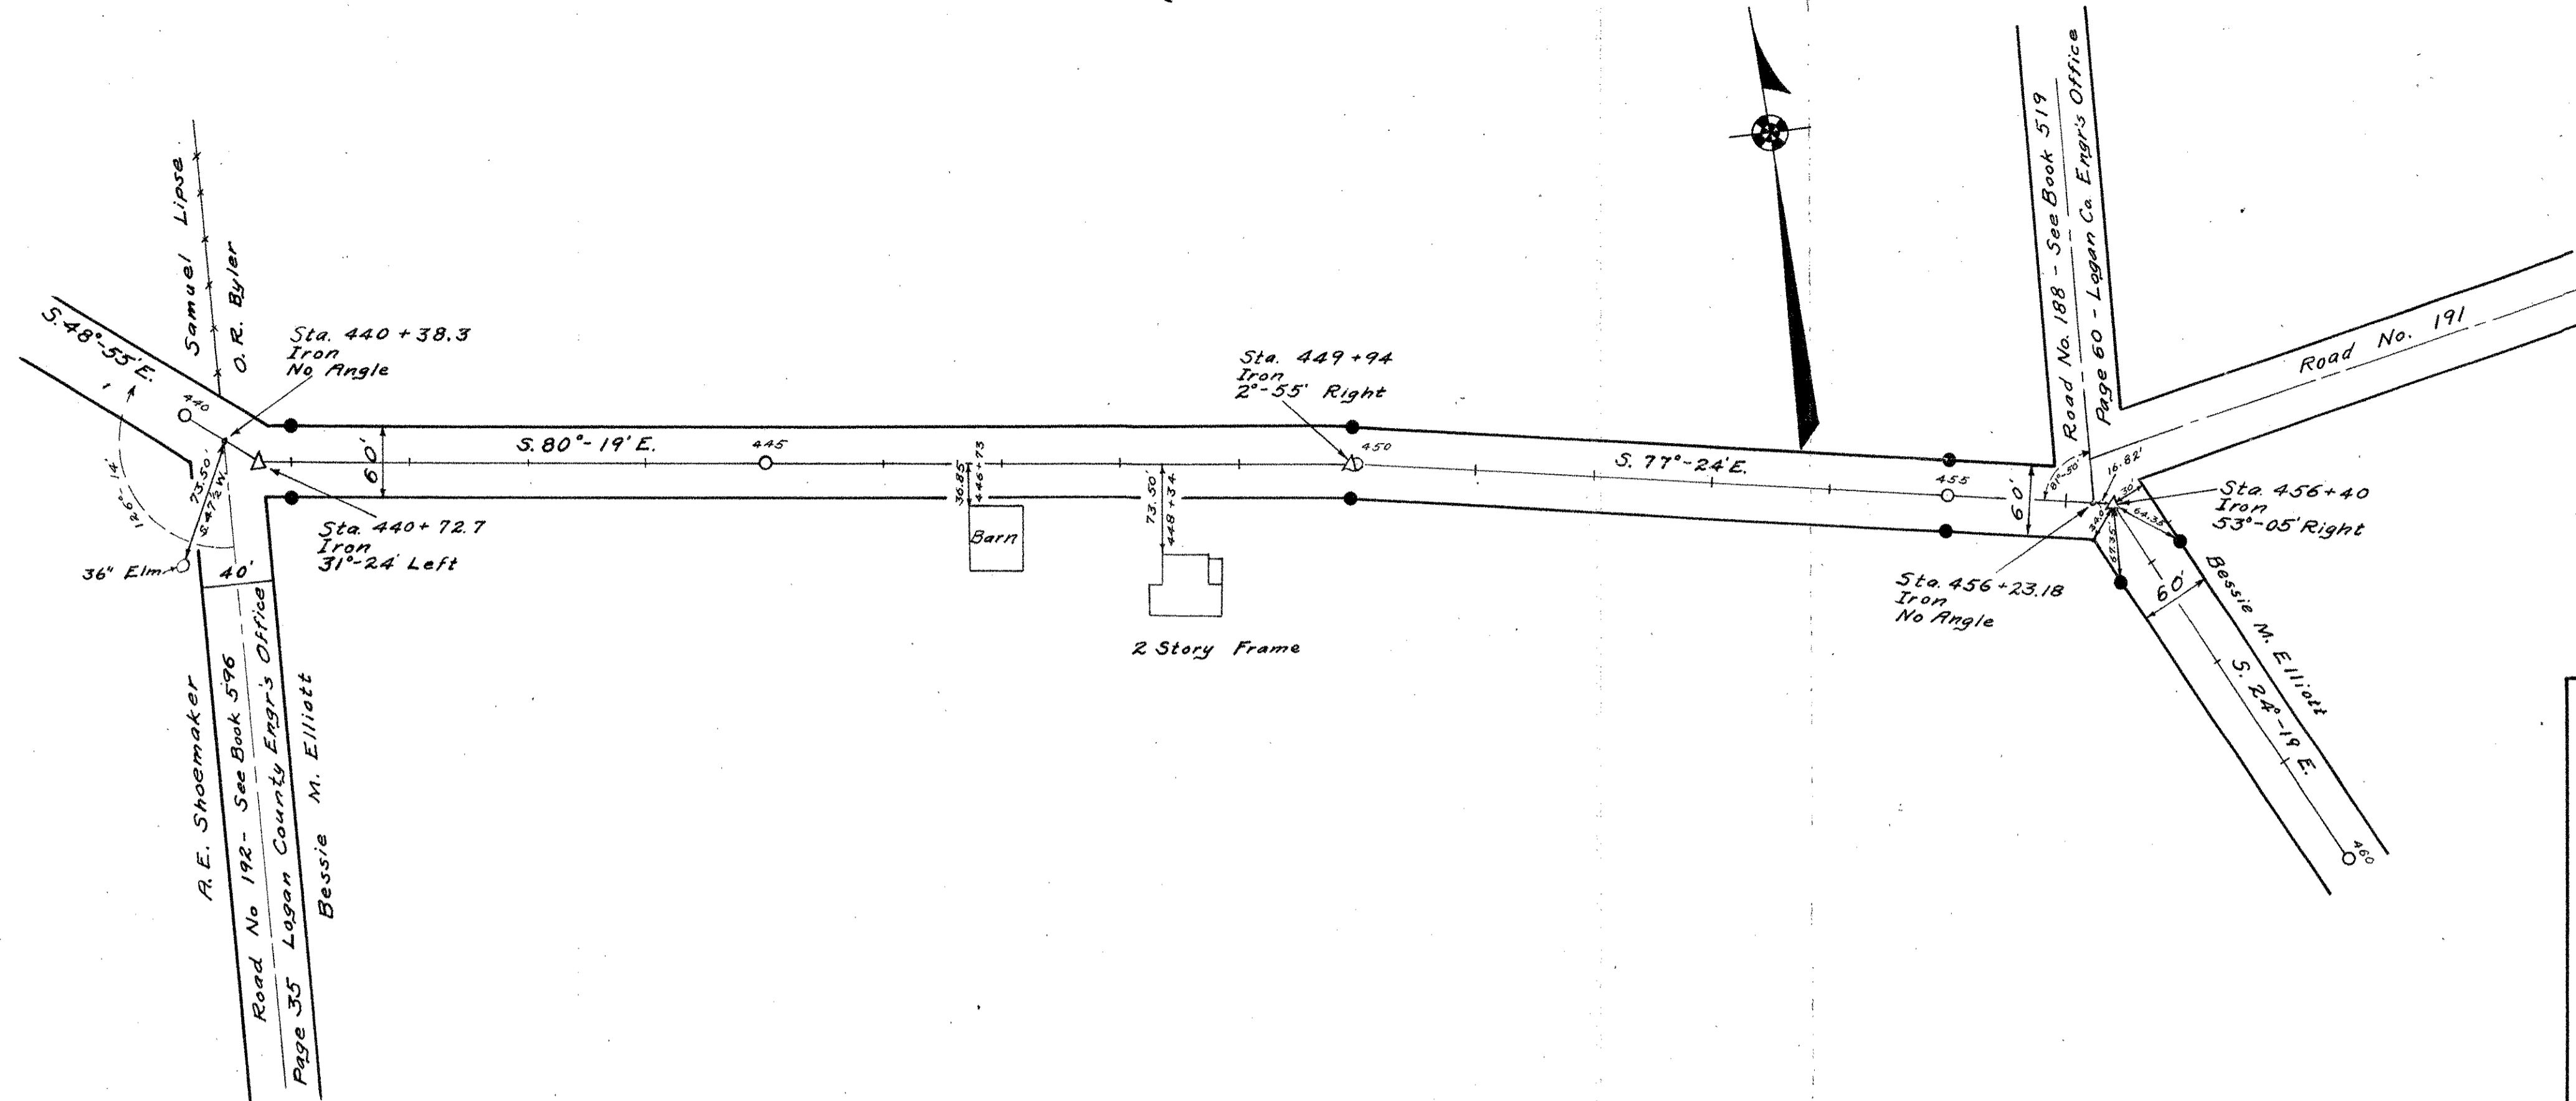

Concrete right-of-way monuments set as shown  
 Field Notes Book 582 Pages 5-35  
 Logan County Engineers Office

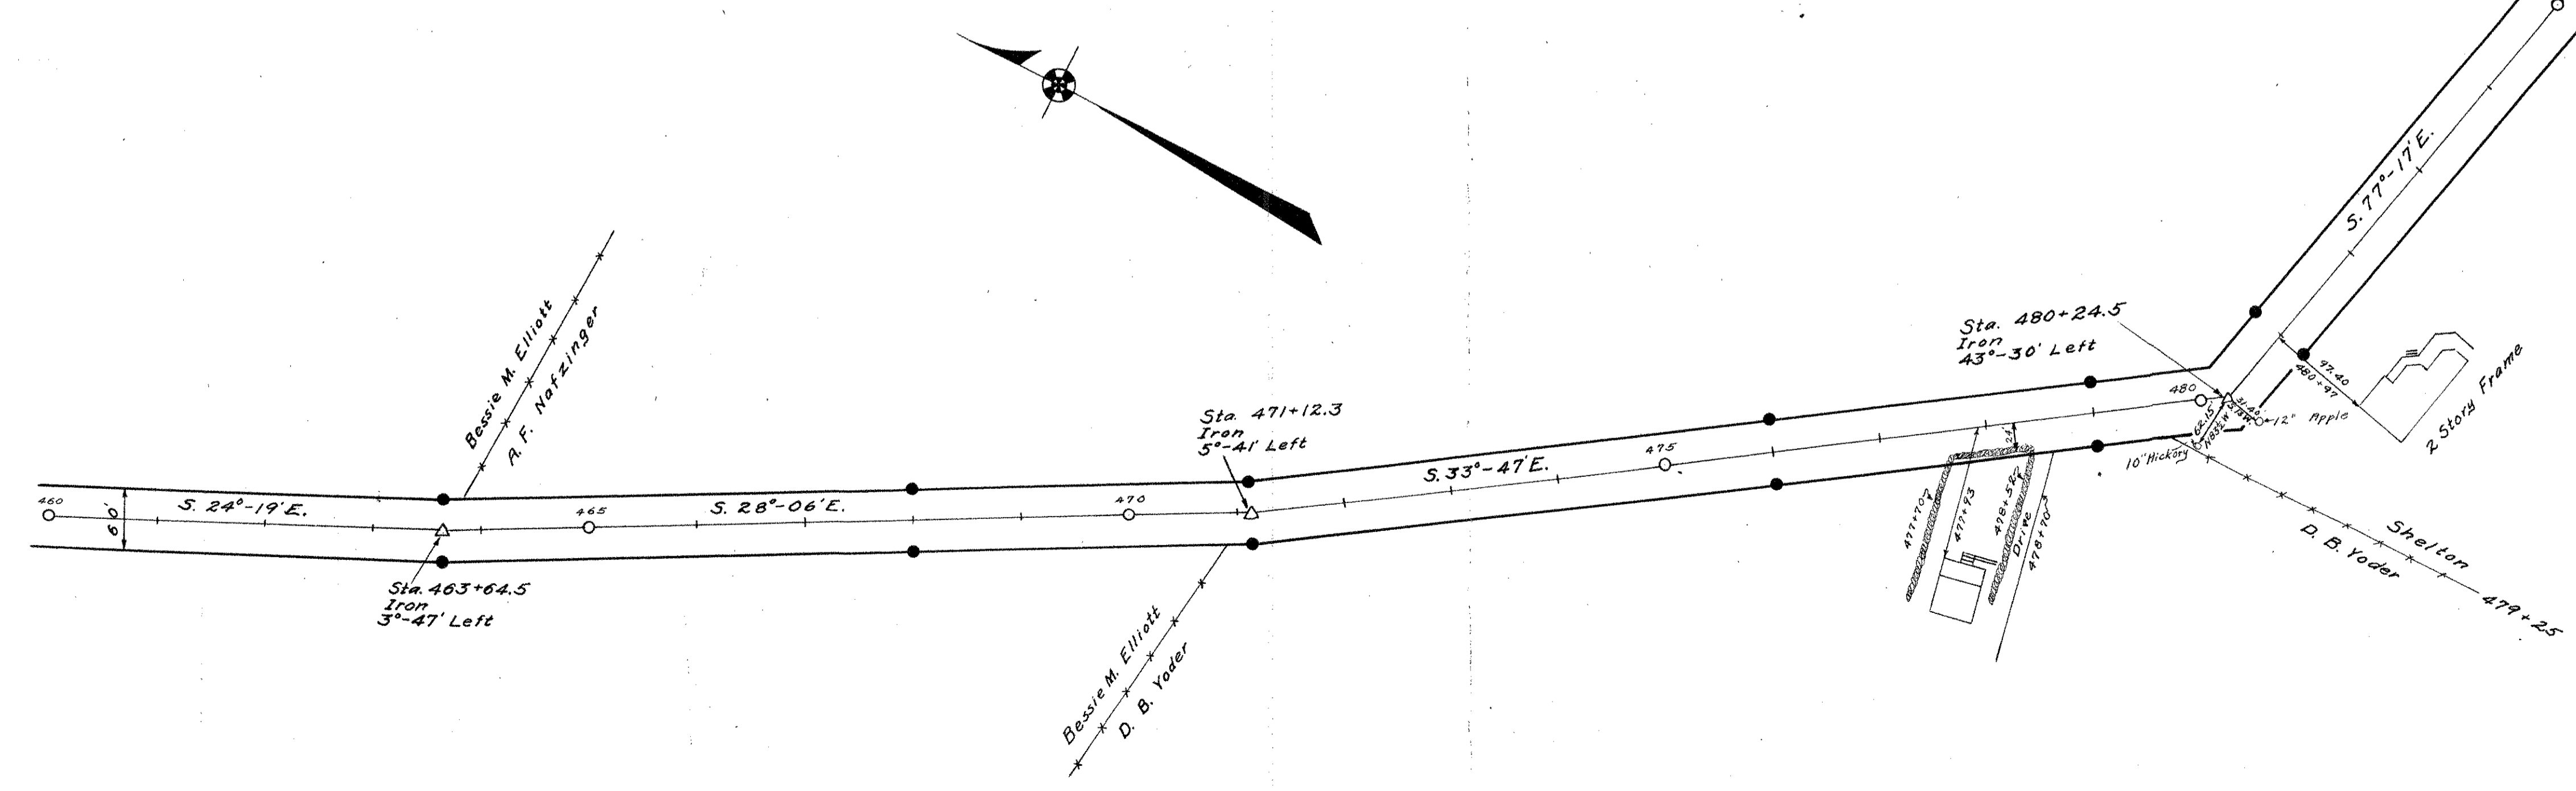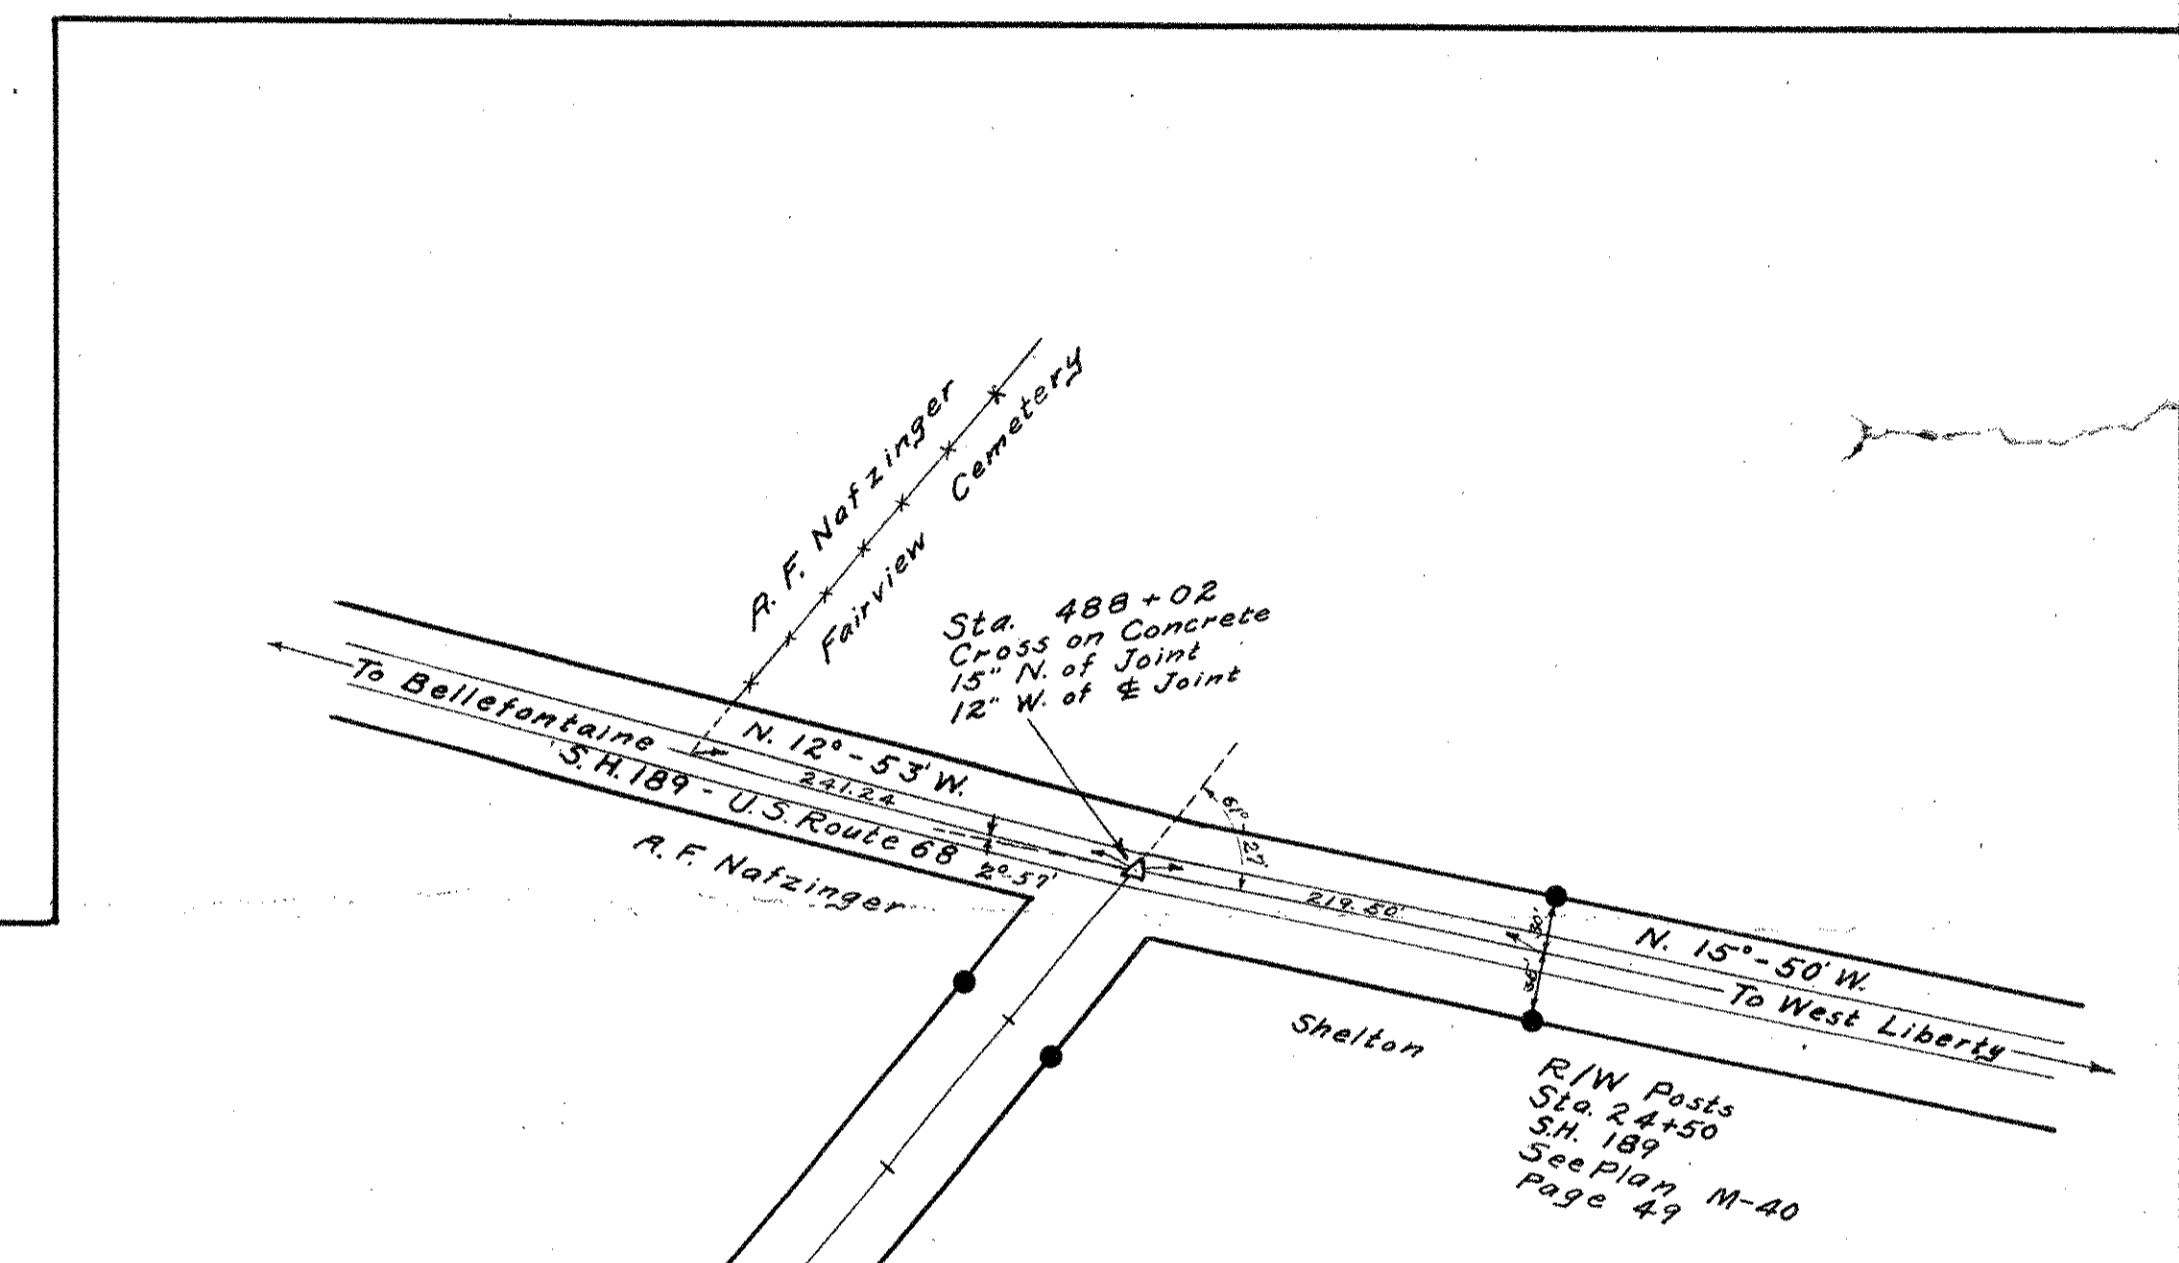

Surveyed By F.F. Wright  
 December 1933  
 Drawn By E.K. Cole  
 May 1936