

SNOW SURVEY
Sec. 6 T-3 R-13
MIAMI TOWNSHIP
May 31, 1980

The following described real estate situated in Miami Township, Logan County, Ohio and being part of the Southwest 1/4 of Section 6, Town 3, Range 13 of the Between the Miami Rivers Survey and more particularly described as follows:


Beginning at an iron pipe at the southwest corner of lot 264 of Smith Allotment as shown in Logan County Recorders Plat Cabinet A, Slide 365; thence with the west line of said lot N.5°23'E. 147.8 feet to an iron pipe at the northwest corner of said lot 264; thence N.85°32'W. 464.7 feet to an iron bar; thence S.4°28'W. 177.8 feet to an iron bar in the north line of Clifford Baughman's 10.00 acre tract; thence with said north line S.85°32'E. 619.10 feet to a point in the center of County Highway No.65, passing an iron pipe at 462.1 feet; thence N.5°23'E. 30.0 feet; thence N.85°32'W. 157.0 feet to the place of beginning, passing an iron pipe at the southeast corner of lot 264 at 25.0 feet.

Containing 2.00 acres more or less.





PAUL R. SNOW
29.28 AC.

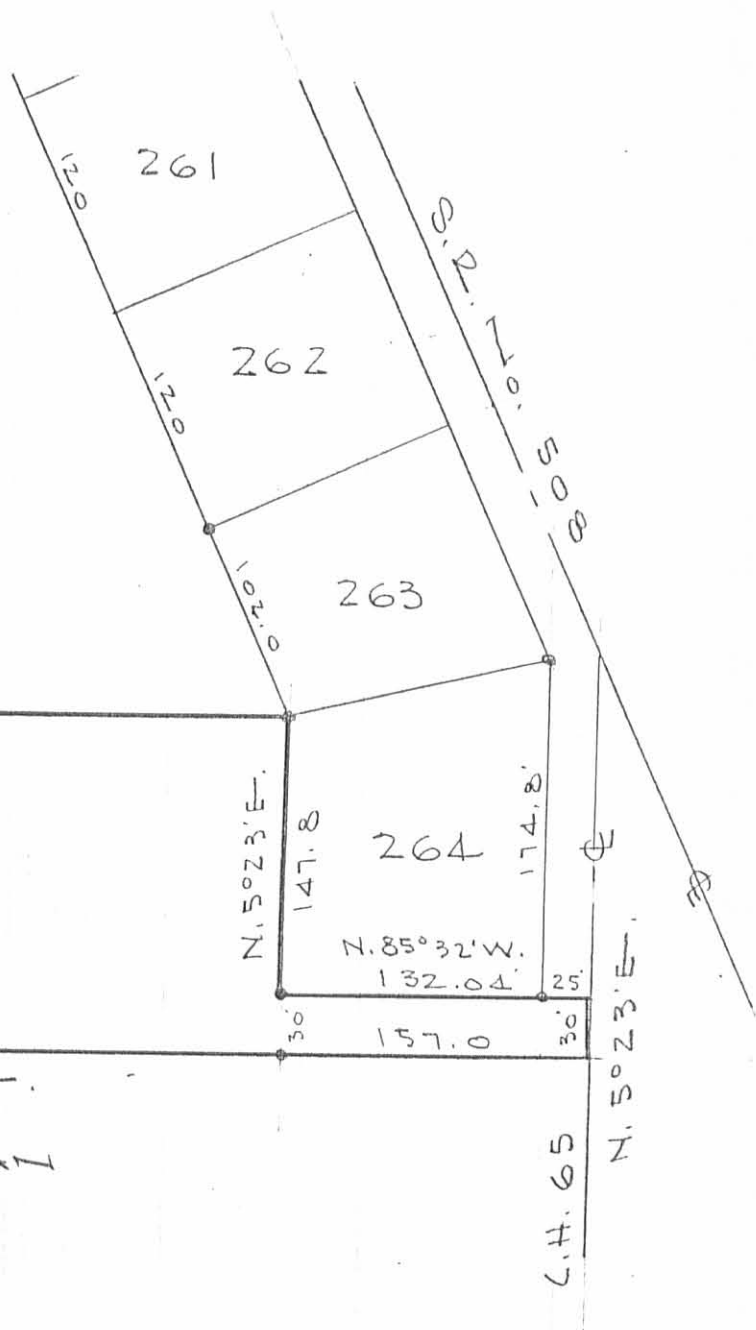

5/8" φ BAR
SET

S. 4° 25' W.
177.8'

N. 85° 32' W.

464.7'

2.00 AC

N. 5° 23' E.
147.8'

264

174.8'

N. 85° 32' W.
132.04'

462.1'

S. 85° 32' E.

25'

30'

30'

157.0'

L.H. 65

N. 5° 23' E.

5/8" φ BAR
SET

NO FENCE

CLIFFORD BAUGHMAN

SNOW SURVEY
SEC. 6 T-3 R-13
MIAMI TOWNSHIP
LOGAN COUNTY, OHIO

INDEXED ON MAP
2084 IP

MAY 31, 1980

SCALE 1" = 100'

● = PIPE FOUND

DAN L. DODSON
REG. SURVEYOR 4270
BELLEFONTAINE, O.


SNOW SURVEY
Sec. 6 T-3 R-13
MIAMI TOWNSHIP
March 27, 1982

The following described real estate situated in Miami Township, Logan County, Ohio and being part of the southwest 1/4 of Section 6, Town 3, Range 13 of the Between the Miami Rivers Survey and more particularly described as follows:

Beginning at a point in the center of State Route 508 at the northeast corner of Jay O. James' 1.14 acre tract as described in Logan County Recorders deed volume 377, page 223; thence with said James' east line S. 52°40'W. 304.2 feet to an iron bar at the southeast corner of said tract and in the west line of said southwest 1/4 Section passing an iron bar at 30.0 feet; thence with said section line S. 5°38'W. 690.0 feet to an iron bar; thence S. 84°22'E. 261.6 feet to an iron bar; thence N. 5°38'E. 617.6 feet to an iron bar in the south line of James D. Burchetts' 0.45 acre tract; thence with said south line N. 37°20'W. 181.3 feet to an iron bar; thence N. 52°40'E. 162.0 feet to a nail in the center of S. R. 508, passing an iron bar at 132.0 feet; thence with the centerline of said road N. 37°20'W. 50.0 feet to the place of beginning.

Containing 4.49 acres more or less of which 0.21 acre is in the Village of DeGraff and 4.28 acres are in Miami Township.



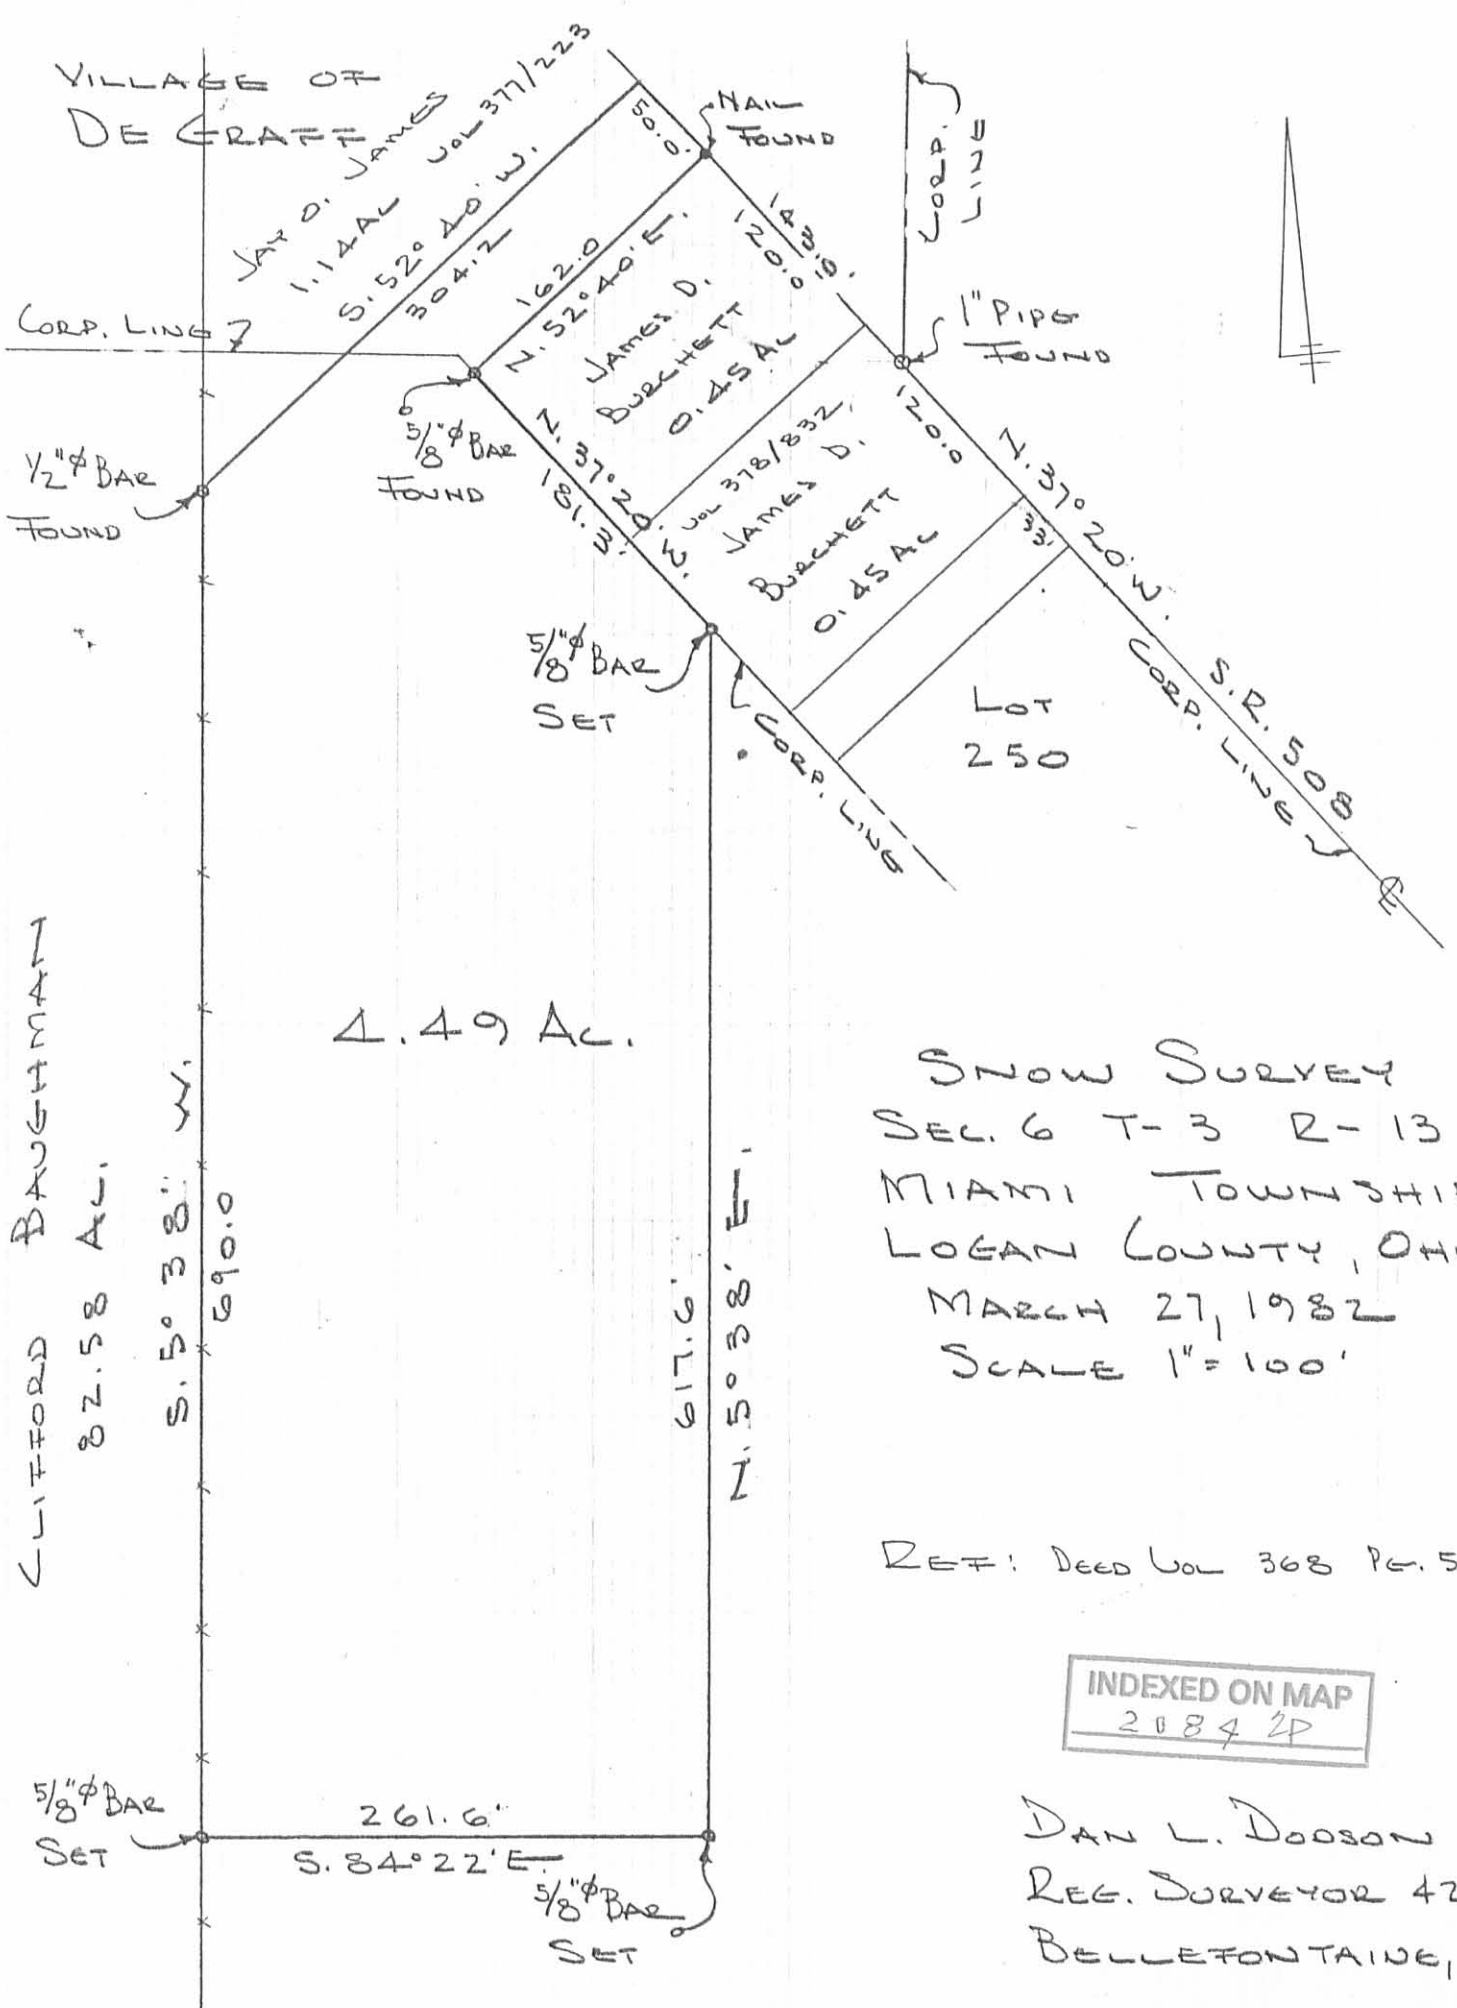

VILLAGE OF DE GRATE

JAY D. JAMES Vol. 377/223
 1.12 AC
 S. 52° 40' W.
 304.2

NAIL FOUND

CORP. LINE

1/2" φ BAR FOUND

5/8" φ BAR FOUND

5/8" φ BAR SET

1" PIPE FOUND

LOT 250

1.49 AC.

CLIFFORD BARRIERS
 82.58 AC.
 S. 5° 38' W.
 690.0

617.6'
 N. 5° 38' E.

SNOW SURVEY
 SEC. 6 T-3 R-13
 MIAMI TOWNSHIP
 LOGAN COUNTY, OHIO
 MARCH 27, 1982
 SCALE 1" = 100'

REF: Deed Vol. 368 Pg. 51

INDEXED ON MAP
 2084 2P

DAN L. DOBSON
 REG. SURVEYOR 4270
 BELLEFONTAINE, O.