


(20)

10-18-44
Dysert
Dickinson
B. W. G. S.

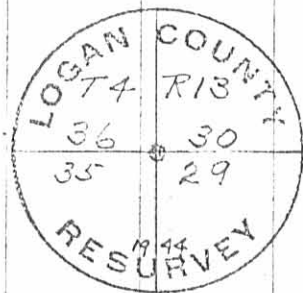


Found small digger head on top of large
stone standing on end - referred to
in Book 575 page 35
Removed same and placed
concrete upon. Full length - (4')
Top 7" below surface of road's
marked as above

See Book 575 page 36

F. B. 660

43

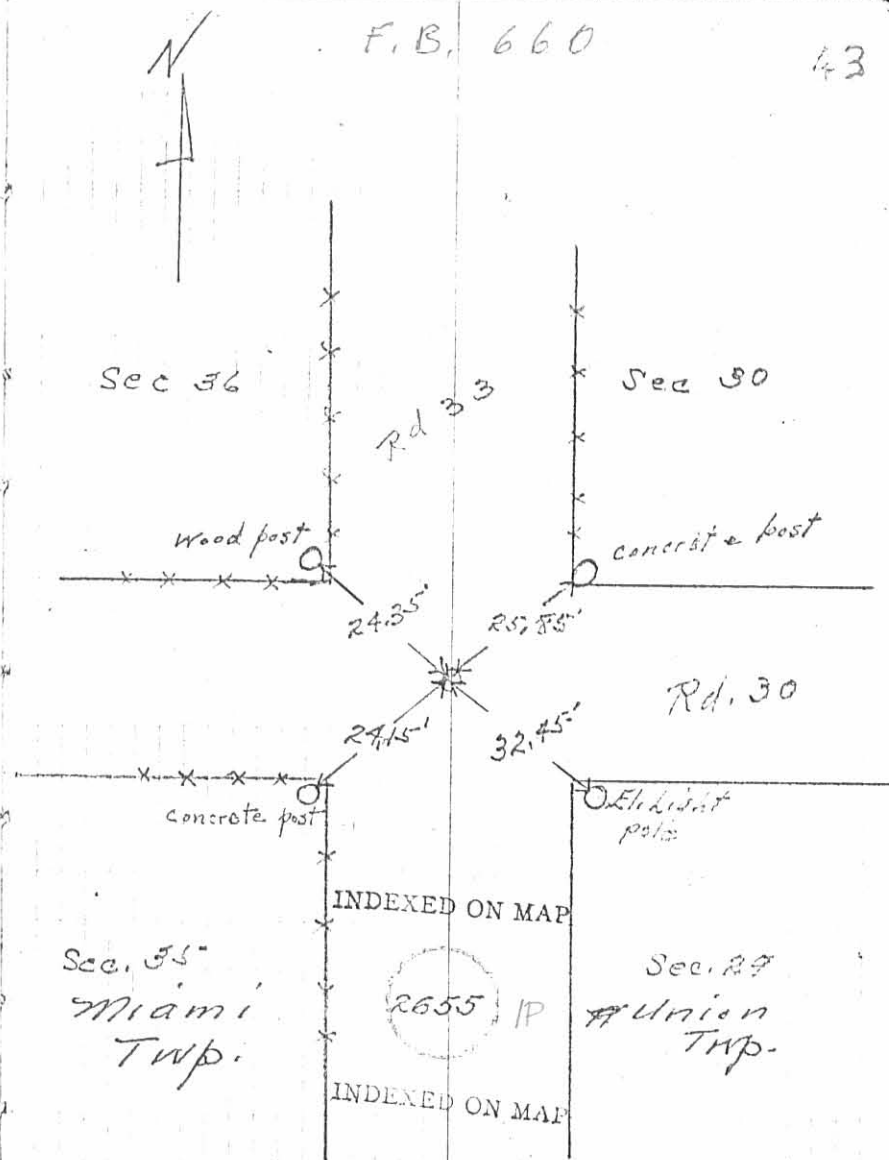

Flack EQUIPMENT COMPANY

1240 McCOOK AVENUE
DAYTON 1, OHIO
Phone - 226-3561

10660 EVENDALE DR.
CINCINNATI 41, OHIO
Phone - Princeton 1-0350



LINK-BELT SPEEDER CO.
SHOVELS - CRANES
DIESEL PILE HAMMERS




MARCH 6, 1985

COLD - CLEAR

DJ - D. GILBERT

C. NICHOLS

X - C. DILL

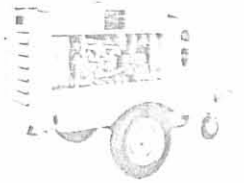

LE ROI AIR COMPRESSOR
CLEVELAND AIR TOOLS

Sec. 36 T.4 R.13

Sec. 30 T.4 R.13

LARGE CONC.
POST.

LARGE CONC.
POST.



CHALLENGE
TRUCK MOVERS

T.R. No. 30

RESURFACE MAINT. FC.
7" DEEP



PARSONS TRENCHER

LARGE CONC.
POST.

R.R. SPIKE
IN
"D" WOOD CONC.
POST.



TEALE
HYDRAULIC CRANES

Sec 35 T.4 R.13

Sec. 20 T.4 R.13

T.R. No. 33



NEW CINCINNATI
LOCATION

Complete Line of Rental Equipment Also Available

INDEXED ON MAP
26552P

(20)

10-18-44
Dyert
Dickinson
B. Wilgas



Found Small Migger Head on top of large
Stone standing on end. referred to
in Book 575 page 35
Removed same and placed
Concrete upon. Full length - (4')
Top 7" below surface of roads
Marked as above

See Book 575 page 36

43

