

(21)

10-18-47

Dycort
Robbins
Mrs. Adams




Found Stone ^{and} broken brick. See Book
575 page 36.

Removed and placed Con. Man.
Full (4') Length - Top 6" below road
marked as above

See Book 575 page 36

44

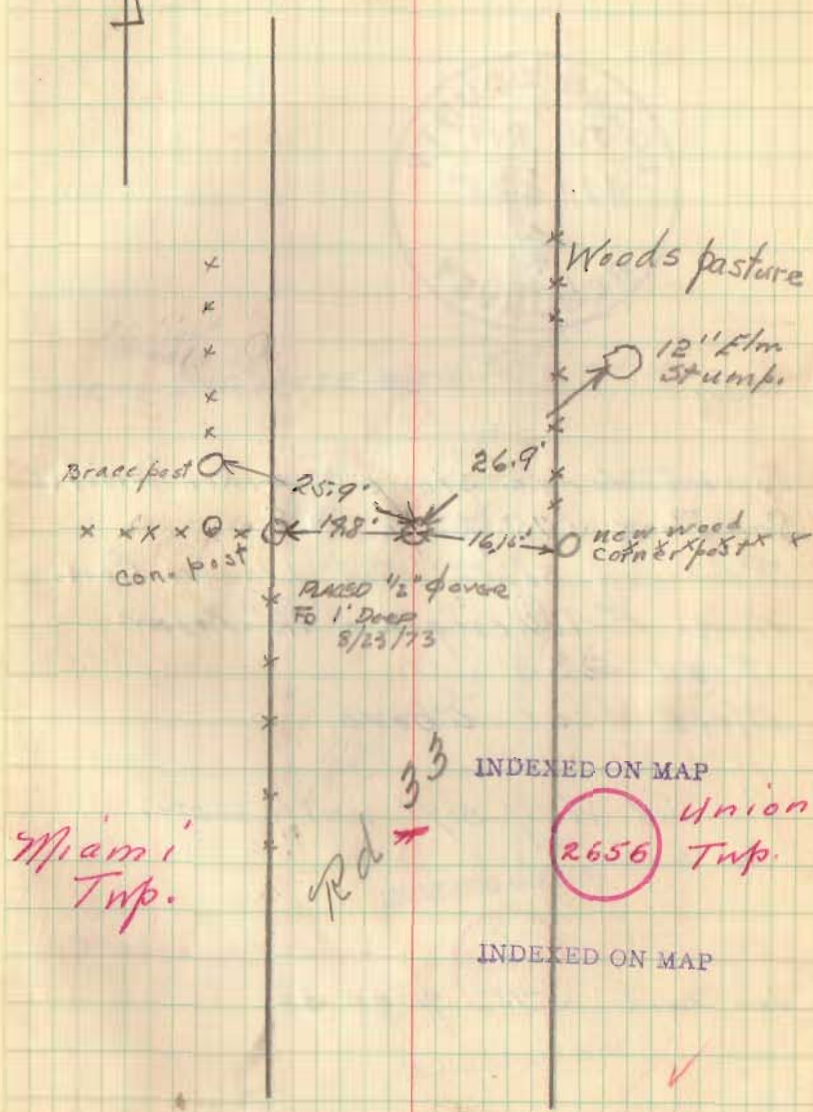

Miami
Twp.

Rd 33

INDEXED ON MAP

Union
Twp.

INDEXED ON MAP