

Francis S. Rose Survey
Section 34 T.3 R. 13
Miami Township
Logan County, Ohio

October 21, 1967

The following described situated in the State of Ohio, County of Logan and Township of Miami and being in the Northeast corner of the Southeast Quarter of Section 34 Town 3 Range 13 M. R. S. and being further described as follows:


Beginning at a point in the Center of C.H. No. 68, known as the Indian Creek Pipe, said point being the Northeast corner of the Southeast Quarter of Section 34 and also being the Northeast corner of Francis S. Rose's present 142.07 Ac. tract as carried on the Logan County Auditors Tax Duplicates; Thence with said Rose's North line and Quarter section line, N. $83^{\circ}46'30''$ W. 141.50 feet to a steel fence post in said line, passing through a 9" Concrete End Post at 20.0 feet; thence S. $7^{\circ}13'30''$ W. 101.40 feet, with the present fence line to a 5" Wooden Corner Post; thence S. $83^{\circ}34'$ E. 143.50 feet, with the present fence line to a Point in the center of C.H. No. 68, passing through a 5" Wooden Corner Post at 118.53 feet, said center of C.H. No. 68 being the East Line of Section 34; thence N. $6^{\circ}55'$ E. 102.00 feet, with said center line of C.H. No. 68 to the Place of beginning, containing 0.33 Acres more or less, and being out of the present 142.07 Acre tract now in the name of Francis S. Rose as recorded in Vol. 227 Page 84 of the Logan County Deed Records.

This property was surveyed by Daniel E. Gilbert, Registered Surveyor No. 5402 on October 21, 1967.

Daniel E. Gilbert
Daniel E. Gilbert
Reg. Sur. No. 5402

10
4133

INDEXED ON MAP

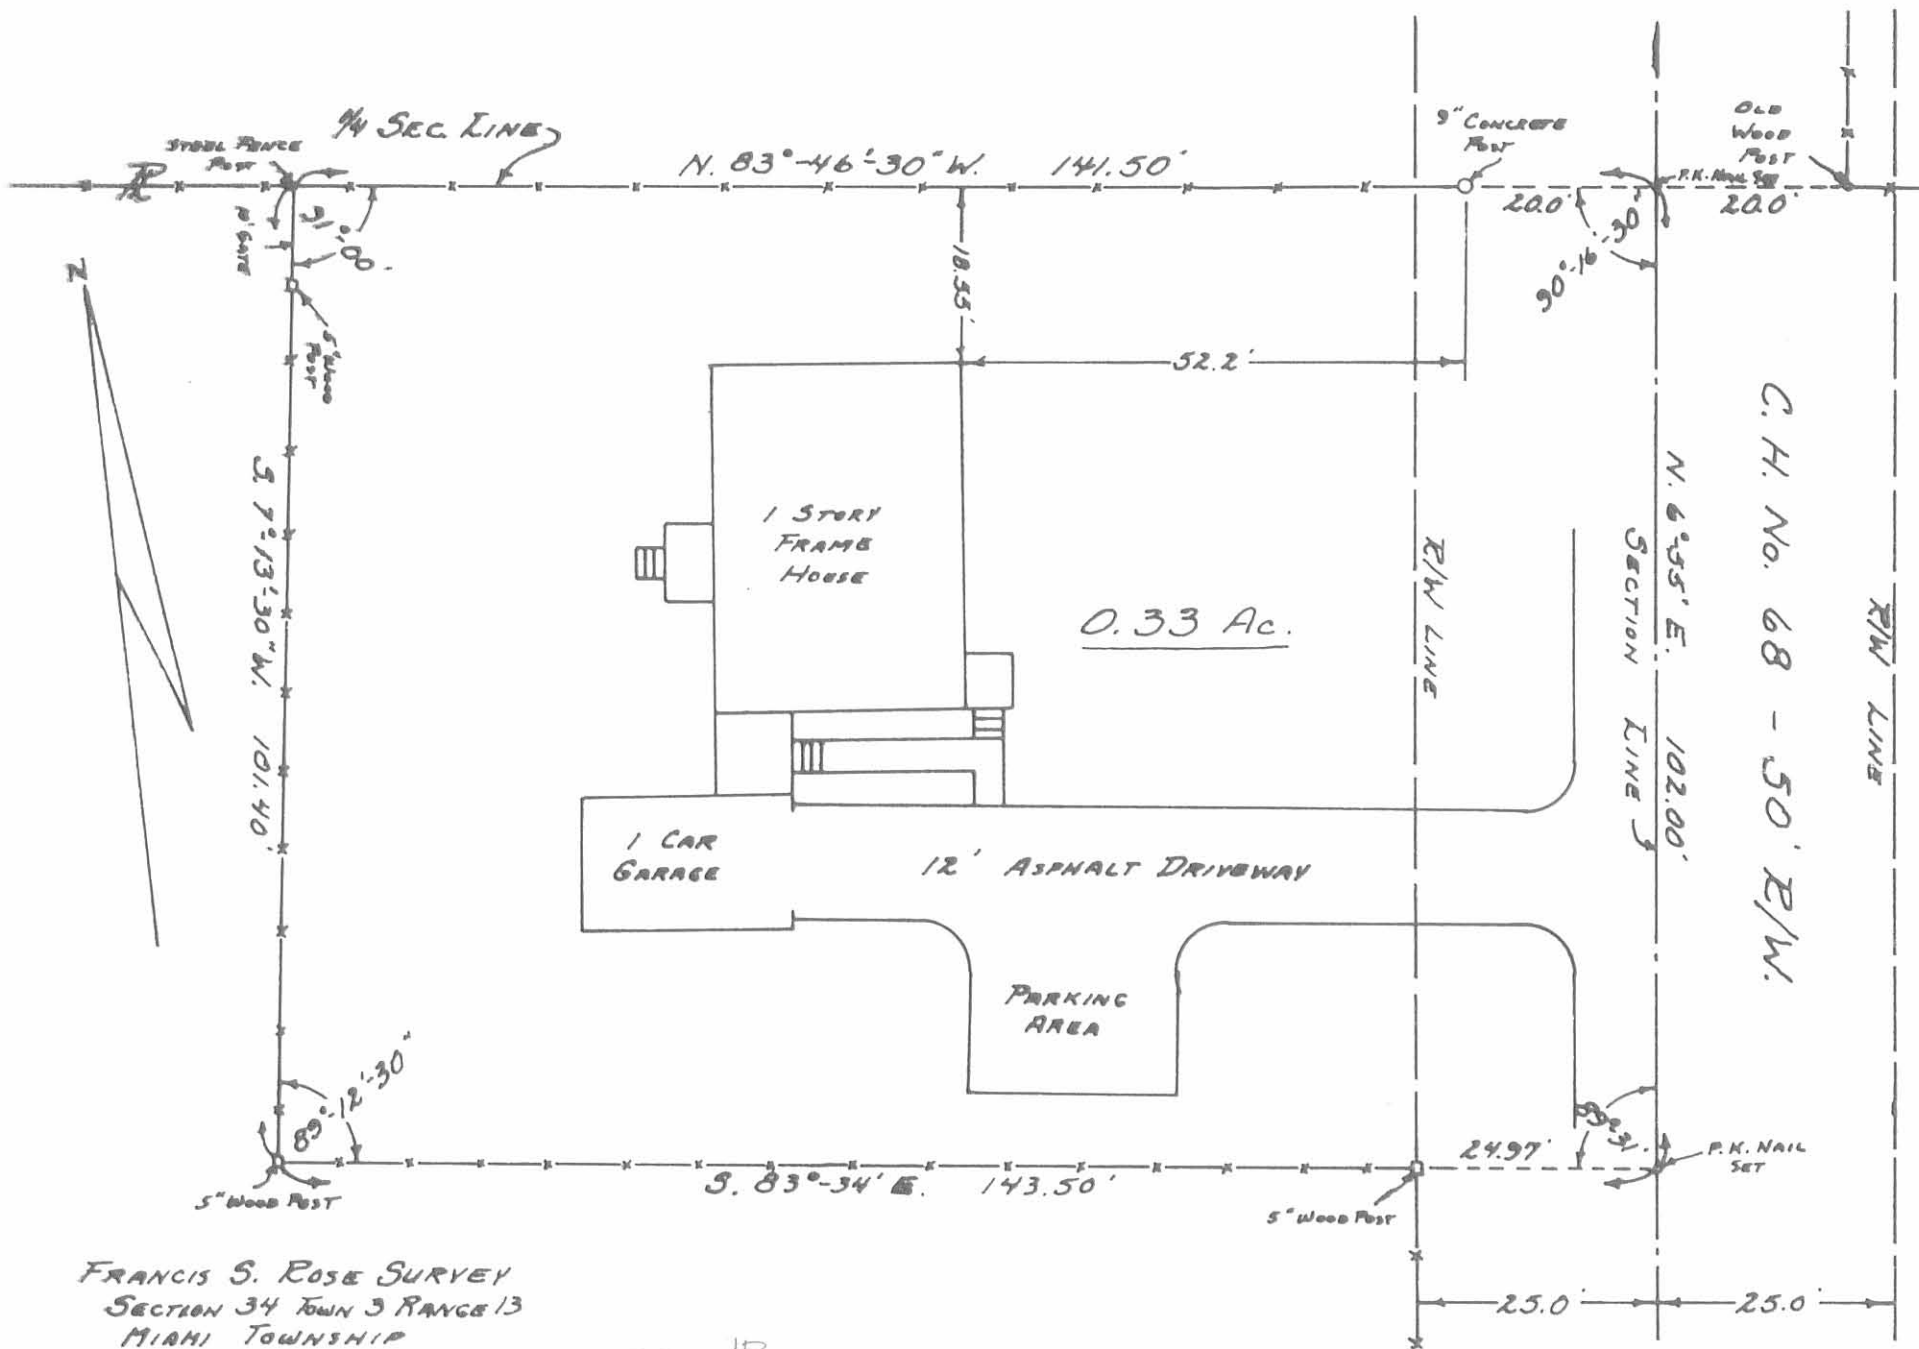

FRANCIS S. ROSE SURVEY
SECTION 34 TOWN 3 RANGE 13
MIAMI TOWNSHIP
LOGAN COUNTY, OHIO

OCTOBER 21, 1967

SCALE: 1" = 20'

IP
4133
INDEXED ON MAP

SURVEYED AND PLATTED BY:
DANIEL E. GILBERT, REG. SUR. No. 5402