

Jenkins to Hilderbrandt Survey Description
November, 1972

Being situated in Miami Township, Logan County, Ohio; and being a part of Section 11, Town 3, Range 13, M. R. S..

Beginning at a iron at the intersection of Township Road 71 and Township Road 72.

Thence with the center of Township Road 71 East 636.5 feet to the point of beginning for this description.

Thence continuing with the center of Township Road 71 East 699.5 feet to a iron.

Thence S 0° - 10'W 512.0 feet to a iron.


Thence S 89° - 09'W 716.0 feet to a iron.

Thence N 1° - 58'E 523.0 feet to the place of beginning.

Containing 8.41 acres more or less. Being surveyed from a 80.00 acre tract.

Owen K. Shirk
Surveyor 4271

JENKINS TO HILDERBRANDT SURVEY
 MIAMI TOWNSHIP, LOGAN COUNTY, OHIO
 SECTION 11, TOWN 3, RANGE 13, M. R. S. ; 1" = 200'
 FROM A 80.00 AC. Tr.

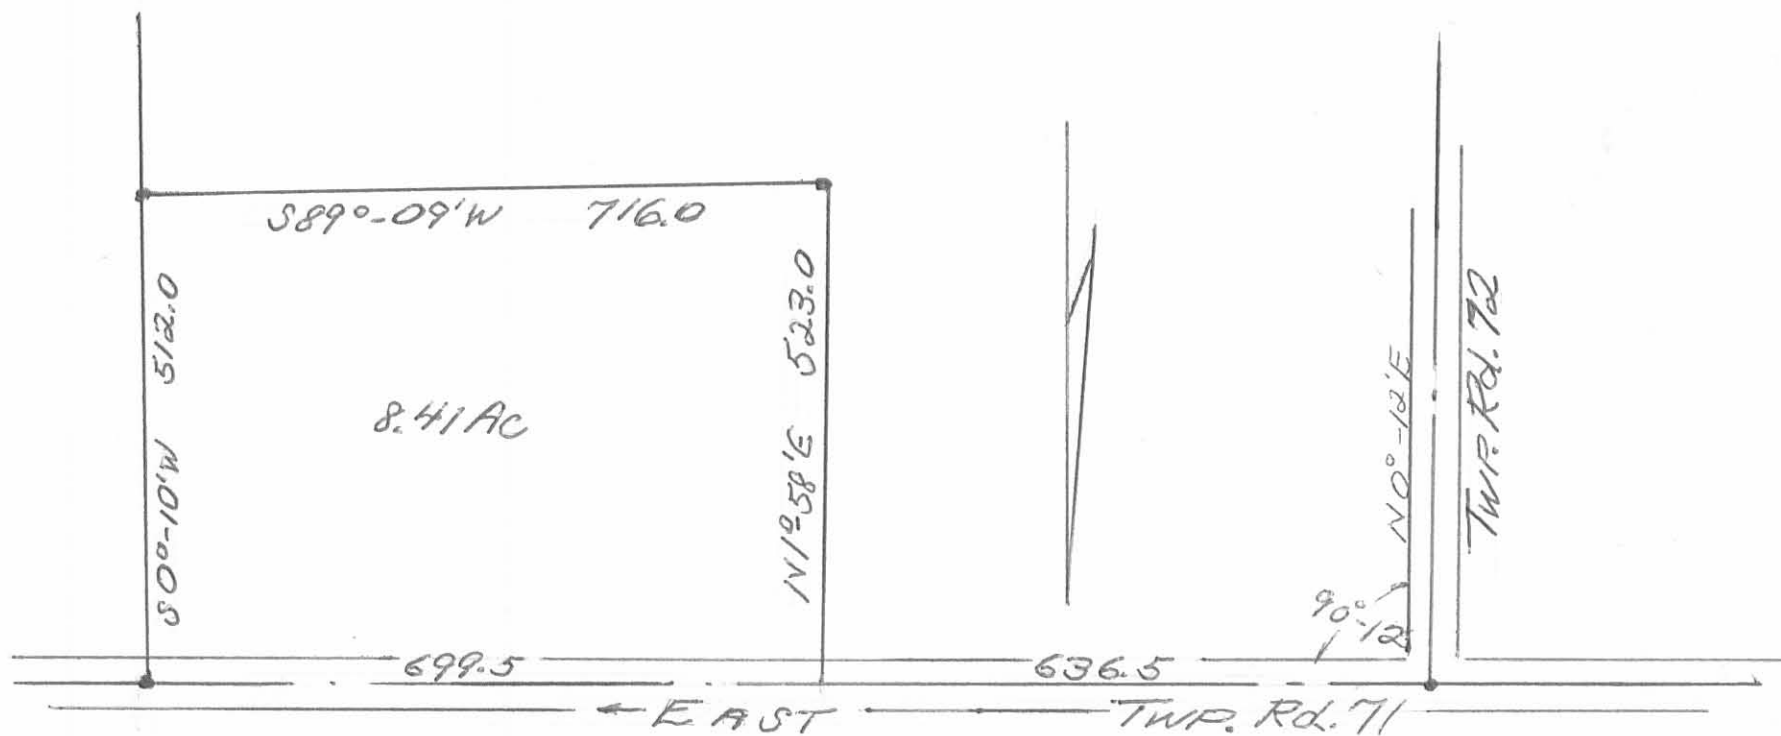

Owen K. Stirk
 Surveyor 4271
 11-11-72

INDEXED ON MAP

IP 5144