
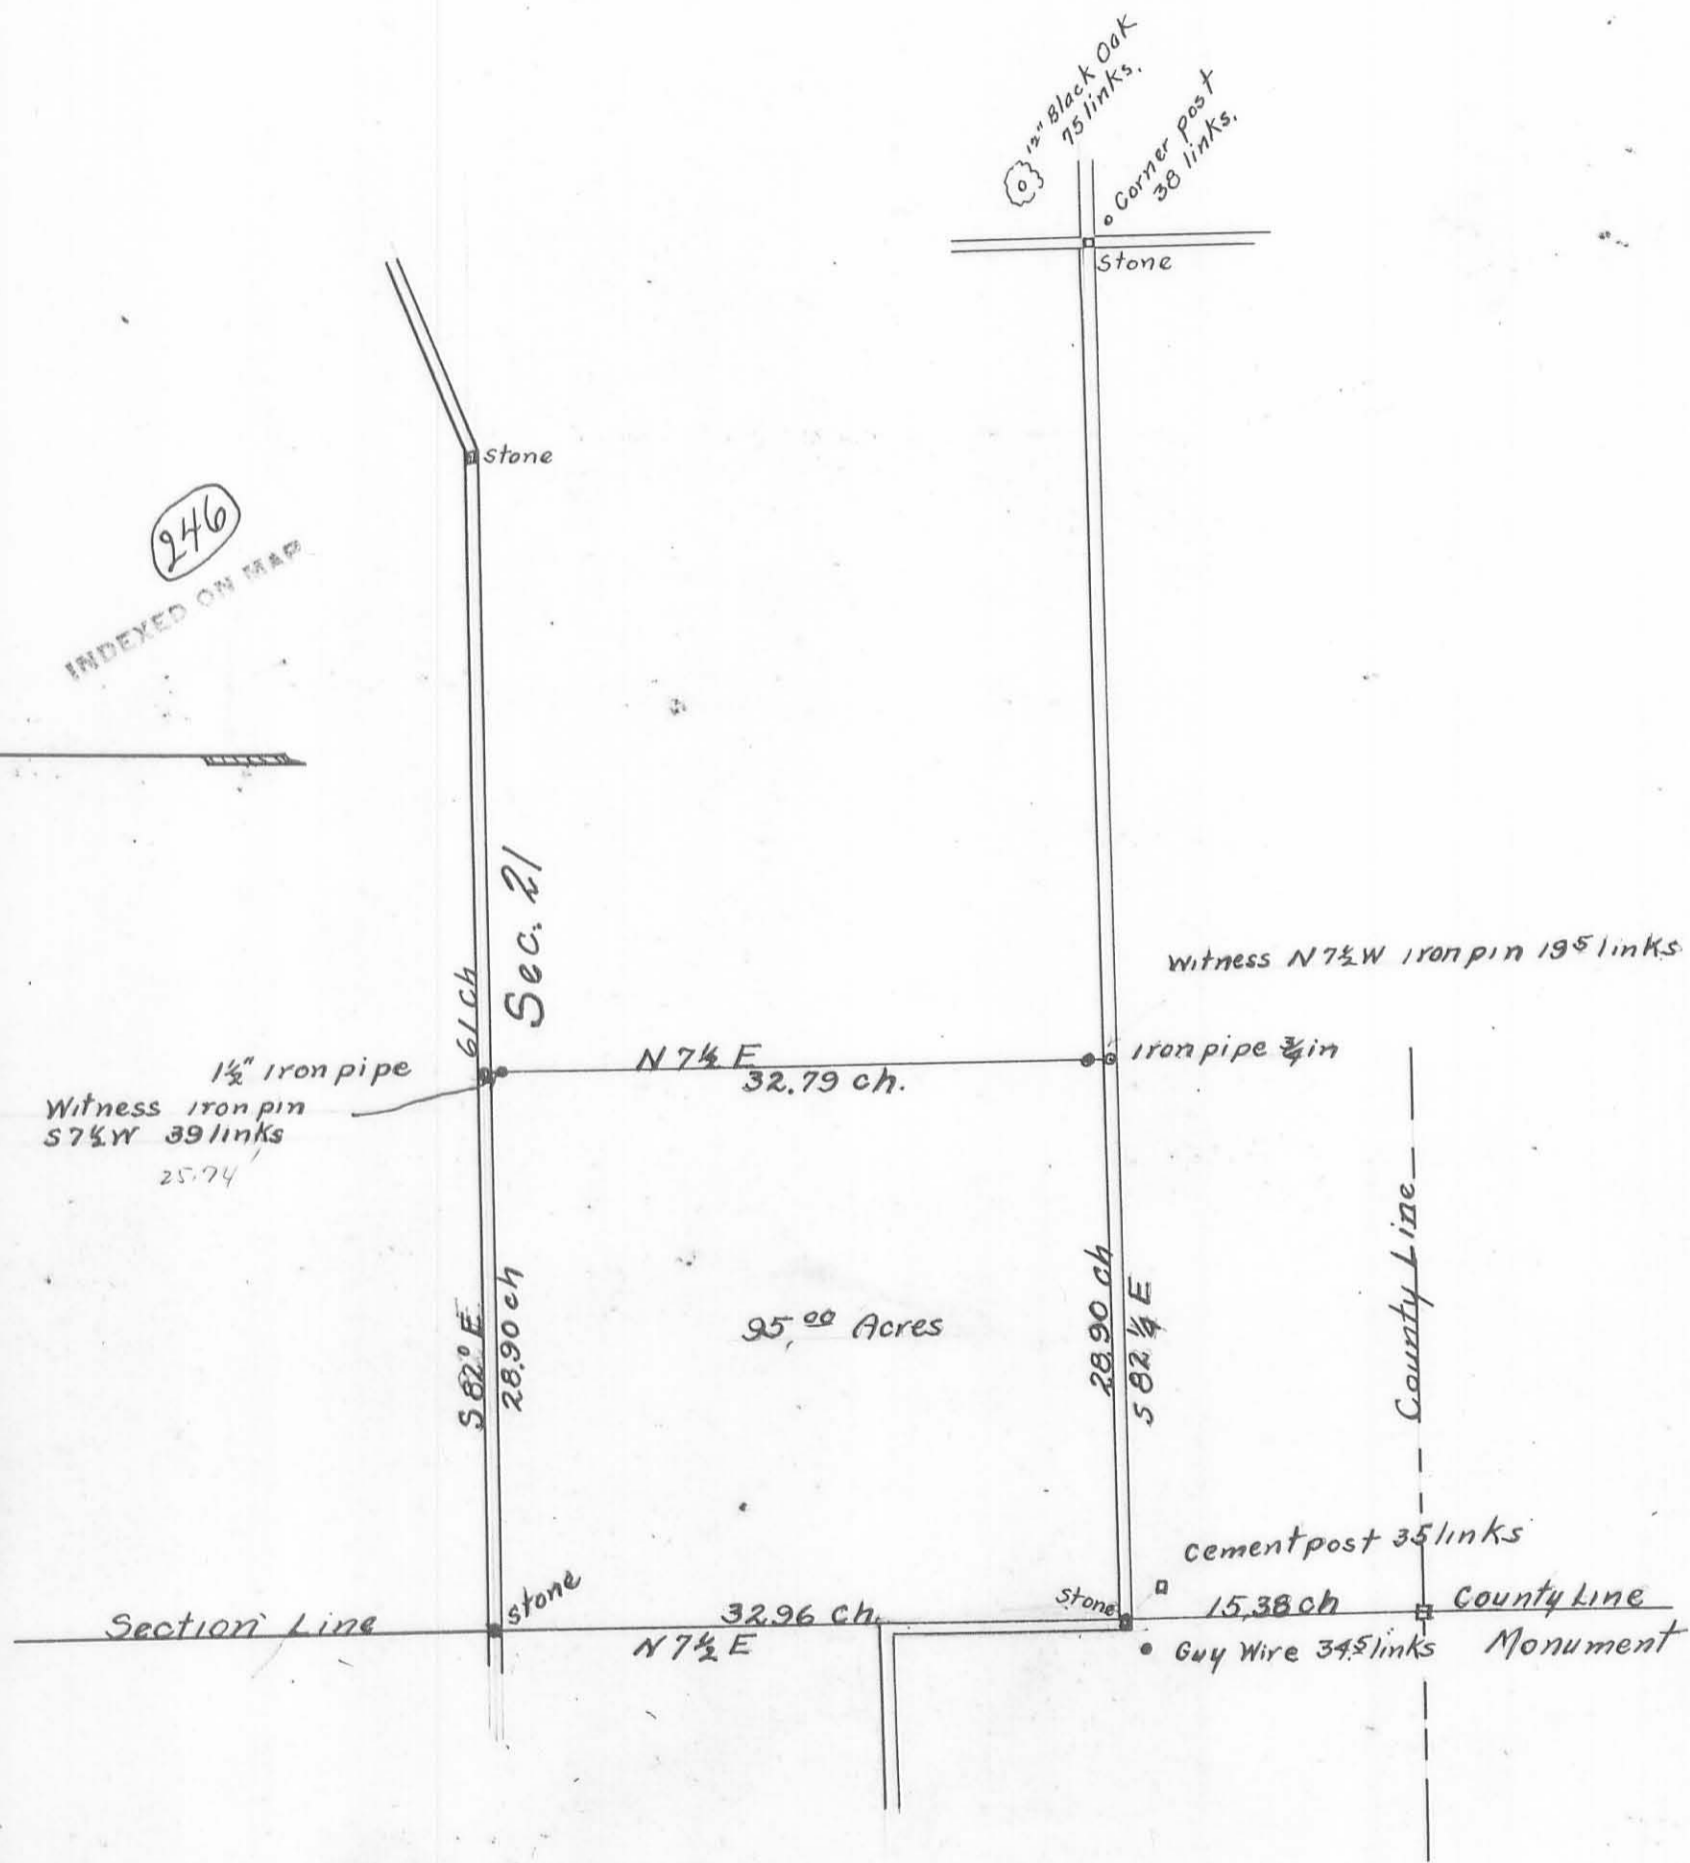


246

INDEXED ON MAP

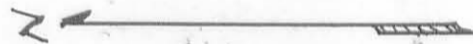

SURVEY
of
Part of Sec. 21 T 5 R 13
for Jacob. I. Piatt.
Feb. 27 1922
by
W.A. Montgomery
Deputy Co Engineer