

(1146) ✓
INDEXED ON MAP

Stayrock Survey
Marion Twp. V.M.S. { 9592
9018
10075

Distances shown are from Deed.


Deed Stanley To Stayrock Book 136 Page 275
Deed Stanley To Stanley Book 114 Page 519
Deed Branson To Rickets Book 128 Page 240
Deed Short To Williams Book 115 Page 325
Deed Stanley To Stanley Book 112 Page 248

See Book 390A Page 113

Dec. 14 1929
Not sold
Clard
Kitty H.
Bill's Wagon.

16

Deed recorded P. 89
in Twp

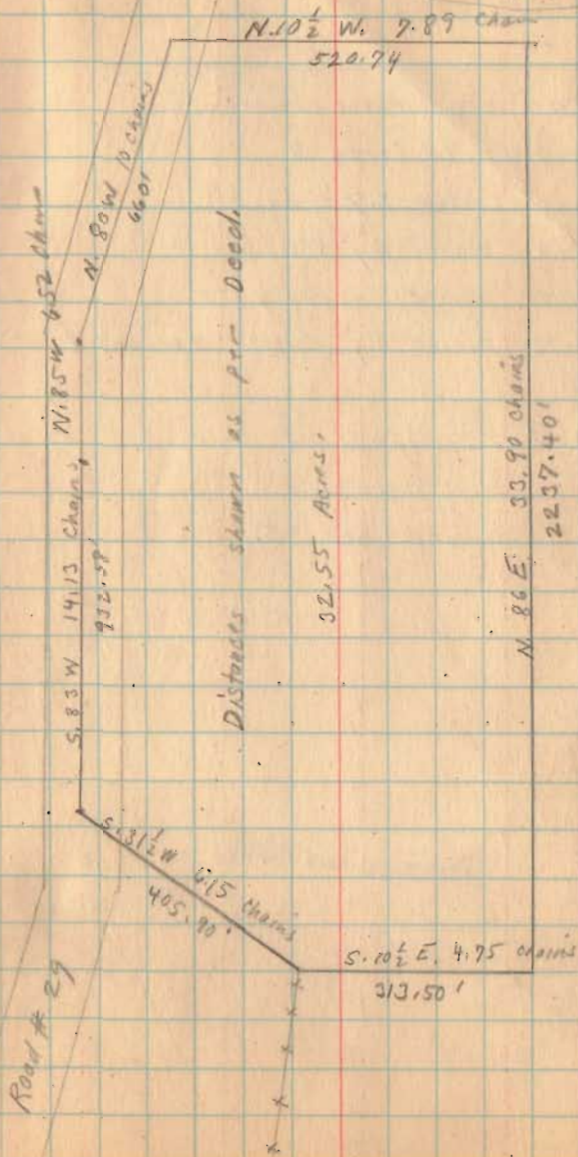

Stayrock Survey (Continued)

- A - Post at Fence Corner
- B - Stone 9.0' from D
- C - High Stump 7.7' from D
- D - Stake placed by Wright
- E - stake placed by Wright
- F - Stake placed by Wright apparent E of Pike

Used Deed Distances and measured as shown

Placed stakes on line DE

INDEXED ON 1228

12-14-29

17

