

FB 602

Road. 29

Liberty - Monroe - Jefferson Twp.

See Book 511 Page 41
for 1929 Survey.

Oct. 18, 1939 - Staked 60' - 30' R&L from E.

(4753)

(2709)

(4753)

NW Post
25' from E

1345


INDEXED ON MAP

Nov. 13, 1937
F. Wright
G. Wilges
W. R. Wright

23

Yoid
See Page 53

$\Delta = 15^{\circ} 54'$
 $R = 716.07$
 $E = 6.95$
 $T = 100.00$

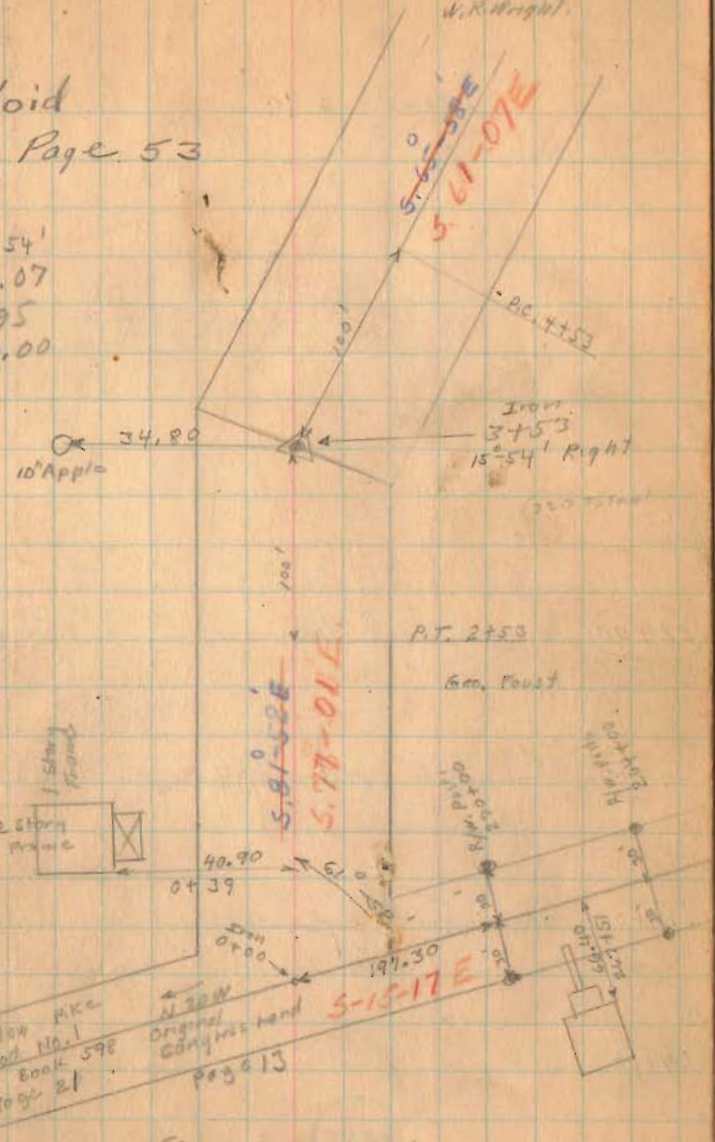

(See page 53)


FB 602

Road. 29

10-12-32

24

x x 25+00 x Z

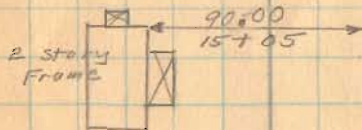

(22+00) Monuments (Hubs Set)

(17+00) Monuments (Hubs Set)

(12+00) Monuments (Hubs Set)

(7+00)

1345

INDEXED ON MAP

With Early

x x 10+95 x
Patrick Fitzpatrick.

561-07E

Patrick Fitzpatrick
(old R.R.) 6+13

W.H. Early
6+13
Geo. Foot

FB 602

Road 29

19-12-37 25

(37+00) Monuments (Hubs Set)

(32+50) Monuments (Hubs Set)

(27+12) Monuments (Hubs Set)



1345

INDEXED ON MAP

56°-56'E

51°-05'-47"E

S. 64.5° E.
N. 25.5° W.

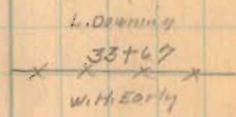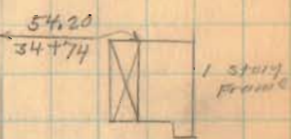

Don
27+12
0°-11' Right



FB 602

Road 29

62+75 Monuments (Hubs Set)

63+00 Monuments (Hubs Set)

58+25 Monuments (Hubs Set)


55+00 Monuments (Hubs Set)

49+00 Monuments (Hubs Set)

1345

INDEXED ON MAP


Nov. 15-1939 27
Cloudy
F. Wright
G. Wright
W.A. Wright

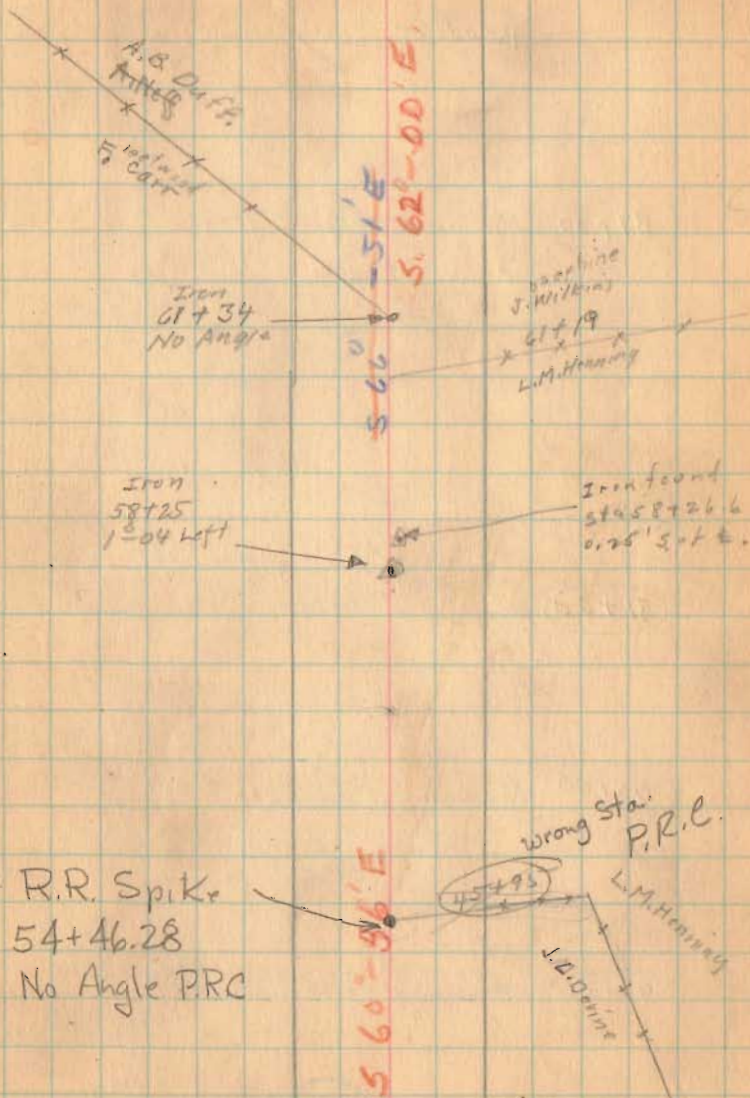

FB 602

Road 29

87+00 Monuments (Hubs Set)

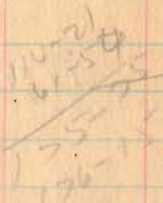

85+00

Monuments (Hubs Set)

81+00

Monuments (Hubs Set)

Notes Sta. 70+00 to 70+14 - 1" Cor. N. Side

76+00

Monuments (Hubs Set)

71+00

Monuments (Hubs Set)

1345

INDEXED ON MAP

11-15-30

28

Hubs Found
5/17/69
Set 3/4" P Bar
on N. side Hub
D.L.O. 85+67

No Angle

Susie H. Hester

Road 55
Book 607
Page 28

Henry

A. N. G. E.

Susie H. Hester

741

740

739

1 story
75+43

Iron
20+28
0' 53" Right
OK

79+20

68+10

70+51

2 story
Frame

3 61-07E
5 65-38E

562-00E

FB 602

Road 29

11-15-25

29

95100

94100


See Page 52

92100

Monuments (Hubs Set)

1345

INDEXED ON MAP

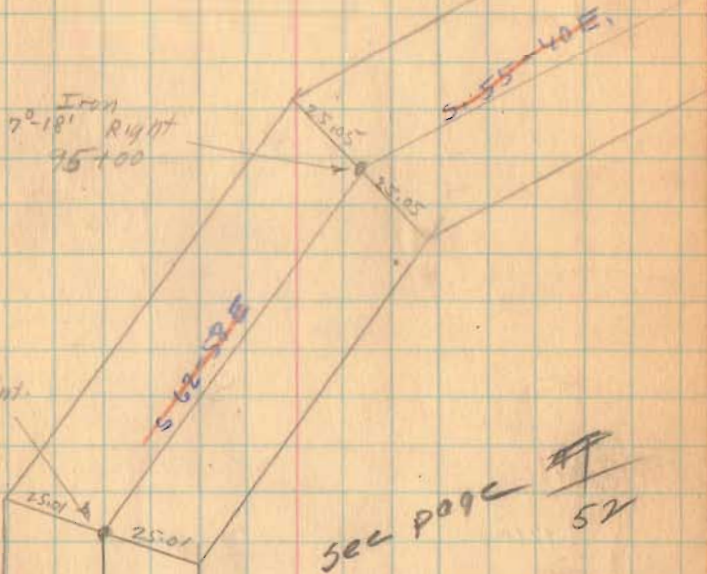

See page 52

S 61-07 E

S 65-58 E

94
55 67

8 9
7 70
41

FB 602


Road. 29

11-15-37

30



597-70 E.
 598 S
 599 S

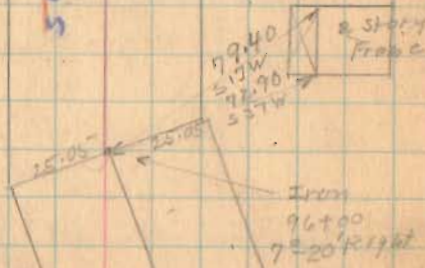

~~97-10~~

~~96-10~~

1345

INDEXED ON MAP

FB 602

Road 29

~~111+00~~

108+00 Monuments (Hubs Set) end of Project.

~~100+00~~

103+00 Monuments (Hubs Set)

~~100+02~~

Tap Hubs Mon Set

~~100+00~~

1345


INDEXED ON MAP

11-15-37

31

90
2
3

S. 83° - 46' E.

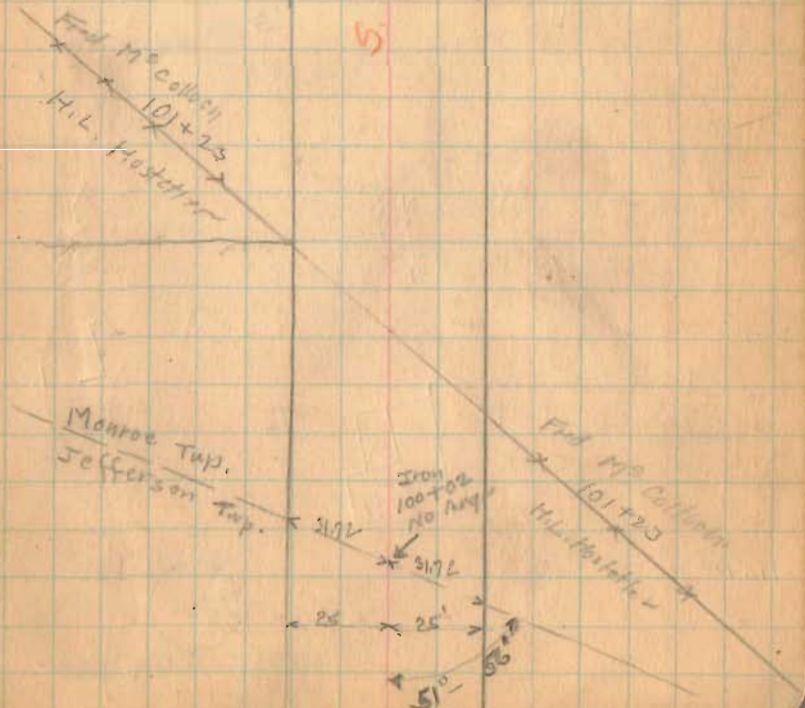

FB 602

Road 29

127+00

126+00

125+00

123+00

120+00

123+57.2

1345


INDEXED ON MAP

123 W
116 SE
684

11-15-37

33

125+80
Old RR 4.11

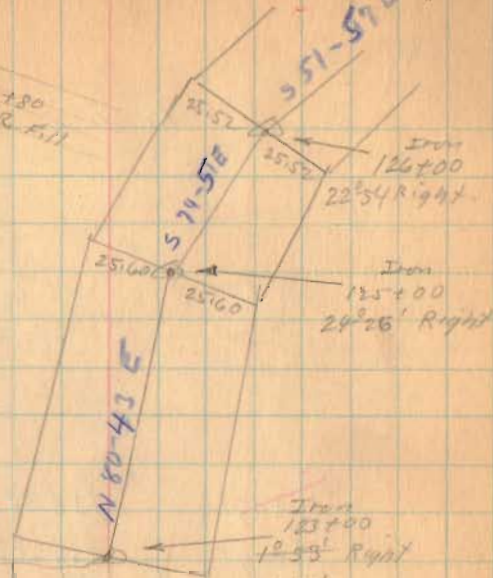

122+70.8

Paul
A.G. Sidwinger

118+97

119+25

Walter

Lane

118+86

Fred M^cCollogh

Paul
A.G. Sidwinger


118+19

Fred M^cCollogh

N 78-50 E

FB 602

Road 29

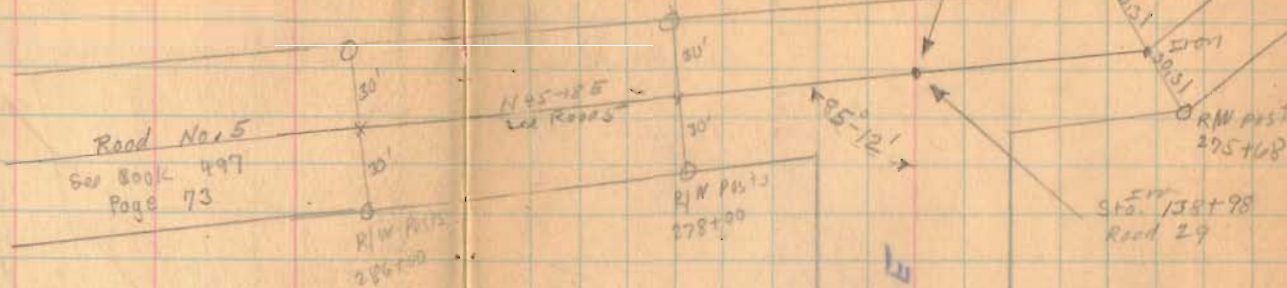

Length 13898 Feet
 Length 2.6322 Miles
 Length 2.63 Miles

138+00


134+00

1345

130+00

INDEXED ON MAP

Nov. 16, 1937
 cloudy - Light Rain
 F. Wright
 G. Wilgus
 W. K. Wright

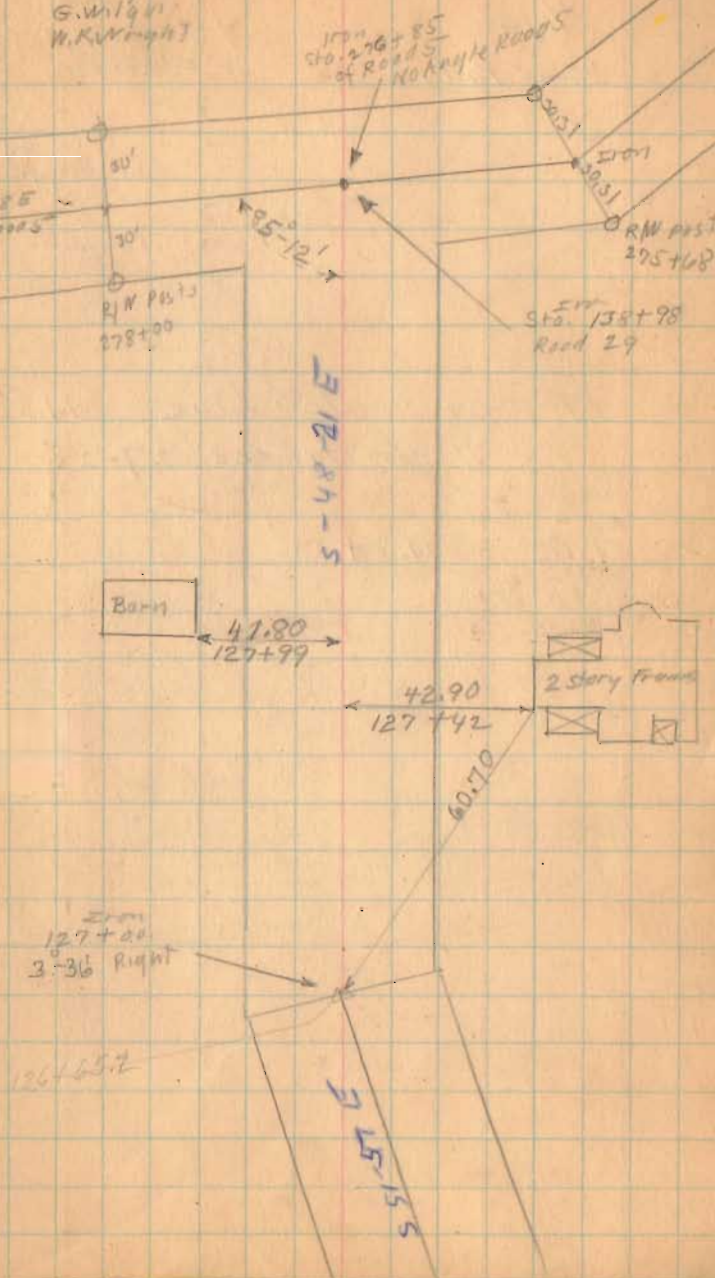

FB 713

C.B. 29
Jefferson Twp.
Logan Co., Ohio

99+95.95 - P.O.T. - Fd. 1/2" dia. iron
bar in monument box - Twp.
Line - Ref: F.Bk. # 402, pg. 31
& plan X-29

93+17.11 - P.O.T. - Fd. R.R. Spike -
S.E. corner 14.08 Ac. tract -
(R-5277)

90+98.81 - P.O.T. - Fd. R.R. Spike -
N.E. corner 3.573 Ac. tract -
(R-5005)


85+47 - P.I. - Fd. 3/4" dia. iron bar ≈
14" deep - start of this survey -
Ref: F.Bk. # 402, pg. 28.

INDEXED ON MAP
1345

B. Simmonds
G. Dappert
C. Dill

Dec. 2014

60

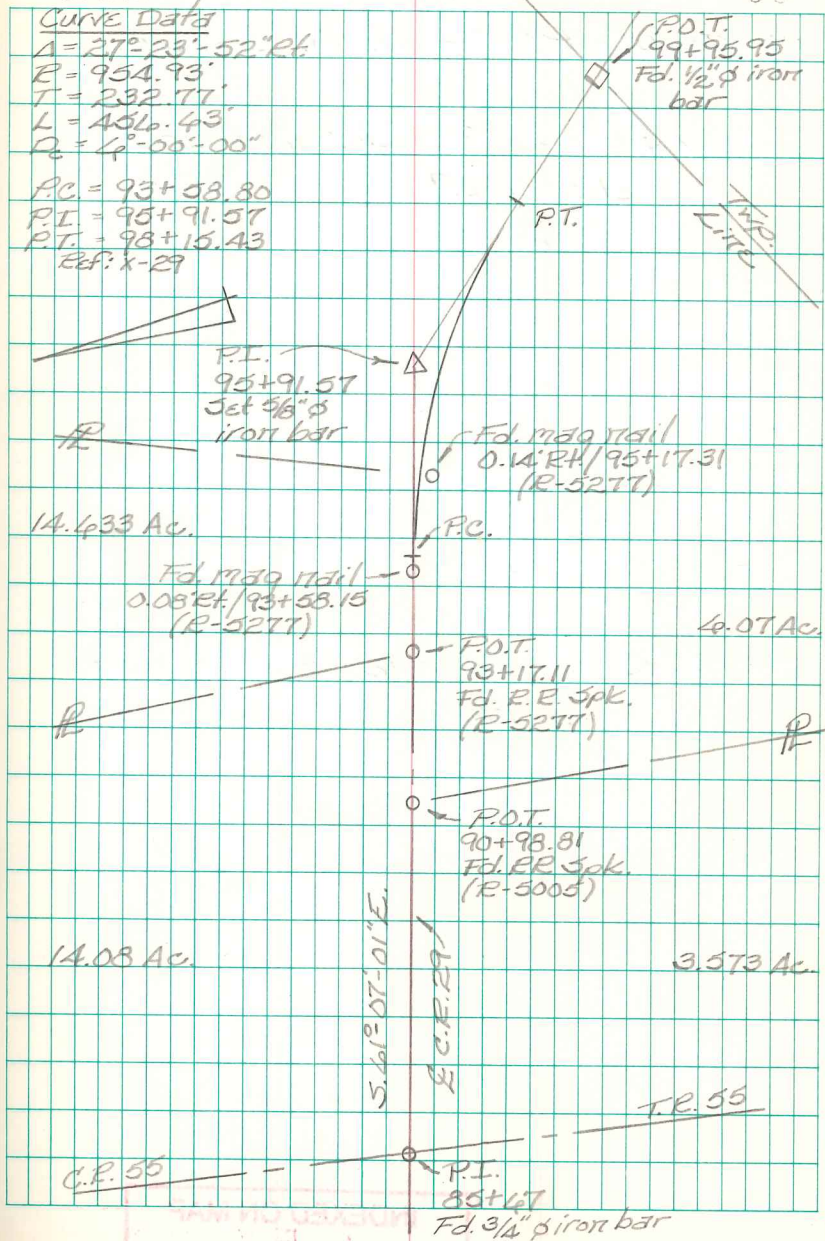

FB 713

C.R. 29
Morroe Twp.
Logan Co., Ohio

113+75.59 - P.O.T. - Set R.R. Spike

112+41.43 - P.I. - Fd. 1" dia. iron bar -
Ref: F.Bk. # 4666, pg. 32 &
X-29A.

42°-40'-02" Lt.

111+07.27 - P.O.T. - Set R.R. Spike

108+19.14 - P.O.T. - Fd. mag nail -
N.W. corner 3.463 Ac. tract


99+95.95 - P.O.T. - Fd. 1/2" dia. iron
bar in monument box. - Twp.
Line - Ref: F.Bk. # 402, pg. 31
& X-29.

INDEXED ON MAP
1345

B. Simmonds
G. Dappert
C. Dill

Dec. 2014

61

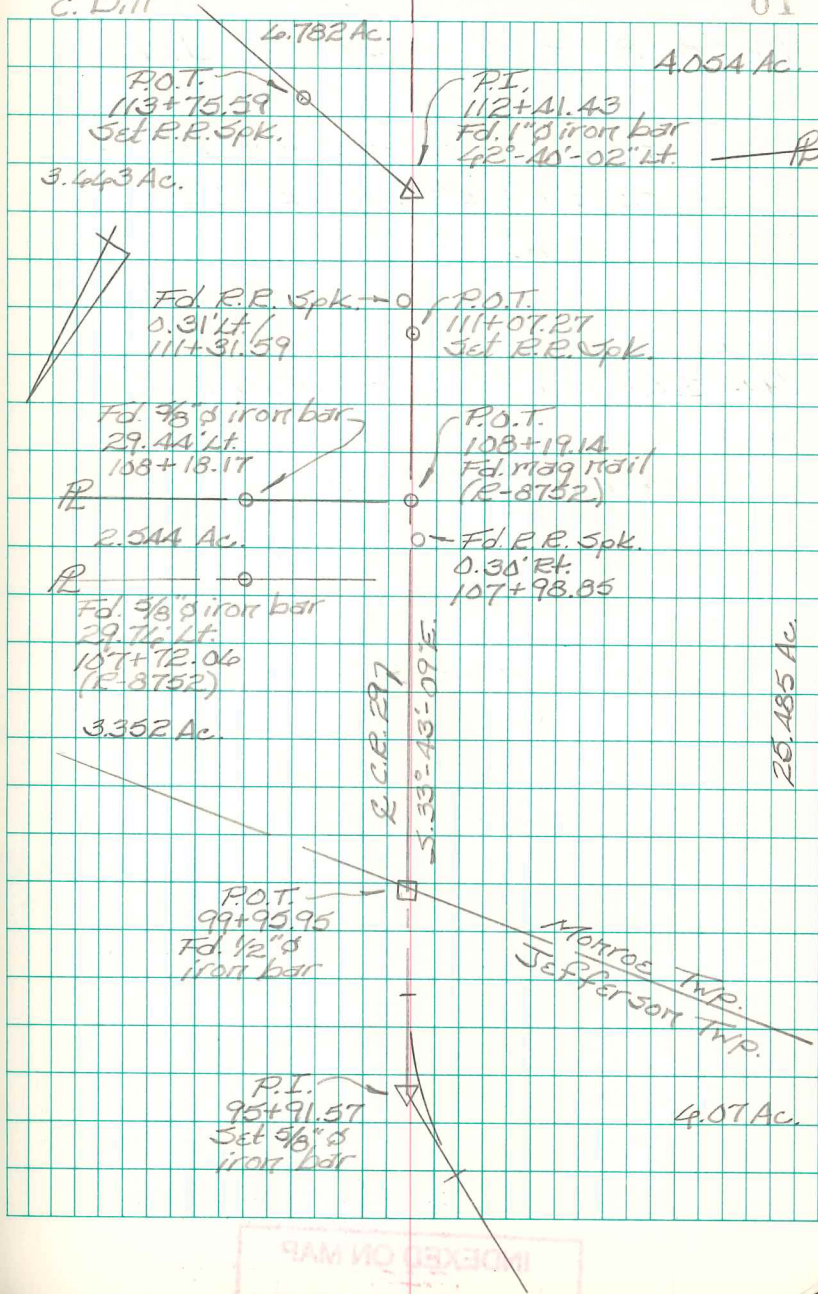

INDEXED ON MAP

FB 713

C.E. 29
Marion Twp.
Logan Co., Ohio

122+89.82 - P.I. - Set $\frac{5}{8}$ " dia.
capped iron bar - shown
as sta. 123+00 in F.Bk. # 602,
pg. 33. - Ref: F.Bk. # 666, pg. 33
3°-57'-19" Rt.

119+15.38 - P.O.T. - Fd. mag nail -
S.E. corner 5.062 acre
tract (R-8752).

116+34.20 - P.O.T. - Fd. mag nail -
S.W. corner 5.062 acre
tract (R-8752).

113+75.59 - P.O.T. - Set R.R. Spike


112+41.43 - P.I. - Fd. 1" dia. iron bar -
Ref: F.Bk. # 666, pg. 32 &
X-29A.
42°-40'-02" Lt.

INDEXED ON MAP
1345

B. Simmons
G. Dappert
C. Dill

Dec. 2014

62

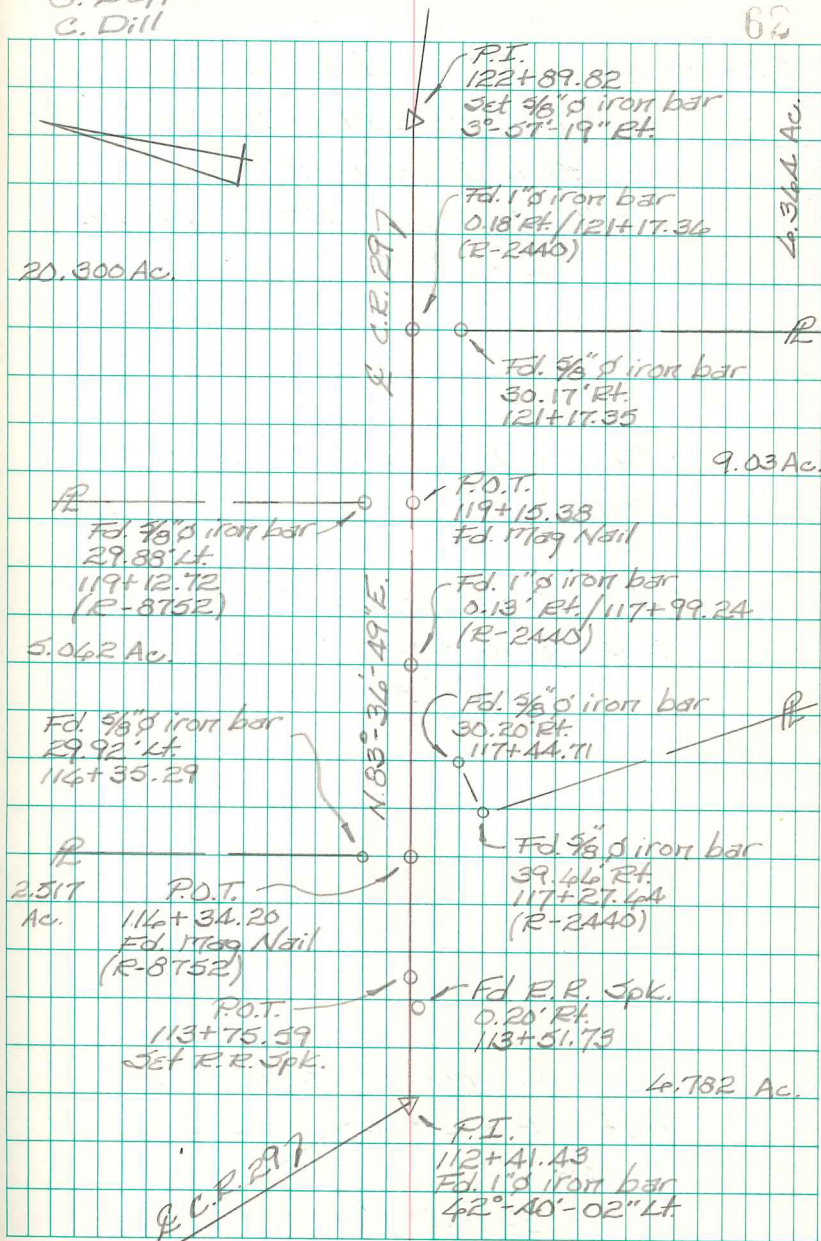

FB 713

C.R. 29
 Monroe Twp.
 Logan Co., Ohio

125+89.40 - P.I. - Fd. bent $\frac{1}{2}$ " dia.
 iron bar here in 1989 - replaced
 w/ $\frac{5}{8}$ " dia. capped iron bar
 at that time - shown as sta.
 124+00 in F.B.K. # 402, pg. 33
 $22^{\circ}-54'-57"$ Rt.


124+89.82 - P.I. - Fd bent $\frac{1}{2}$ " dia.
 iron bar here in 1989 - replaced
 w/ $\frac{5}{8}$ " dia. capped iron bar at
 that time - shown as sta.
 125+00 in F.B.K. # 402, pg. 33
 $24^{\circ}-24'-14"$ Rt.

122+89.82 - P.I. - Set $\frac{5}{8}$ " dia.
 capped iron bar - searched
 here for iron in 1989, found
 nothing - shown as sta.
 123+00 in F.B.K. # 402, pg. 33
 $3^{\circ}-57'-19"$ Rt.

B. Simmons
 G. Dappert
 C. Dill

Dec. 2014

63

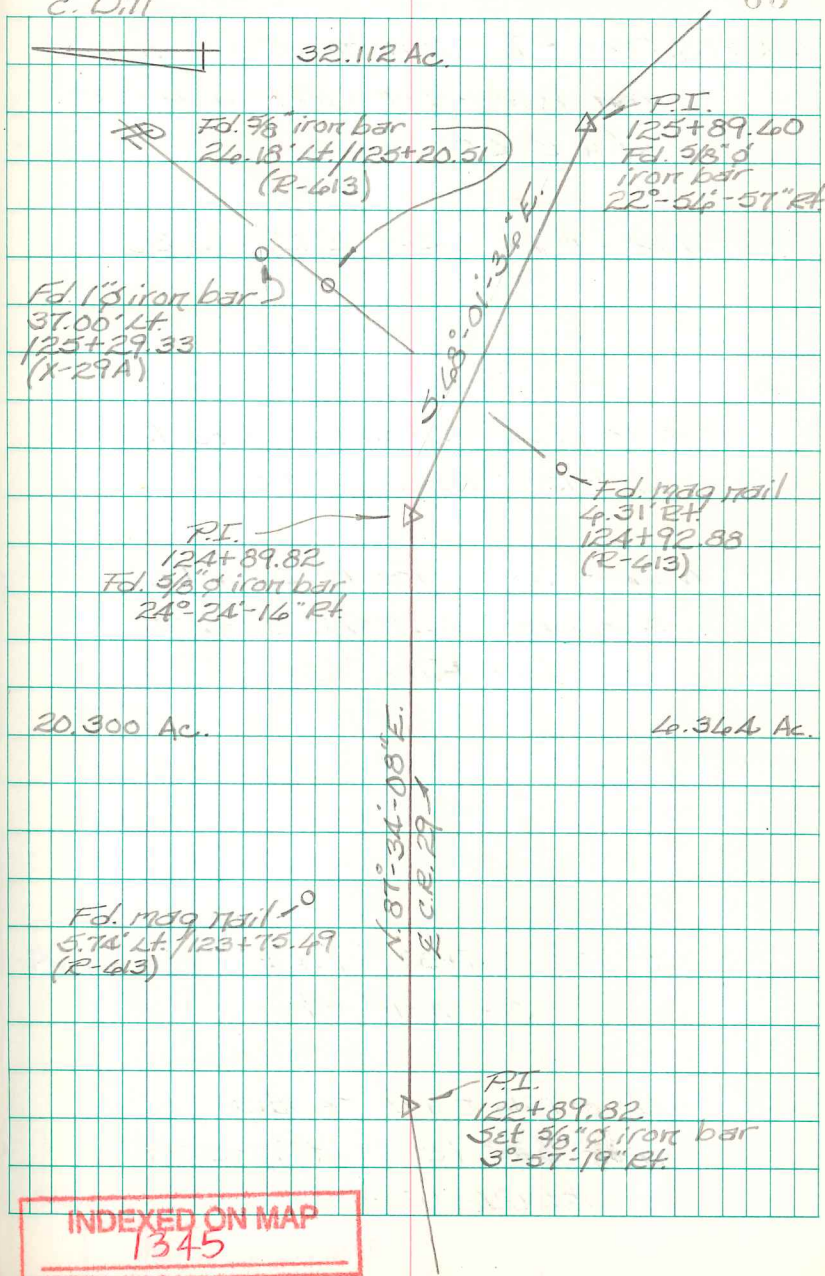

FB 713

C.R. 29
Morrow Twp.
Logan Co., Ohio

138+87.23 - P.I. - Set $\frac{5}{8}$ " dia. capped
iron bar - Intersection E C.R. 5
w/ C.R. 29

138+57.12 - P.O.T. - Set R.R. Spike

134+24.42 - P.O.T. - Fd. common nail
on split of R/W monuments -
 ≈ 10 " deep - Shown as Sta. 134+00
in F.Bk. # 466, pg. 36.

130+24.16 - P.O.T. - Fd. R.R. Spike -
 ≈ 8 " deep - Shown as Sta.
130+00 in F.Bk. # 466, pg. 36.


126+89.16 - P.I. - Fd. bent $\frac{1}{2}$ " dia. iron
here in 1989 - replaced w/ $\frac{5}{8}$ " dia.
capped iron bar at that time &
installed a monument box - shown
as Sta. 127+00 in F.Bk. # 402, pg. 34.
3°-34'-14" Rt.

125+89.40 - P.I. - Fd. $\frac{5}{8}$ " dia. capped
iron bar (circa 1989) - shown
as Sta. 126+00 in F.Bk. # 402, pg. 33
22°-56'-57" Rt.

B. Simmons
G. Dappert
C. Dill

Dec. 2014

64

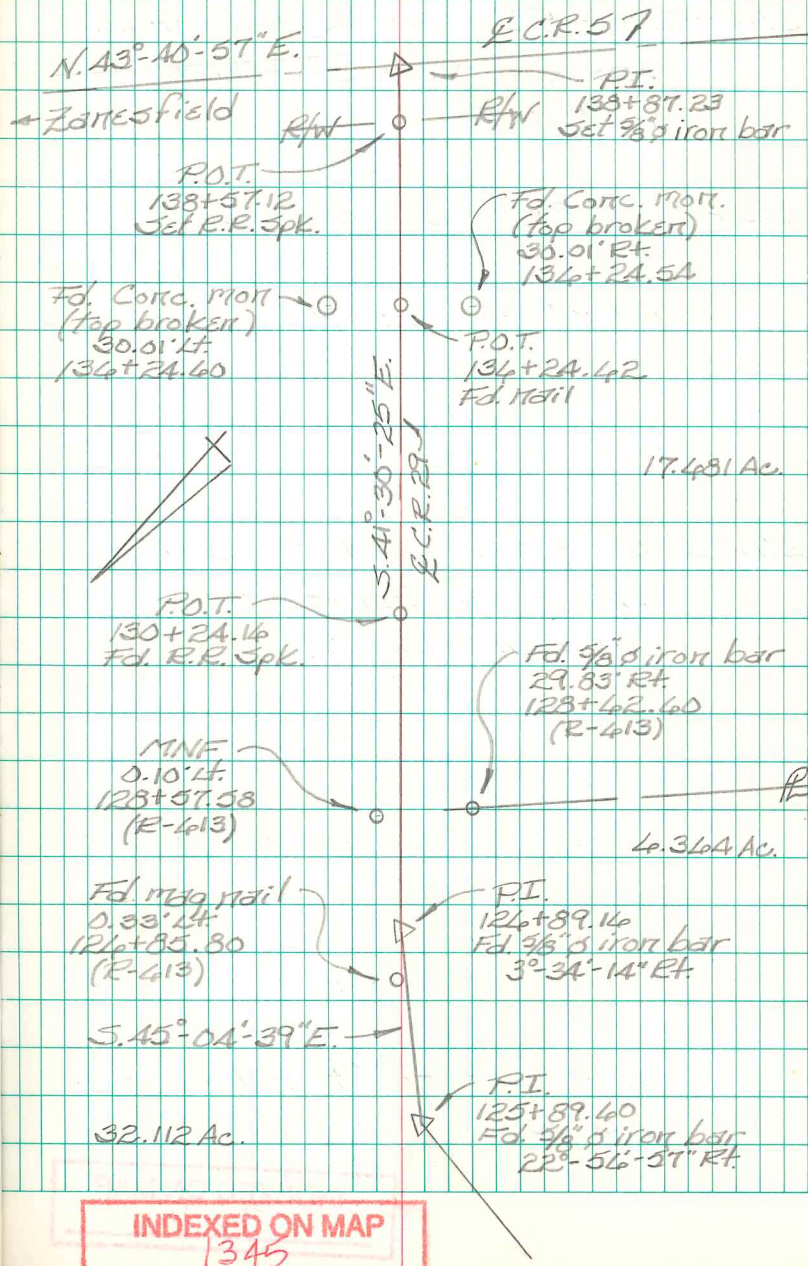

INDEXED ON MAP

1345

FB 713

Intersection C.R. 5 w/ C.R. 29

Monroe Twp.
Logan Co., Ohio

288+98.74 - P.I. - Fd. $\frac{5}{8}$ " dia. iron bar -
shown as Sta. 289+00 in
F.B.K. # 497, pg. 74.

285+99.11 - P.I. - Fd. $\frac{1}{2}$ " dia. iron bar -
shown as Sta. 284+00 in
F.B.K. # 497, pg. 74.

276+83.50 - P.I. - Set $\frac{5}{8}$ " dia.
capped iron bar - Intersection
C.R. 5 w/ C.R. 29
No Angle

275+48 - P.I. - Fd. 1" square
iron bar - Ref: F.B.K. # 497,
pg. 73.

INDEXED ON MAP
1345

B. Simons
G. Dappert
C. Dill

Dec. 2014

65

