



10-13-99  
Zybert  
Dickinson  
B. Wilgus

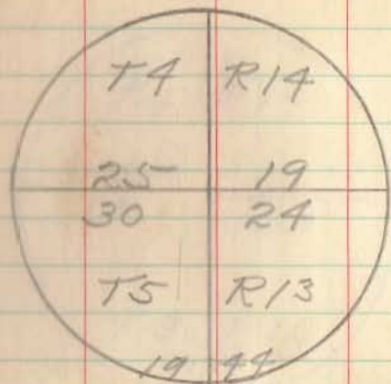

Found 2"x2"x24" Bar as called  
for in Book 498 p. 52  
Removed same and placed  
Con. Mon. Full Length  
Top 6" above ground  
Marked as above

A. J. Young Farm

41

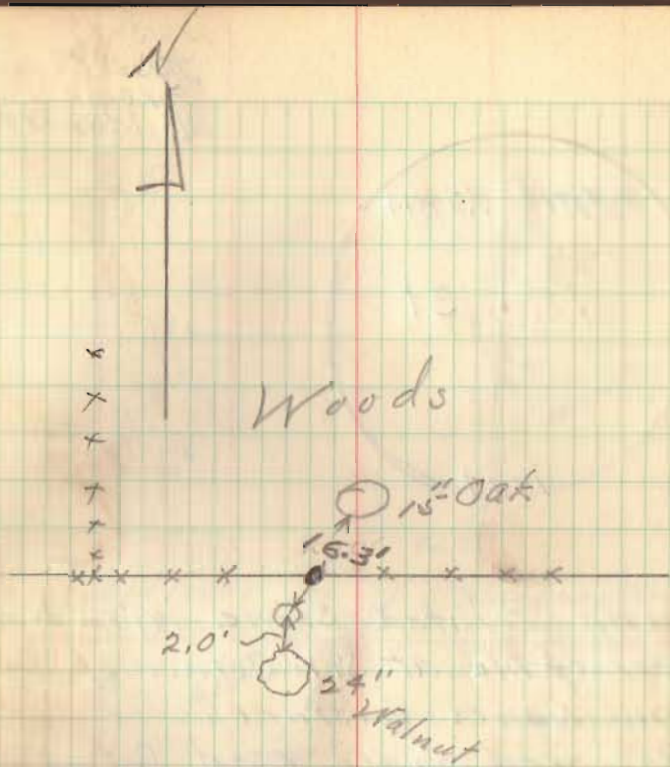

INDEXED ON MAP

Liberty &  
Monroe Twp.

2653

INDEXED ON MAP

✓