

Received 1-5-89

OK 1-6-89 C.R.

**LESLIE H. GEESLIN**  
REGISTERED SURVEYOR NO. 5248  
P. O. BOX 274  
RUSHSVLVANIA, OHIO 43347

TELEPHONE: (513) 468-2793

WEST LIBERTY LIONS CLUB SURVEY

January, 1989

The following described real estate situated in the State of Ohio, County of Logan, Township of Monroe, being part of the north-west quarter of Section 21, Town 5, Range 13, M.R.S. and more particularly described as follows:

Beginning at a railroad spike found at the northeast corner of the Village of West Liberty's 4.93 acre tract as described in O.R. Vol. 6 Page 933, said corner being in the centerline of Township Raod 174 and the north line of Section 21.

Thence with said centerline and section line S. 85° 43' E. 101.42 feet to a cap and nail set.

Thence S. 5° 00' W. 2148.41 feet to a cap and nail set in the centerline of State Route 245, passing 0.625 inch iron bars set at 25.00 feet and 2118.41 feet.

Thence with said centerline of S. R. 245 N. 85° 08' 42" W. 101.42 feet to a railroad spike found at the southeast corner of said 4.93 acre tract.

Thence with the east line of said Village's 4.93 acre tract N. 5° 00' E. 2147.40 feet to the place of beginning.

Containing 5.001 acres more or less.


The above described 5.001 acre tract being on the west side of Albert Gantz's 235.47 acre tract as described in D. B. Vol. 391 Page 652.

The bearing of S. 85° 43' E. for T. R. 174 was assumed and all other bearings are from angles and distances measured in this field survey.

INDEXED ON MAP  
5608 1D



*Leslie H. Geeslin*

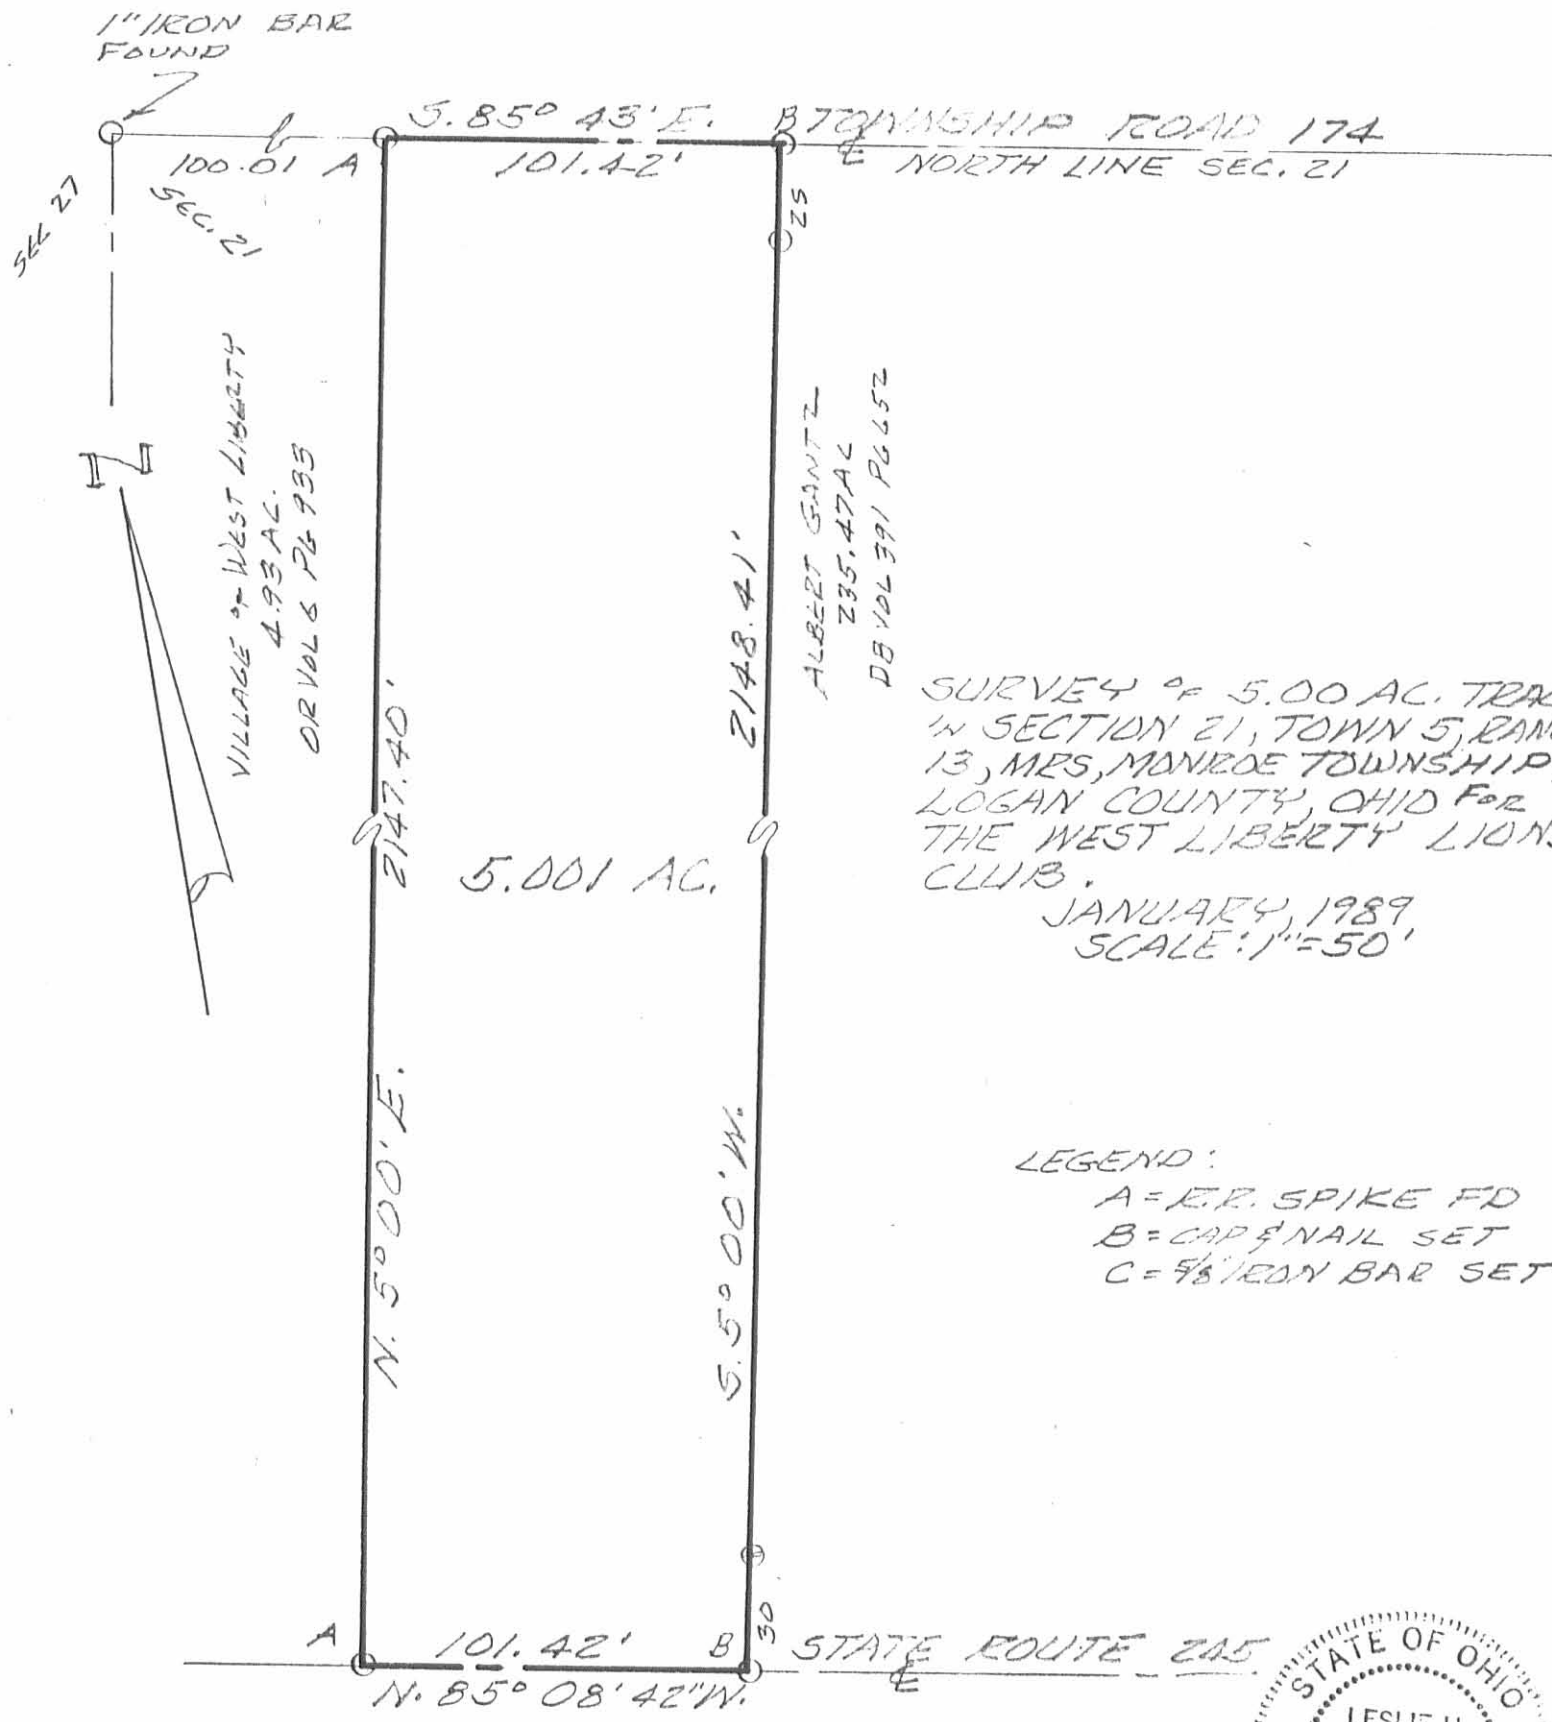

1" IRON BAR FOUND

S. 85° 43' E. 101.42' B TOWNSHIP ROAD 174  
NORTH LINE SEC. 21

VILLAGE OF WEST LIBERTY  
4.93 AC.  
OR VOL 6 PG 935

ALBERT GANTZ  
235.47 AC  
DB VOL 391 PG 652

SURVEY OF 5.00 AC. TRACT  
IN SECTION 21, TOWN 5, RANGE  
13, MRS. MONROE TOWNSHIP,  
LOGAN COUNTY, OHIO FOR  
THE WEST LIBERTY LIONS  
CLUB.

JANUARY, 1989  
SCALE: 1" = 50'

LEGEND:

- A = E.P. SPIKE FD
- B = CAP & NAIL SET
- C = 1/2" IRON BAR SET

INDEXED ON MAP  
5608 IP



*Leslie H. Geeslin*  
LESLIE H. GEESLIN  
RUSHSVLVANIA, OHIO

WEST LIBERTY LIONS CLUB

September, 1974


The following described real estate situated in Monroe Township, Logan County, Ohio and being part of Section 21, Town 5, Range 13 of the Between the Miami Rivers Survey and more particularly described as follows:

Beginning at an iron bar in the southeast corner of the Village of West Liberty's 0.71 acre tract in Section 27 as surveyed by the Logan County Engineer, said iron bar being in the west line of Section 21 and the centerline of S.R.245; thence with said west section line N.5°00'E. 2145.4 feet to an iron bar in the centerline of T.R.174 at the northwest corner of Section 21, passing irons at the southeast and southwest corners of the Village of West Liberty's 6.00 acre tract at 774.4 feet and 1454.6 feet; thence with said centerline and the north line of Section 21 S.85°43'E. 100.0 feet to an iron bar; thence S.5°00'W. 2147.4 feet to an iron bar in the centerline of S.R.245; thence with said centerline N.85°08.7'W. 86.5 feet to an iron bar; thence with said centerline N.80°51.7'W. 13.5 feet to the place of beginning.

Containing 4.93 acres more or less.

The above described 4.93 acres being on the west side of Albert J. Gantz's 246.40 acre tract.

I hereby certify that the above is a true and accurate description of a survey made by me.

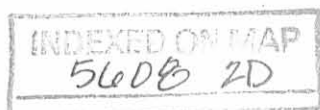

Leslie H. Geeslin  
Registered Surveyor 5248  
Rushsylvania, Ohio 43327

Sec. 28 T5 R13  
5.72 7.5 R13

1" φ BAR FD  
SEC 27 T5 R13

TR. 174  
S 85° 43' E.  
R.R. SPR SET

VILLAGE OF WEST LIBERTY  
1.5 AC

1 1/2" PIPE FD

VILLAGE OF WEST LIBERTY  
6.00 AC.

WEST LIBERTY LIONS  
SEPTEMBER, 1974  
S 21 T 5 R 13  
MONROE TOWNSHIP  
LOGAN COUNTY, OHIO  
SCALE 1" = 300'

1" φ BAR FD

174.4' 0.71 AC.  
680.2'  
N. 5° 00' E.  
2125.4'  
4.93 AC.  
5.5° 00' W. 2727.4'

R.R. SPR FD  
R.R. SPR SET

TR. 245  
N 80° 51.7' W 73.5'  
N 85° 08.7' W 86.5'

5608 2P

LESLIE H. GEESLIN  
REG. SURVEYOR 5248

INDEXED ON MAP