

DEED DESCRIPTION

2.90 Acres out of Jack & Sharon Johns 132.81 Acres
Monroe Twp., Logan County, Ohio, May, 1977

Situated in the State of Ohio, County of Logan, Township of
Monroe, Virginia Military Survey # 10,853, more particularly
described as follows:

Beginning at an iron bar in the center of Monroe Township Road
No. 190 and in the east line of Virginia Military Survey # 10,853,
said iron bar also being in the west line of Velma Godwin's
41.00 acre tract; thence South 85 Degrees 21 Minutes West
with the center of said township road # 190 517.50 feet to an
railroad spike which is the true point of beginning of this
description;

thence continuing with the center of said road South 85 Degrees
21 Minutes West 150.00 feet to an iron;

thence North 30 Degrees 32 Minutes East, passing an iron bar
set on the road right of way at 30.59 feet, 1157.60 feet to an
iron bar;

thence South 5 Degrees 07 Minutes West 210.35 feet to an iron bar;

thence South 30 Degrees 32 Minutes West, passing an iron bar set
on the road right of way at 869.81 feet, 900.40 feet to the point
of beginning, containing 2.90 acres more or less.

Surveyed by Larry E. Blosser SIT # 1199

6024 ID

INDEXED ON MAP


Checked by: David E. Gilbert P.S.
Registered Surveyor # 5402

A SURVEY OF A 2.90 ACRE TRACT OUT OF
 JACK L. & SHARON L. JOHN'S
 132.81 Acres
 V.M.S. #10853 - MONROE TWP.
 LOGAN COUNTY OHIO
 MAY 12, 1977

By Larry E. Blosser SIT # 1199

Checked By: Daniel E. Milburn, P.S.
 Registered Surveyor # 5402

JACK L. & SHARON L. JOHNS
132.81 Ac.
 Less 2.90 Ac.

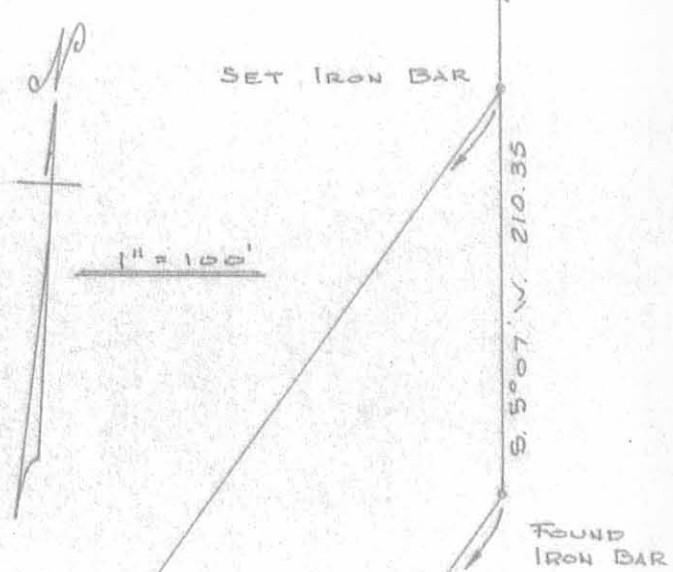

DONALD G. WYSE ETUX
15.60 Ac.

6024 IP

INDEXED ON MAP

