


Beginning at a beech and fallen sugar tree, the north east corner to John Williams land in the east line of Holland & Hancys survey 3223 (here I marked 3 beeches, thence with said line $S 1^{\circ} N$ crossing a spring branch at 32 poles a drain at 42 poles, 164 poles to a beech sugar tree and fallen ash; thence $S 69^{\circ} W$ 83 poles to a beech lym and fallen sugar tree, north east corner to William Green's land

Thence with Green's line $S 69^{\circ} E$ crossing a drain 164 poles to a sugar tree and beech in the north line of Williams land and $S. W.$ corner to Green - thence $S 69^{\circ} E$ 83 poles to the beginning containing 85 acres part of Hancys said survey

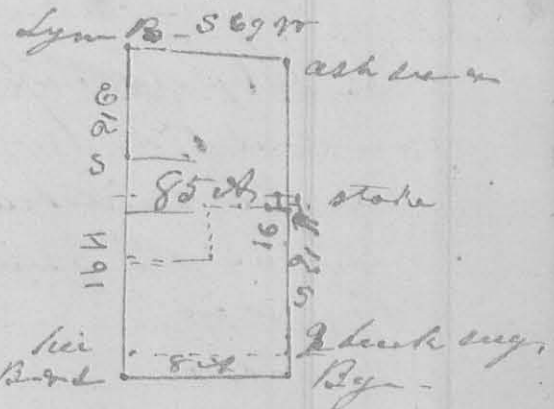

- I made the following

division (to wit) beginning at 2 beeches and sugar tree north of the east named ^{or beginning} corner $7 \frac{3}{4}$ poles; thence $S 69^{\circ} W$ 83 poles to a hickory, sugar tree, and water beech in the west line of this survey - thence with said line $S 21^{\circ} E$ $7 \frac{3}{4}$ poles to a sugar tree and beech $S. W.$ corner to the survey; thence $S 69^{\circ} E$ 83 poles to the beginning 8 acres

Thence beginning at the 2 beeches and sugar tree aforesaid in the east line; thence with said line $S 21^{\circ} W$ $7 \frac{3}{4}$ poles to a stake; thence $S 69^{\circ} W$ 42 $\frac{1}{2}$ poles to a stake; thence $S 21^{\circ} E$ 36 poles to a stake; thence $S 69^{\circ} W$ 41 poles to a small mulberry tree in the east line of Green's land, - leaving 5 acres in the north end of this survey - 10 102

David Warner }
 Samuel Warner } *66* J. W. Marnon
66 *66*

Beginning at 2 beeches, westerly corner to Philip Langton's Survey, no 3164, and $S. W.$ corner to Lemelling Jones' Survey, no 4655