

Road. 132
Perry Twp.


No Road Record found.
Status Placed sta. 1-3-9-11 etc.

V.M.S. 5209

1488

INDEXED ON MAP

July-28-1933
Clear
Wright 51
Jimm Montgomery

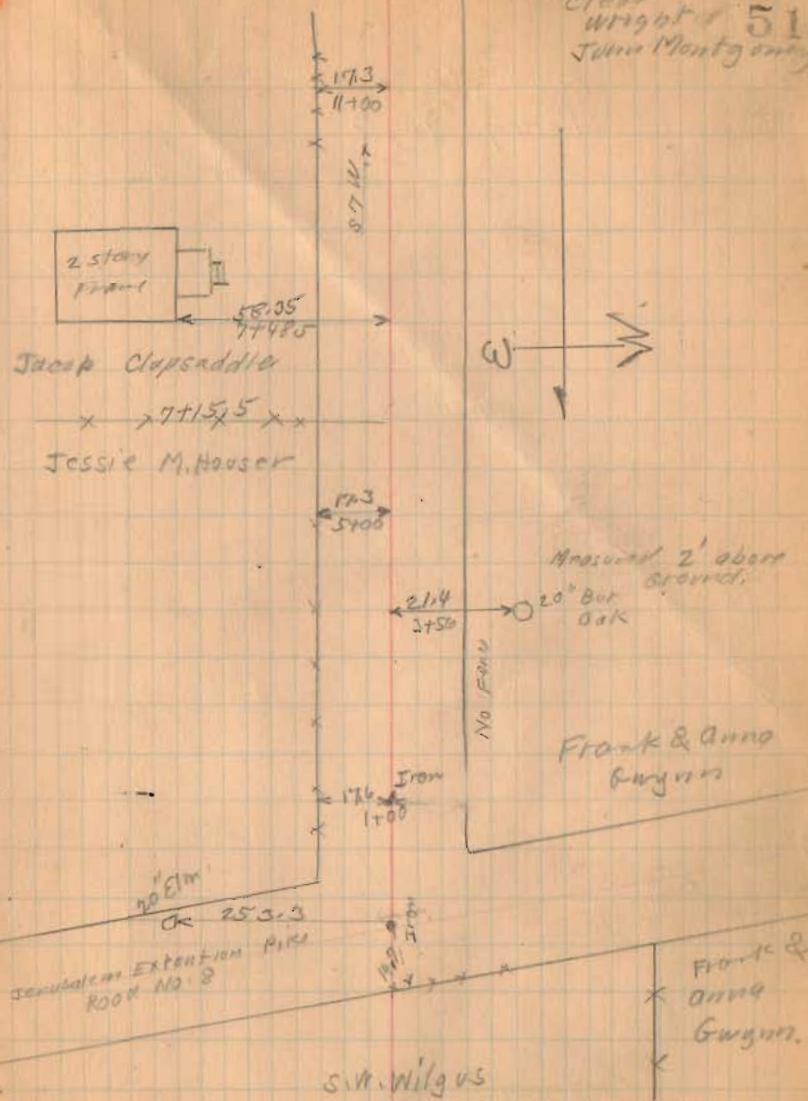

Road 132
Perry Twp.

Wth J. Clapsadd W.

Farob Clapsadd E

7-28-33

52

