


26
8571

Survey
No 544

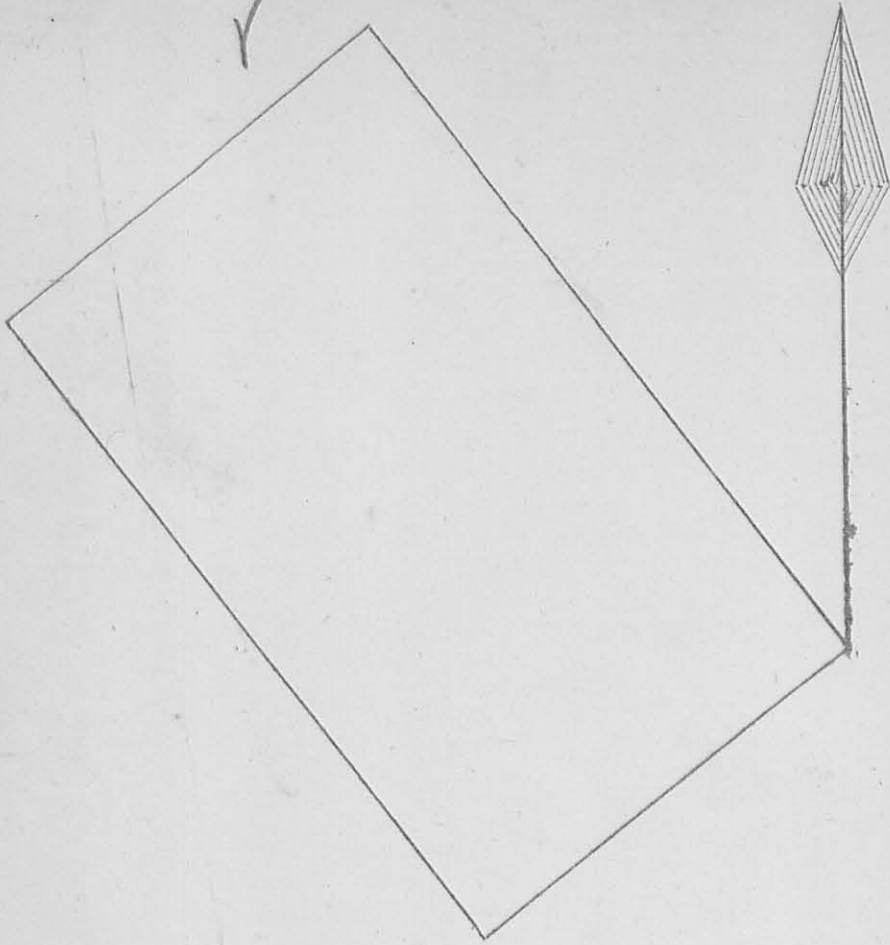

Surveyed August 19th 1845, one hundred acres of land for John Lo Bellville, Assignee of Walter Slicer, Said Slicer being the Assignee of Wm Penn Clark, who presented to me a certificate from George Krouse, Auditor of Logan Co, Dated December, 11th, 1843, Certifying that 100 Acres of land in Perry township is forfeited to the State of Ohio for the non payment of taxes and sold to W P Clark, in the name of Michael Murphy, being part of Survey No 5275, Acres 100, Value \$186 Years Due 1821 to 1843, Amt of taxes \$10.75

I proceeded to ascertain the tract of land described in the Auditors Certificate & Order; Beginning at 2 Sugs & a Buck, corner to Benjamin Rosars land & Run N 53 E 98 poles to 3 Small Water Buck & Stone, then S 37 26 E 163 poles to 2 Black Ash & Small Bur Oak, Bur Oak N 23 1/2 W 4 links & Black Ash N 63 E 5 links from corner, then S 53 W 98 poles to a stone in Rolingers line,

Corner to Boisau's land, then N 37° 26' W 163
 poles to the Beginning containing 100 Acres
 Thos J. McAdin } Ch Cr A. H. Harrison
 Thos Marquis } " " C. S. L. Co. O

Survey
 No 3315

(8220)

Surveyed August 20th 1845 for John Brunson the
 following tract of land being part of Military Survey
 No 3312, in the name of George McCredie in the
 County of Logan, Ohio, & on the waters of Mill
 Creek & bounded as follows; Beginning at a ~~stone~~
 Stone in the line in the line of said survey, corner
 to M Williams land & run N 80° 20' E, 37.9 poles
 to a ~~stone~~ stone, then S 9° 40' E 2 1/4 poles to a
 stone beech & white oak then S 80° 20' W 37.4
 poles to 2 beech in the line of Birds land
 then N 9° 30' W 2 1/4 poles to the beginning
 containing 50 1/2 acres

A. H. Harrison
 C. S. L. Co. O

<