
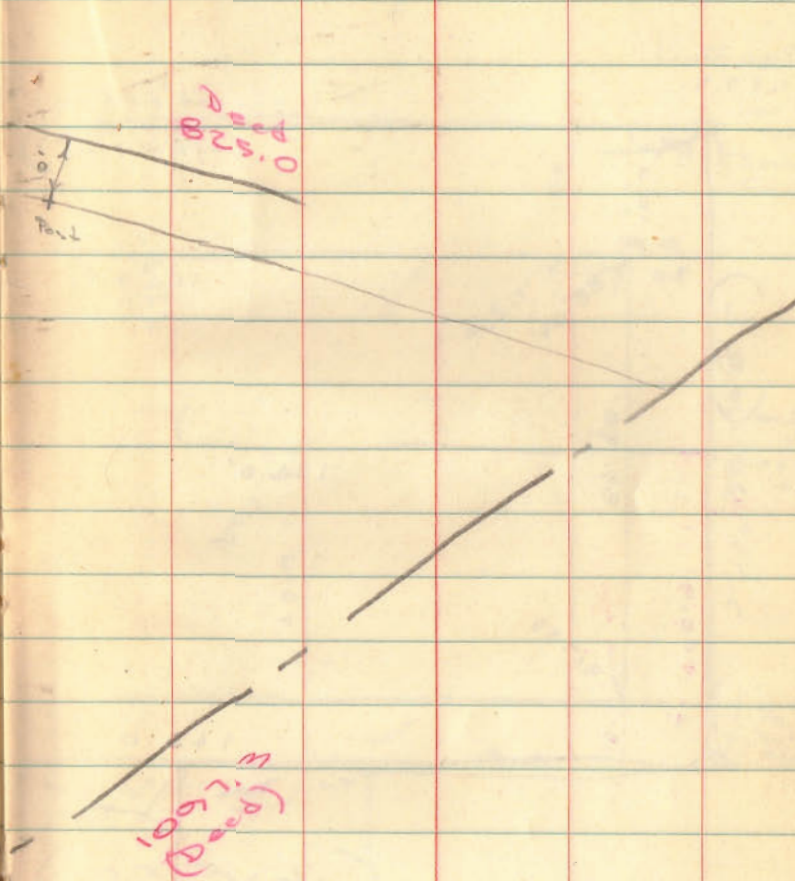


May 10, 1957

Adson
Geologic

Boiley
East Liberty

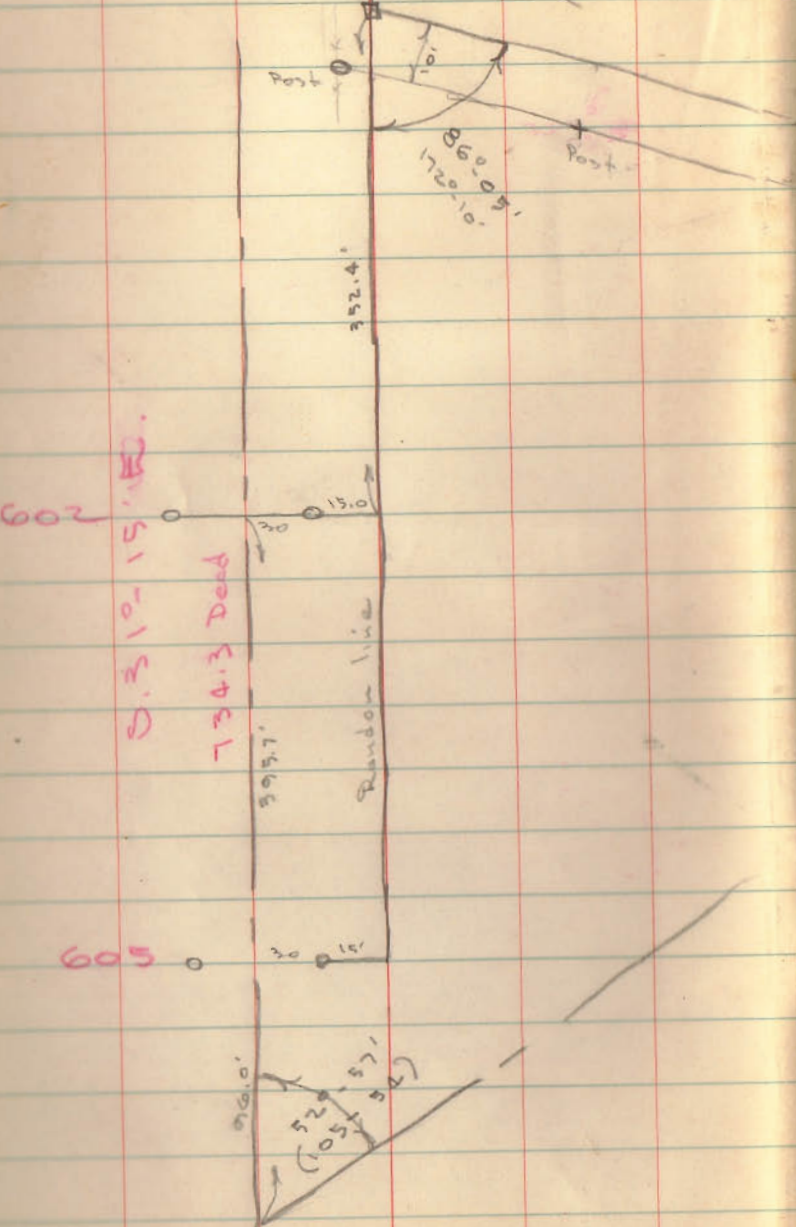

INDEXED ON MAP
9616

PA...
...