


Huber Cemetery  
for Trustees.

PLEASANT TWP  
SEC 31 T3 R14

July 7th 1923

W.A.M. } send plat. to F.H.  
E.P. Miller } Marc R.R. H.I. Bell  
F.B. Culp }

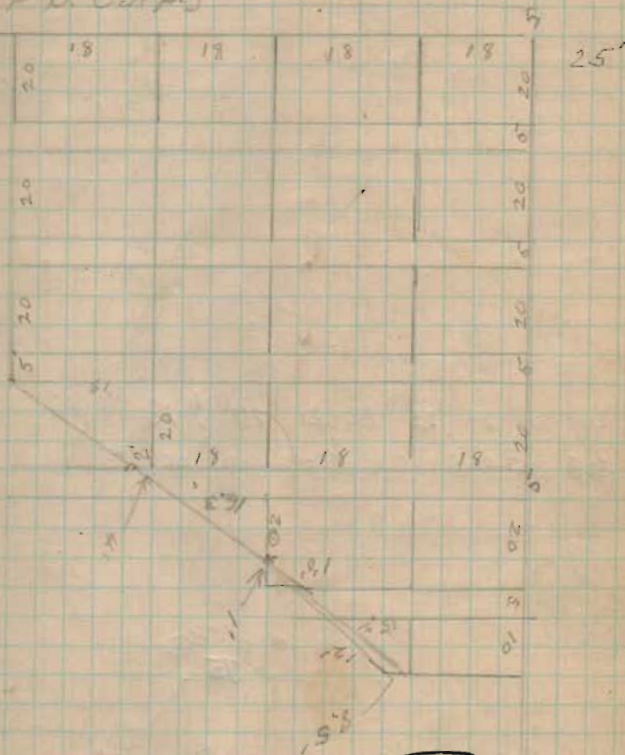

1097

INDEXED ON MAP