

Road # 35
Pleasant TP.

July 1 - 30
" " 2 - 30

J. S. Crane

1/2 1

A. M. Renick

1/2 1

Harold Taylor

1/2 1

Leonard Tamblyn

1/2 1

Ivan Wickersham

1/2 1

Lunches

1.50 250

1333
INDEXED ON MAR

27

20"
24+01 Cor. PIP 10 7

20+10-24 5.8 11 8



Lillie Brisco
x-x-16+62
Elmer Krauskopf

11+07 Drive

N 01° E

Elmer Krauskopf
R.W.M. 3 67 10 spike
STATE ROUTE

Grover Kreglow
Sta 0
47

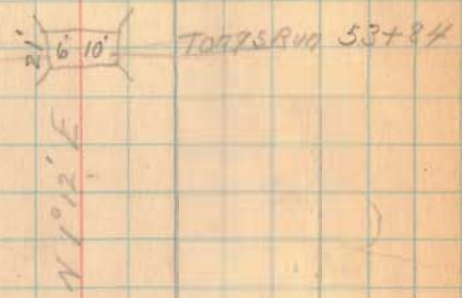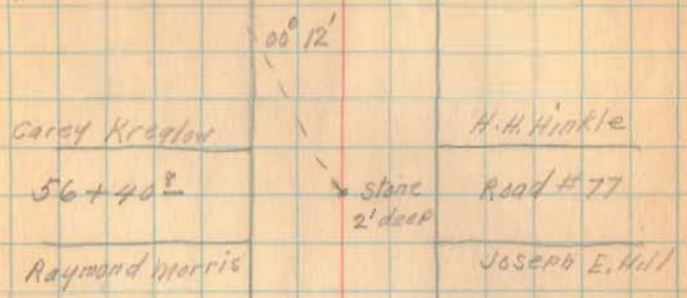

51+10 Drive

Sec. 3 < 20' x 20' > Sec. 2



1337

INDEXED

See Book Page 575 55

18" deep 2 1/2 m. 85

82+95

Stone

Road #78

Carey Kreglow ← 26' x 26' → H. H. Hinkle

H. H. Hinkle	x
66785	
Clara Leasure	

Clara Leasure	x
62770	
H. H. Hinkle	

1323
INDEXED ON MAP