



Road 24

154+00

151+00


146+43

1733

INDEXED ON MAP

8-6-36

18

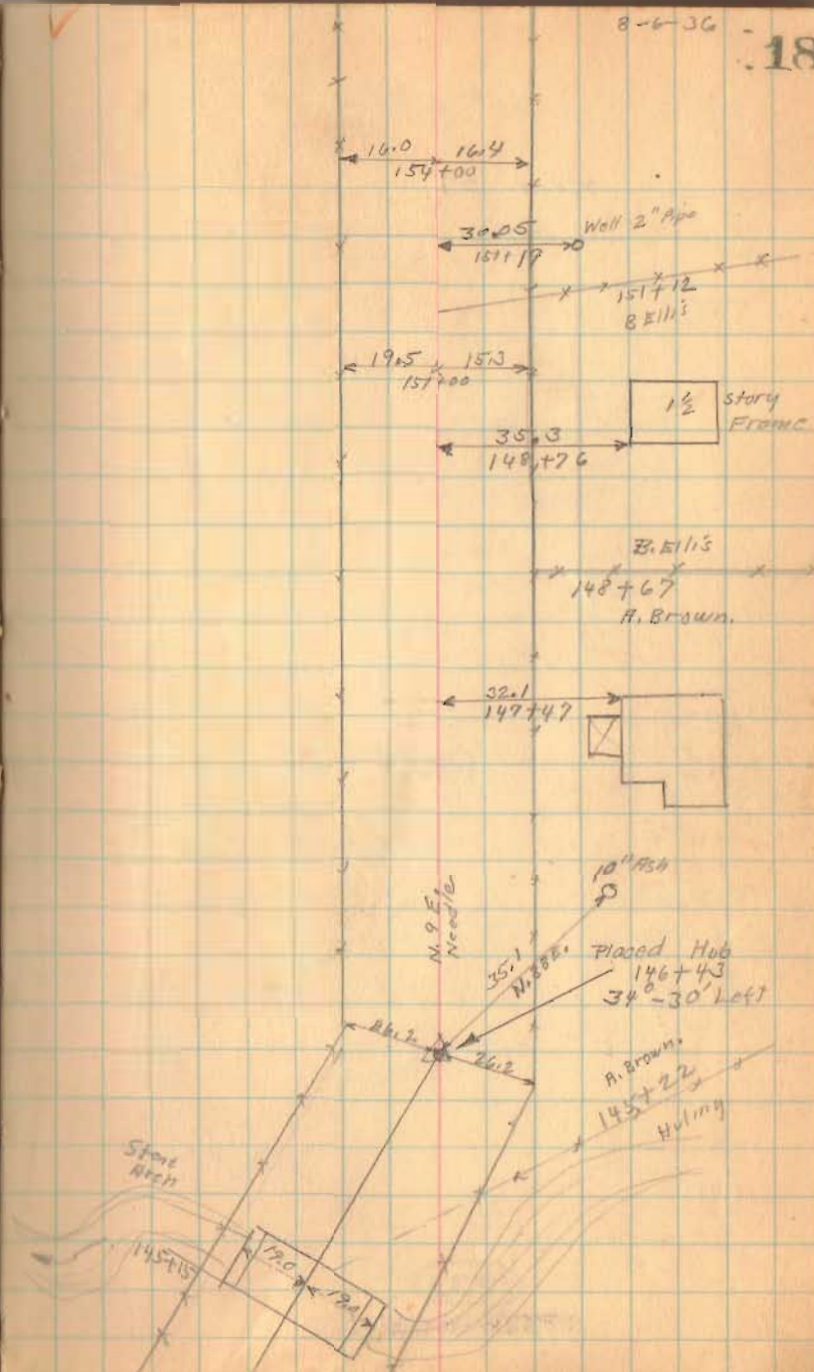

Road 24

170+00

163+25

159+00

1733

INDEXED ON MAP

Loggers


S. Rust

L. Martin

Ellis

8-6-36

19

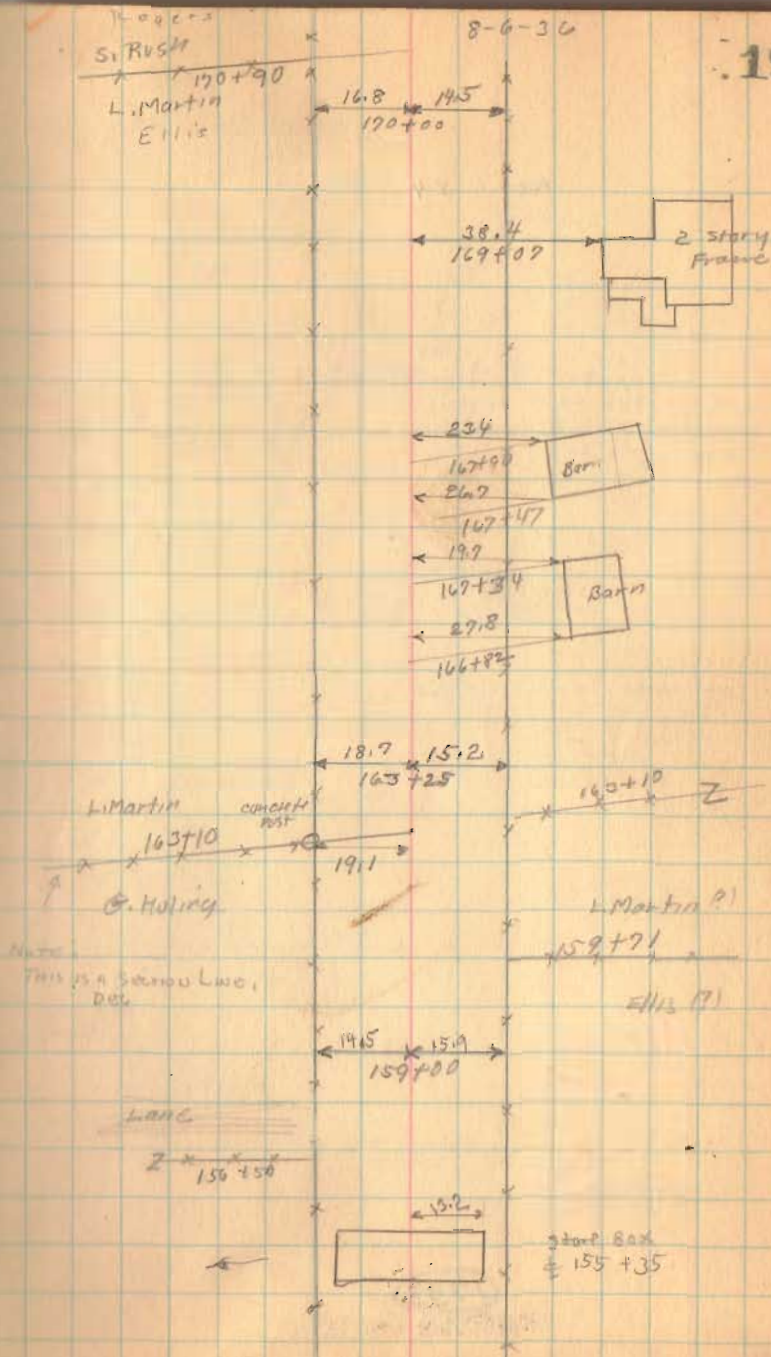

Road. 24

195+03  
181+75  
13728

190+90  
181+75  
9+15

2  
13 x

138 1,100

1330 1,100 0.082  
10640  
362.0

1330 1,100 0.082  
10640

1300  
1000  
10.000


182+00

178+00

175+00

1733

INDEXED ON MAP

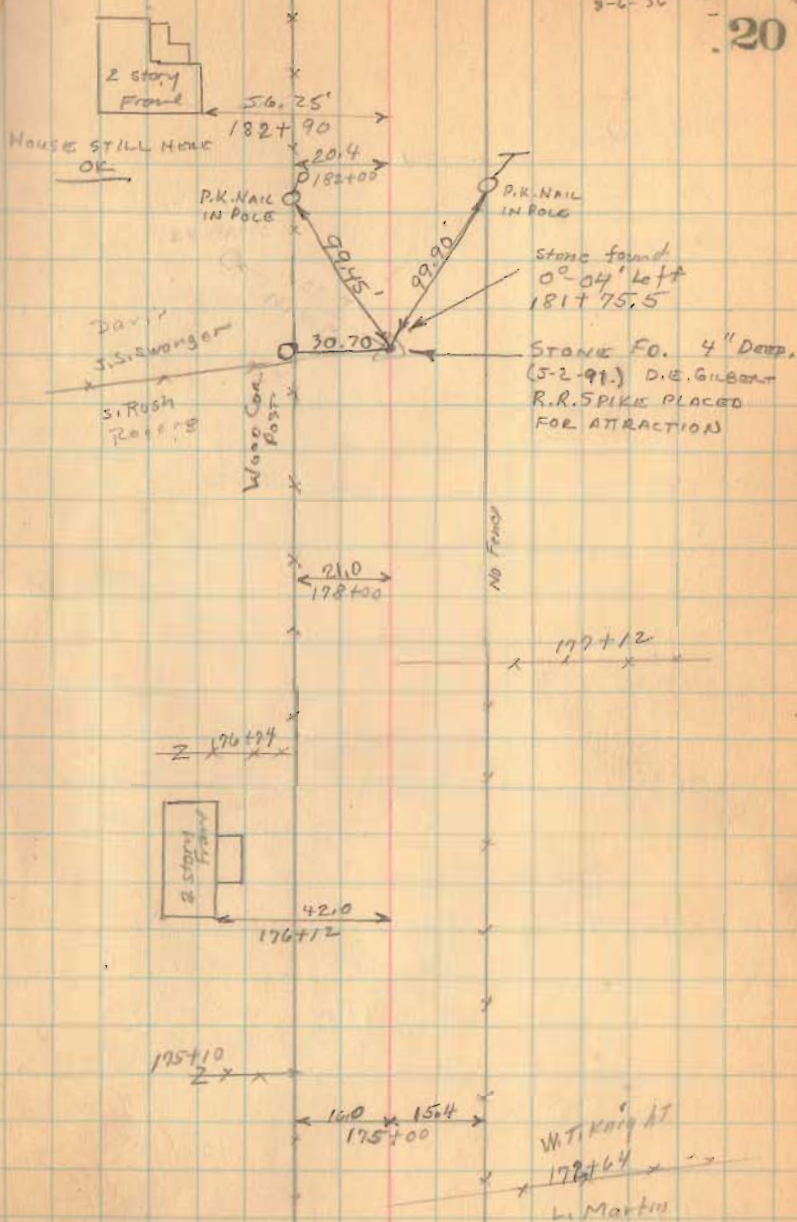

Road 24

199+06

196+00


192+00

187+00

1733

INDEXED ON MAP

21

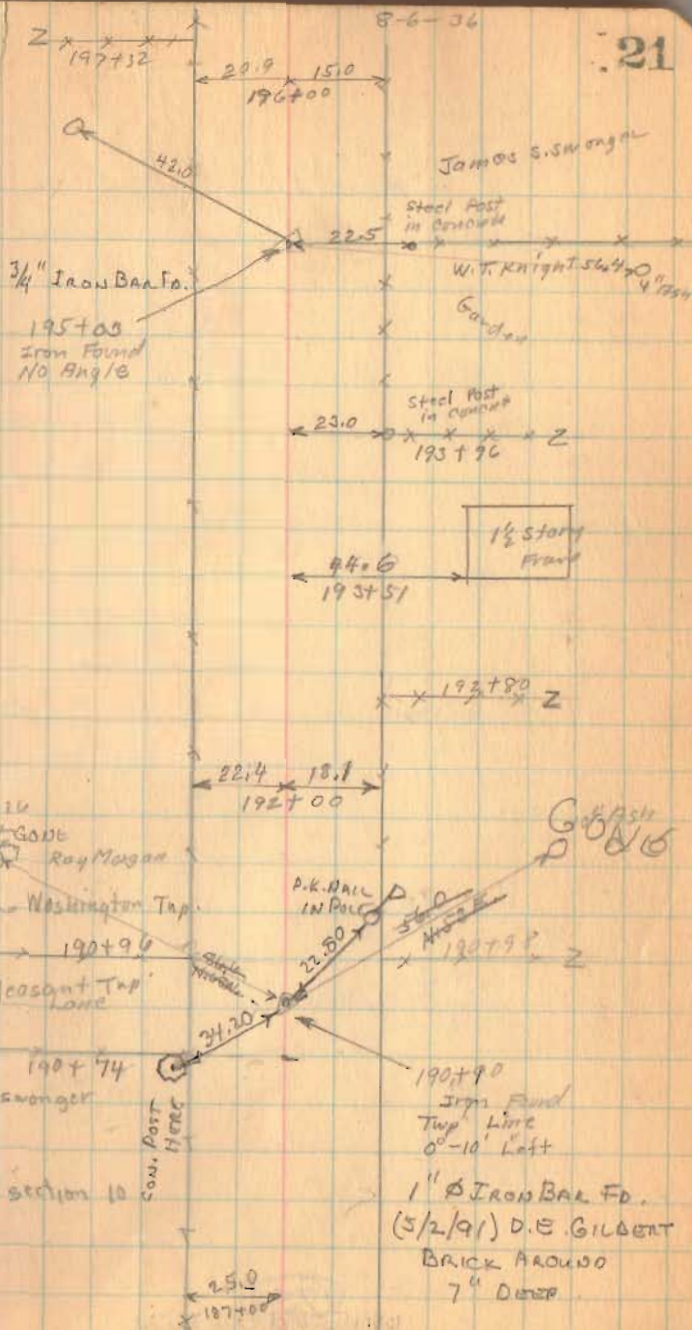



Road 24

223+00

218+00

229+39 P.I. Near Creek  
12+99 Sigs Record  
216+40




216+40

1733

INDEXED ON MAP

23

8-7-30

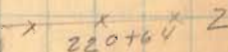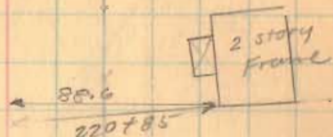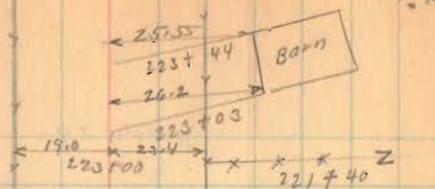


216+40  
Placed Iron  
3'-20' Ht

Found 5-8-1991 DEG  
1" Iron Bar - 3" Deep  
Δ = 3°-22' LT.  
114100 10"  
Oil.

220

Found 12/2/65 Bar  
Replaced w/ 1" # bar  
L.H.C.

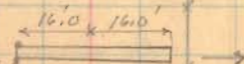

Road. 24

235+00


229+39

227+00

1733  
INDEXED ON MAP

8-7-36

24

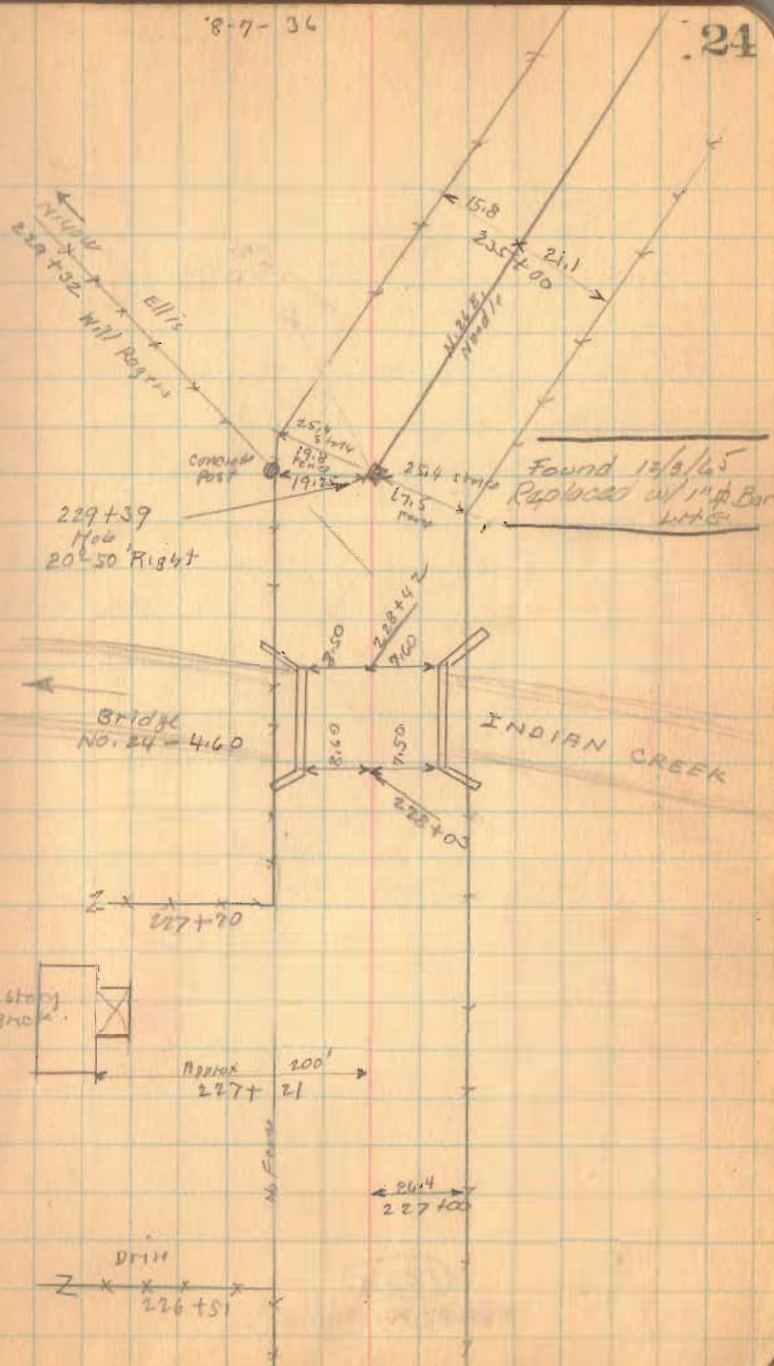



Road 24


239+00

237+46

Right Only

1733

INDEXED ON MAP

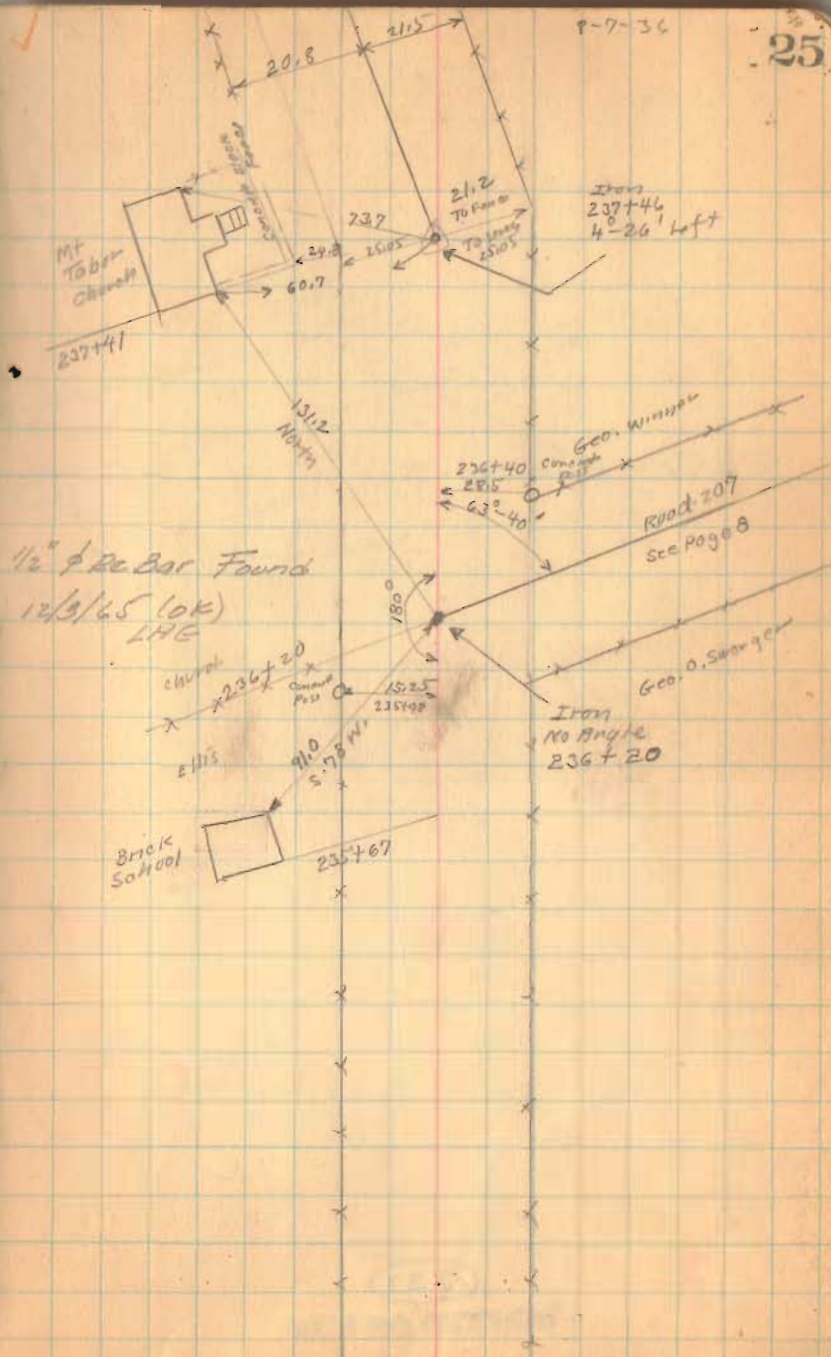

Road 24

245+62 Right Only


245+00

1733

INDEXED ON MAP

8-7-36

26

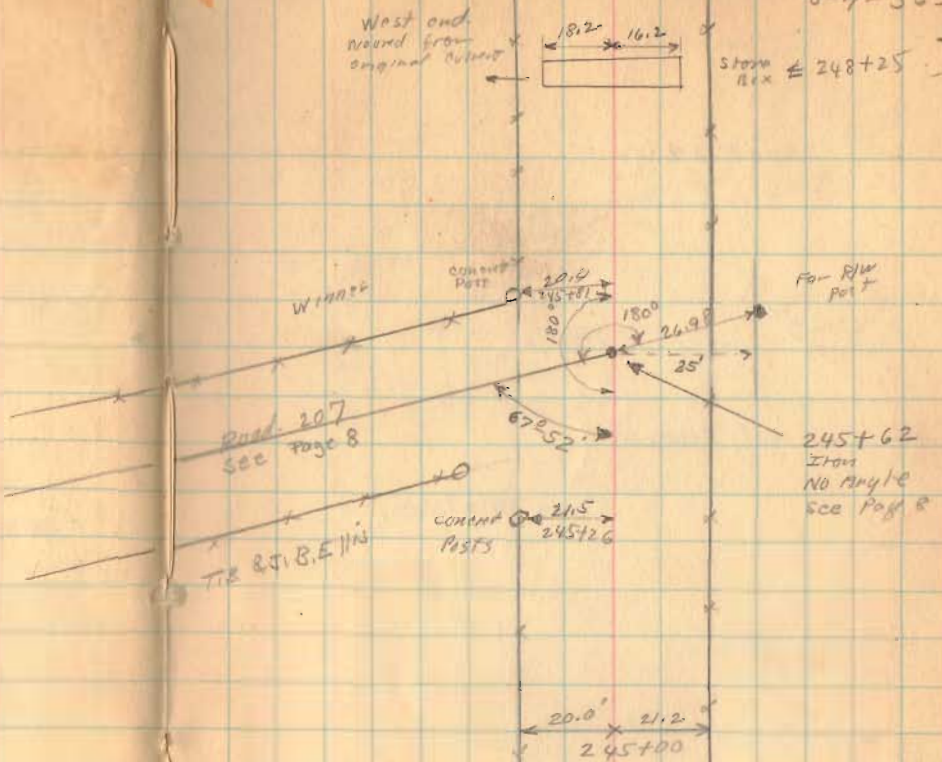

Road 24

260+00

90° Barksite


250+50

1733

INDEXED ON MAP

8-7-36

27

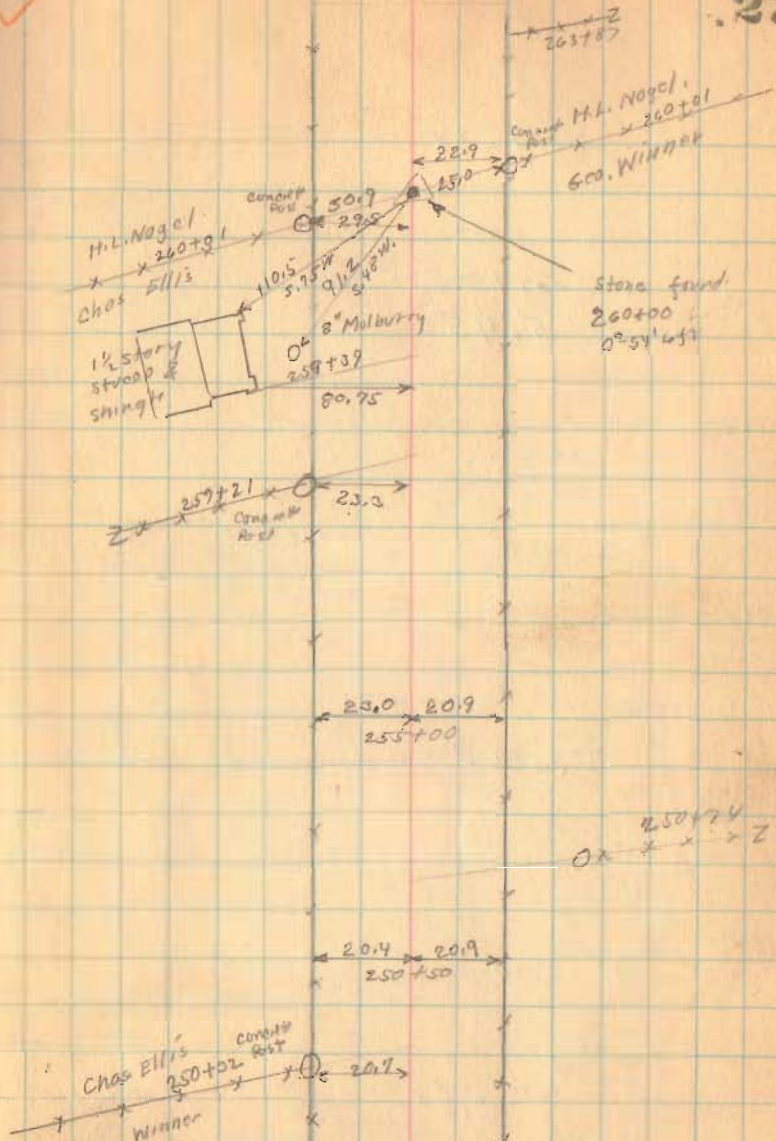

## Road. 24

Length 28752 Feet

Length 5.44545 Miles

Length 5.45 Miles

(287+00) (set. 90° with Transit.)

(280+00)

Hub 1970

(276+00)

(294+00) left only

294+26.5  
stone found  
62° 52' Right

Post

Sam'l Huber

Corner  
No. 10

18.7

Geo. B. Hudson

(266+00)

272+24 x

Lane

272+10

Geo. B. Hudson  
x 269+94


H.L. Nagel, 269+73.5

22.5 22.8

266+00

63.4

264+19.7

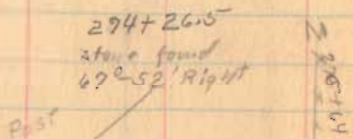All  
flatsStone  
Wall18.1  
18.1  
18.1

19.5

18.7

18.7

Section 12

Sam'l Huber

1260.7

1260.7

N. 82° E  
Needle

No Fence

L. F. Ames

Section 11

30'

30'

S.H. 27

Road 69

S.H. 27

Road 69

N.W. 1/4  
591+00  
Plan L-19  
Page 4

Page 4

Section 6

Many  
rocksCorner  
No. 1287+52  
Placed SpikesS.H. 27  
Road 69S.H. 27  
Road 69S.H. 27  
Road 69

1733

INDEXED ON MAP