

Boundary Monument




Stamped Nov 18th 1942 RMR

GC/inskeep  
F. Hurst  
R. McGarvey  
9-19-42

17

sec. 31-32-T3-R14  
Rd 43 - sec. 1-2-T2-R14  
Found two boulders with broken  
brick around  
Set concrete mon 6" below surface

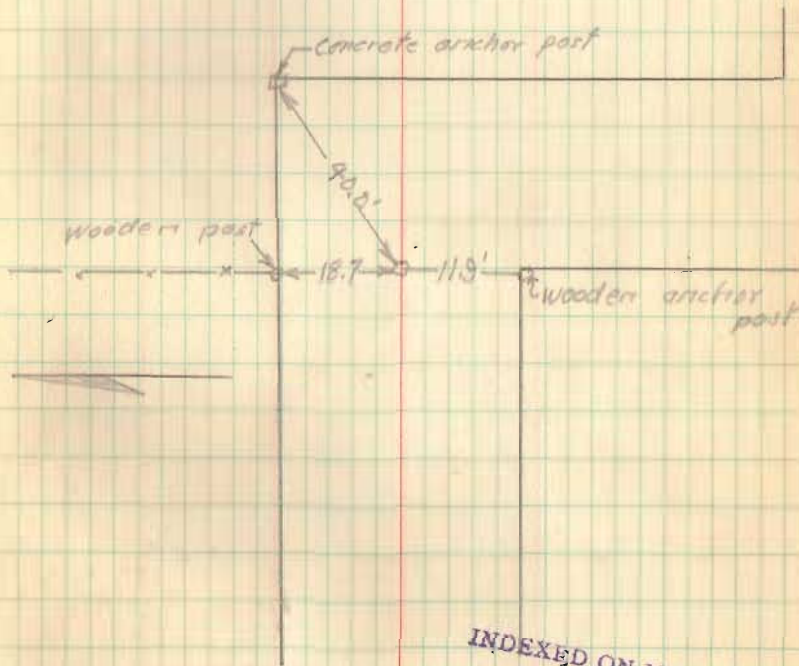

INDEXED ON MAP

2633 Pleasant  
Twp.

INDEXED ON MAP