

10-18-49
Dysert
Dickinson
R. Wilgus




See Book 575 page 39

Found stone on end with broken bricks and $1\frac{1}{2} \times 2 \times 29$ " wood stake under stone 2' deep.

Removed and placed Concrete Mon. 3×2 " Long.

Top 10" below road 33 marked as above

"Reason for Cutting Monument,"
 20 " to 24 " tile ditch 4' below surface of road under North Edge of Monument. Running E. by West

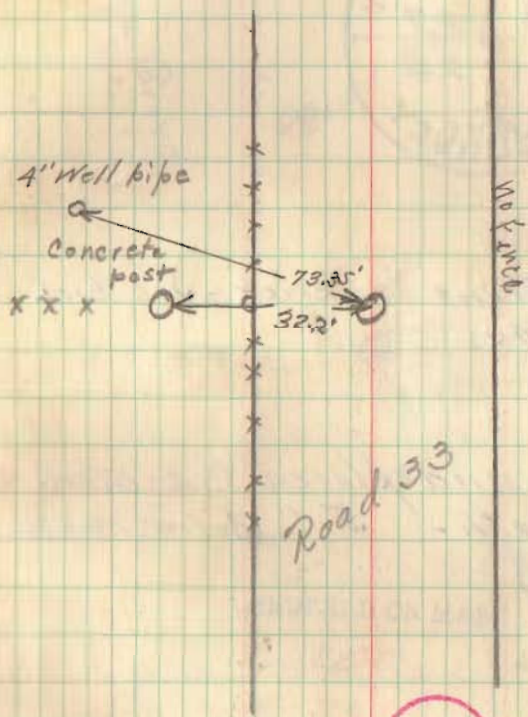

Pleasant Twp.

2658

Union Twp

✓